
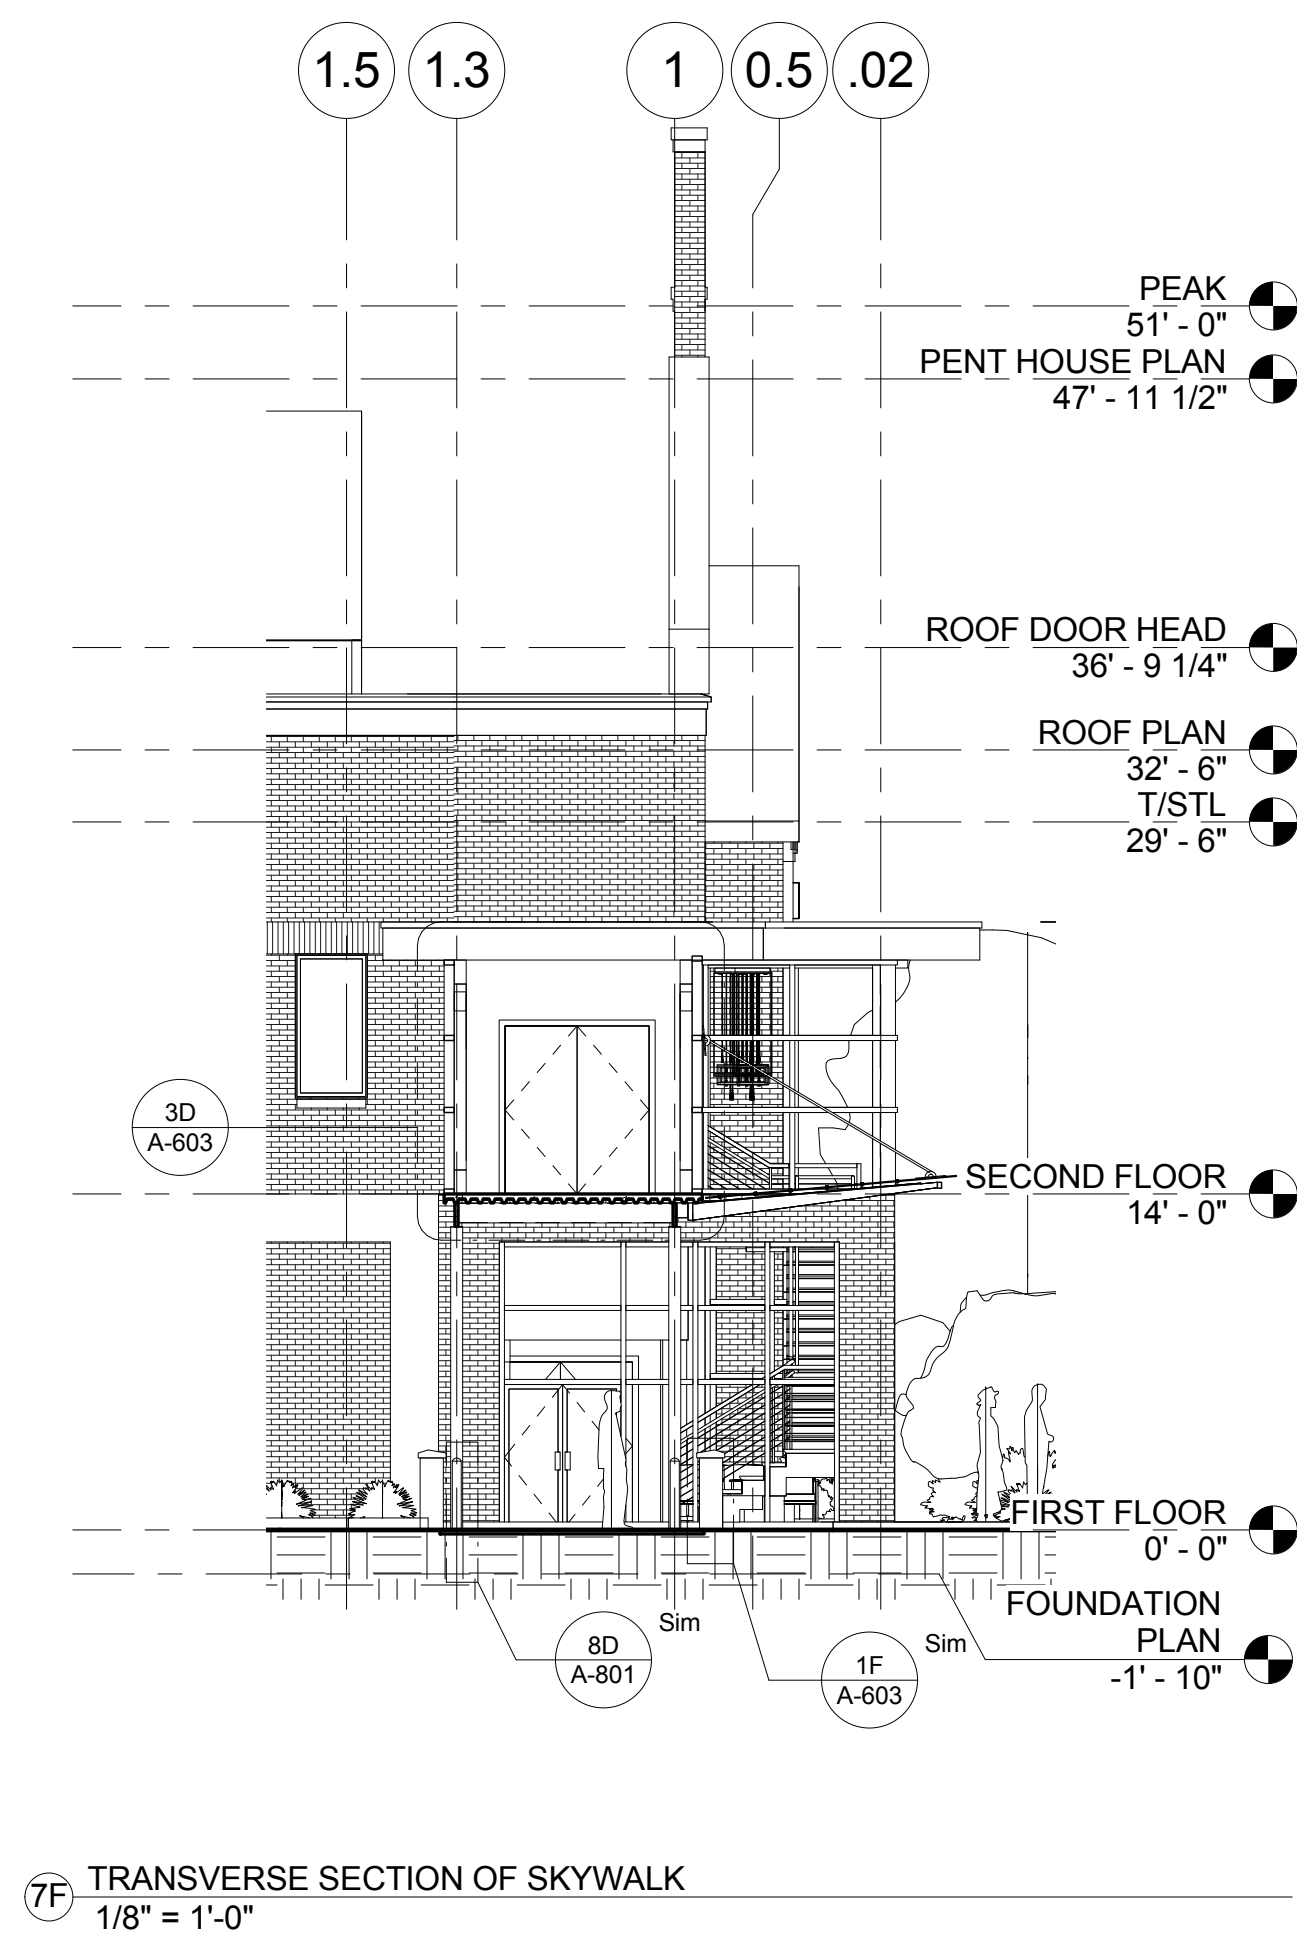
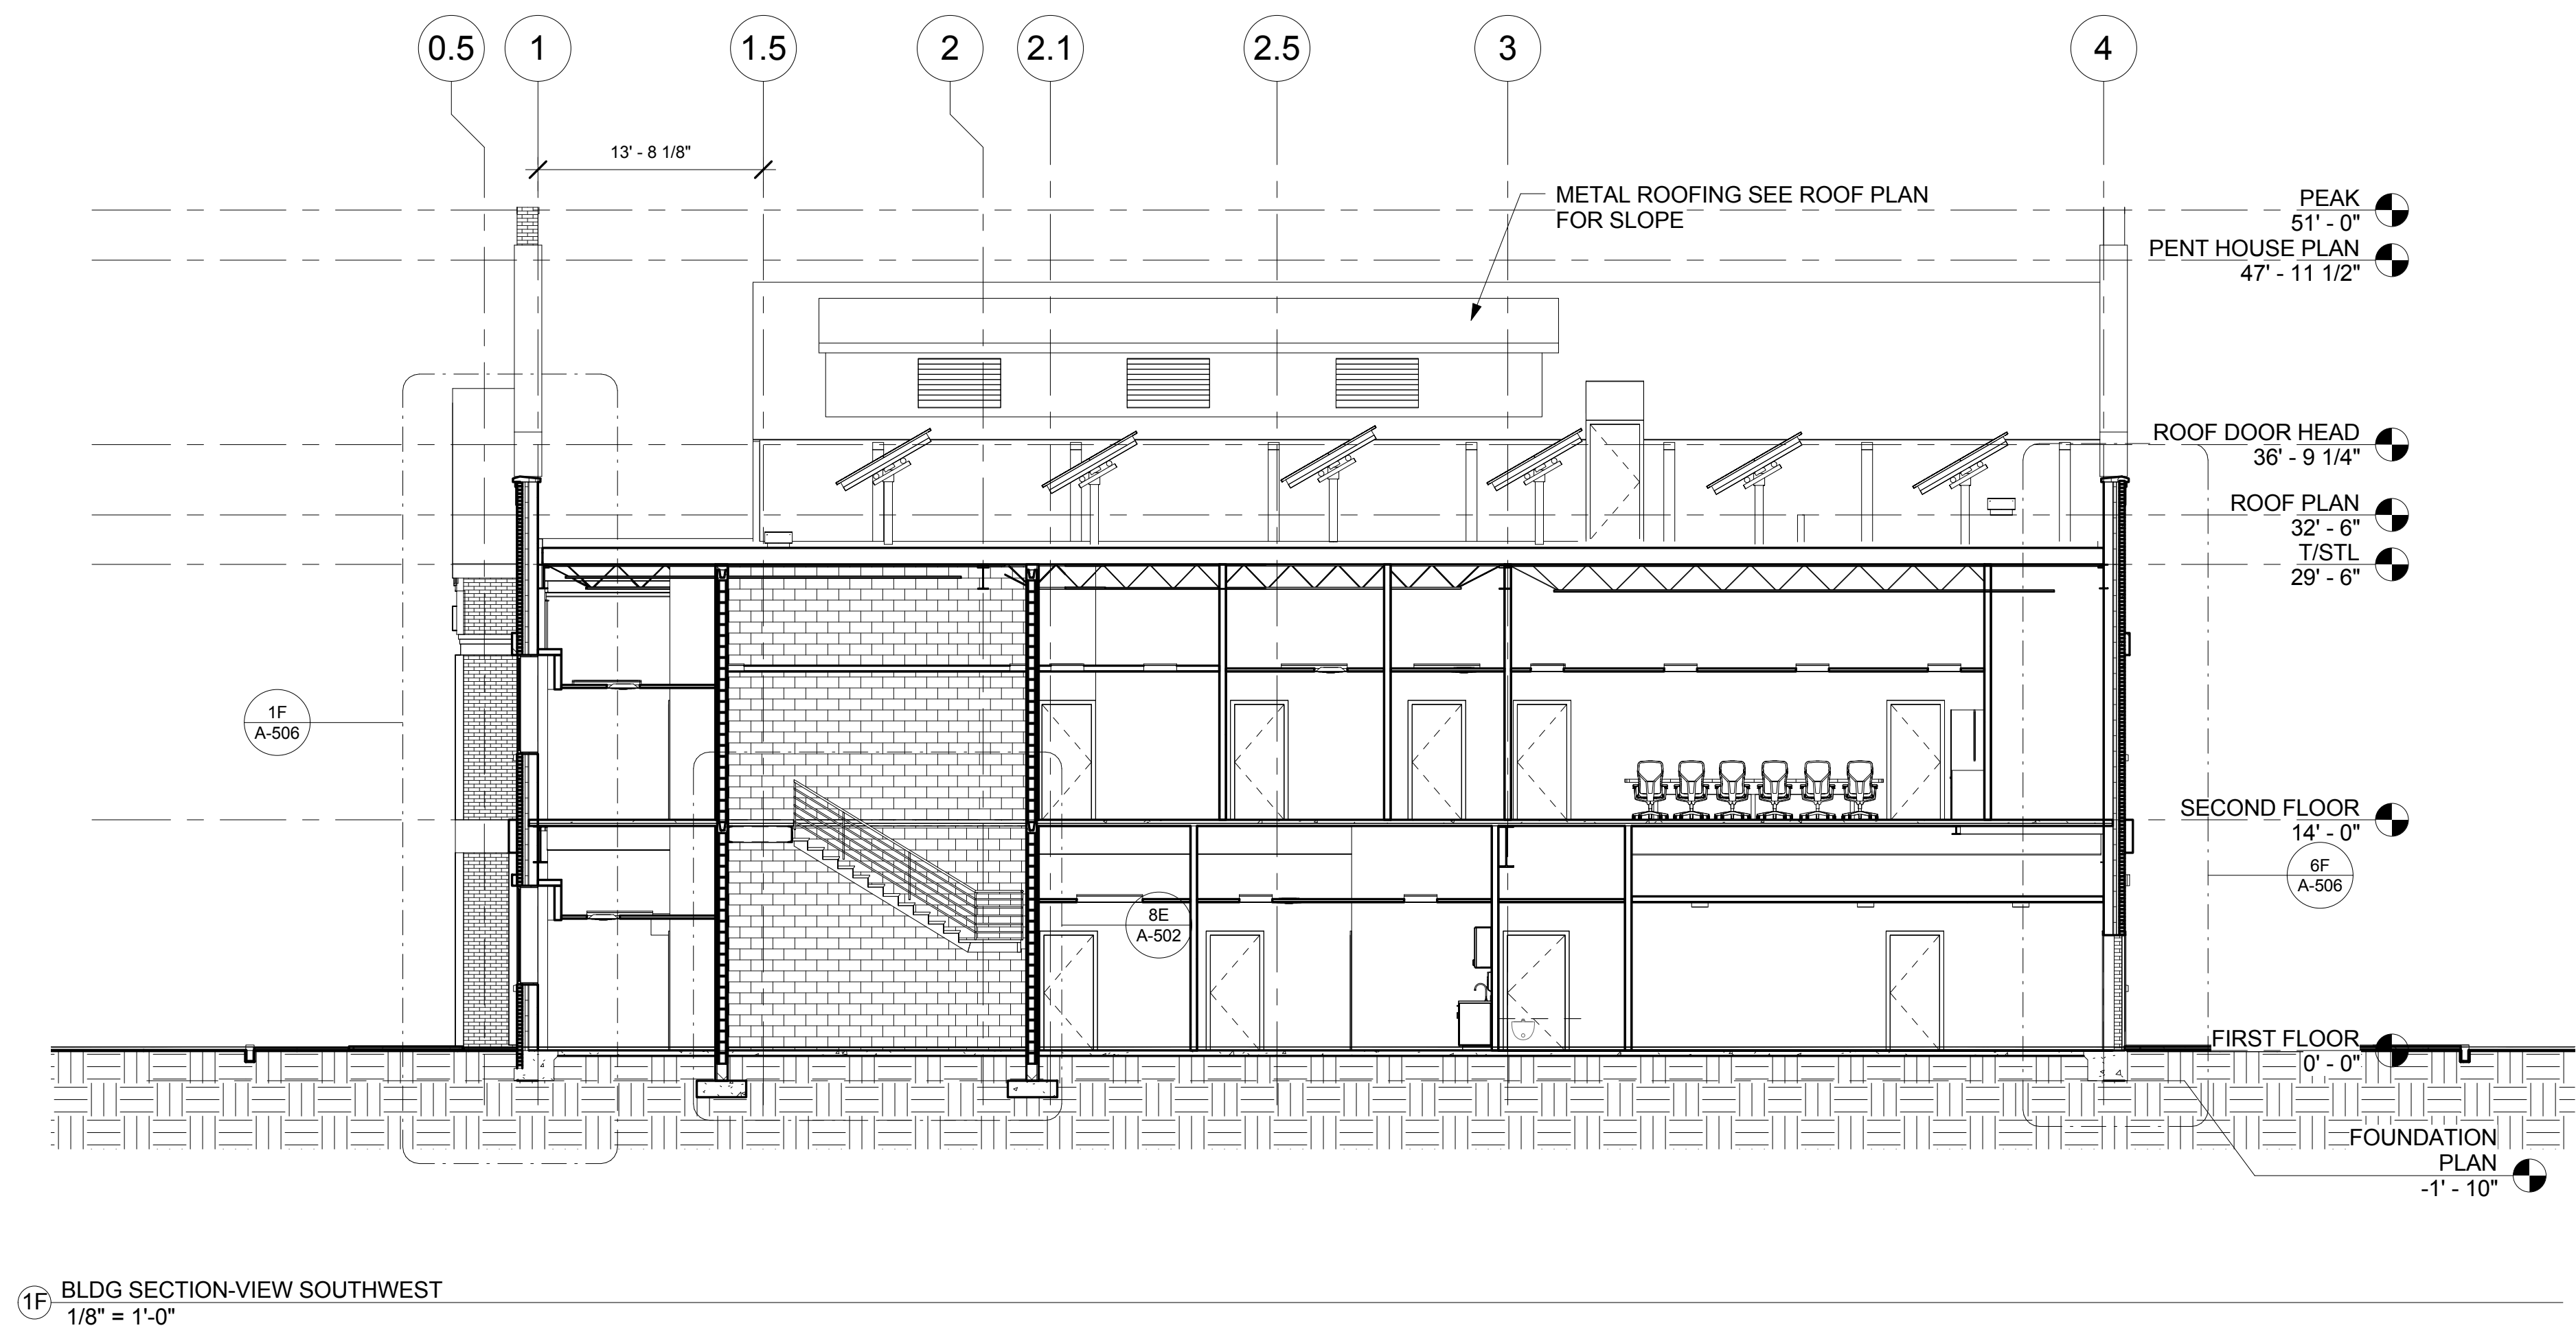
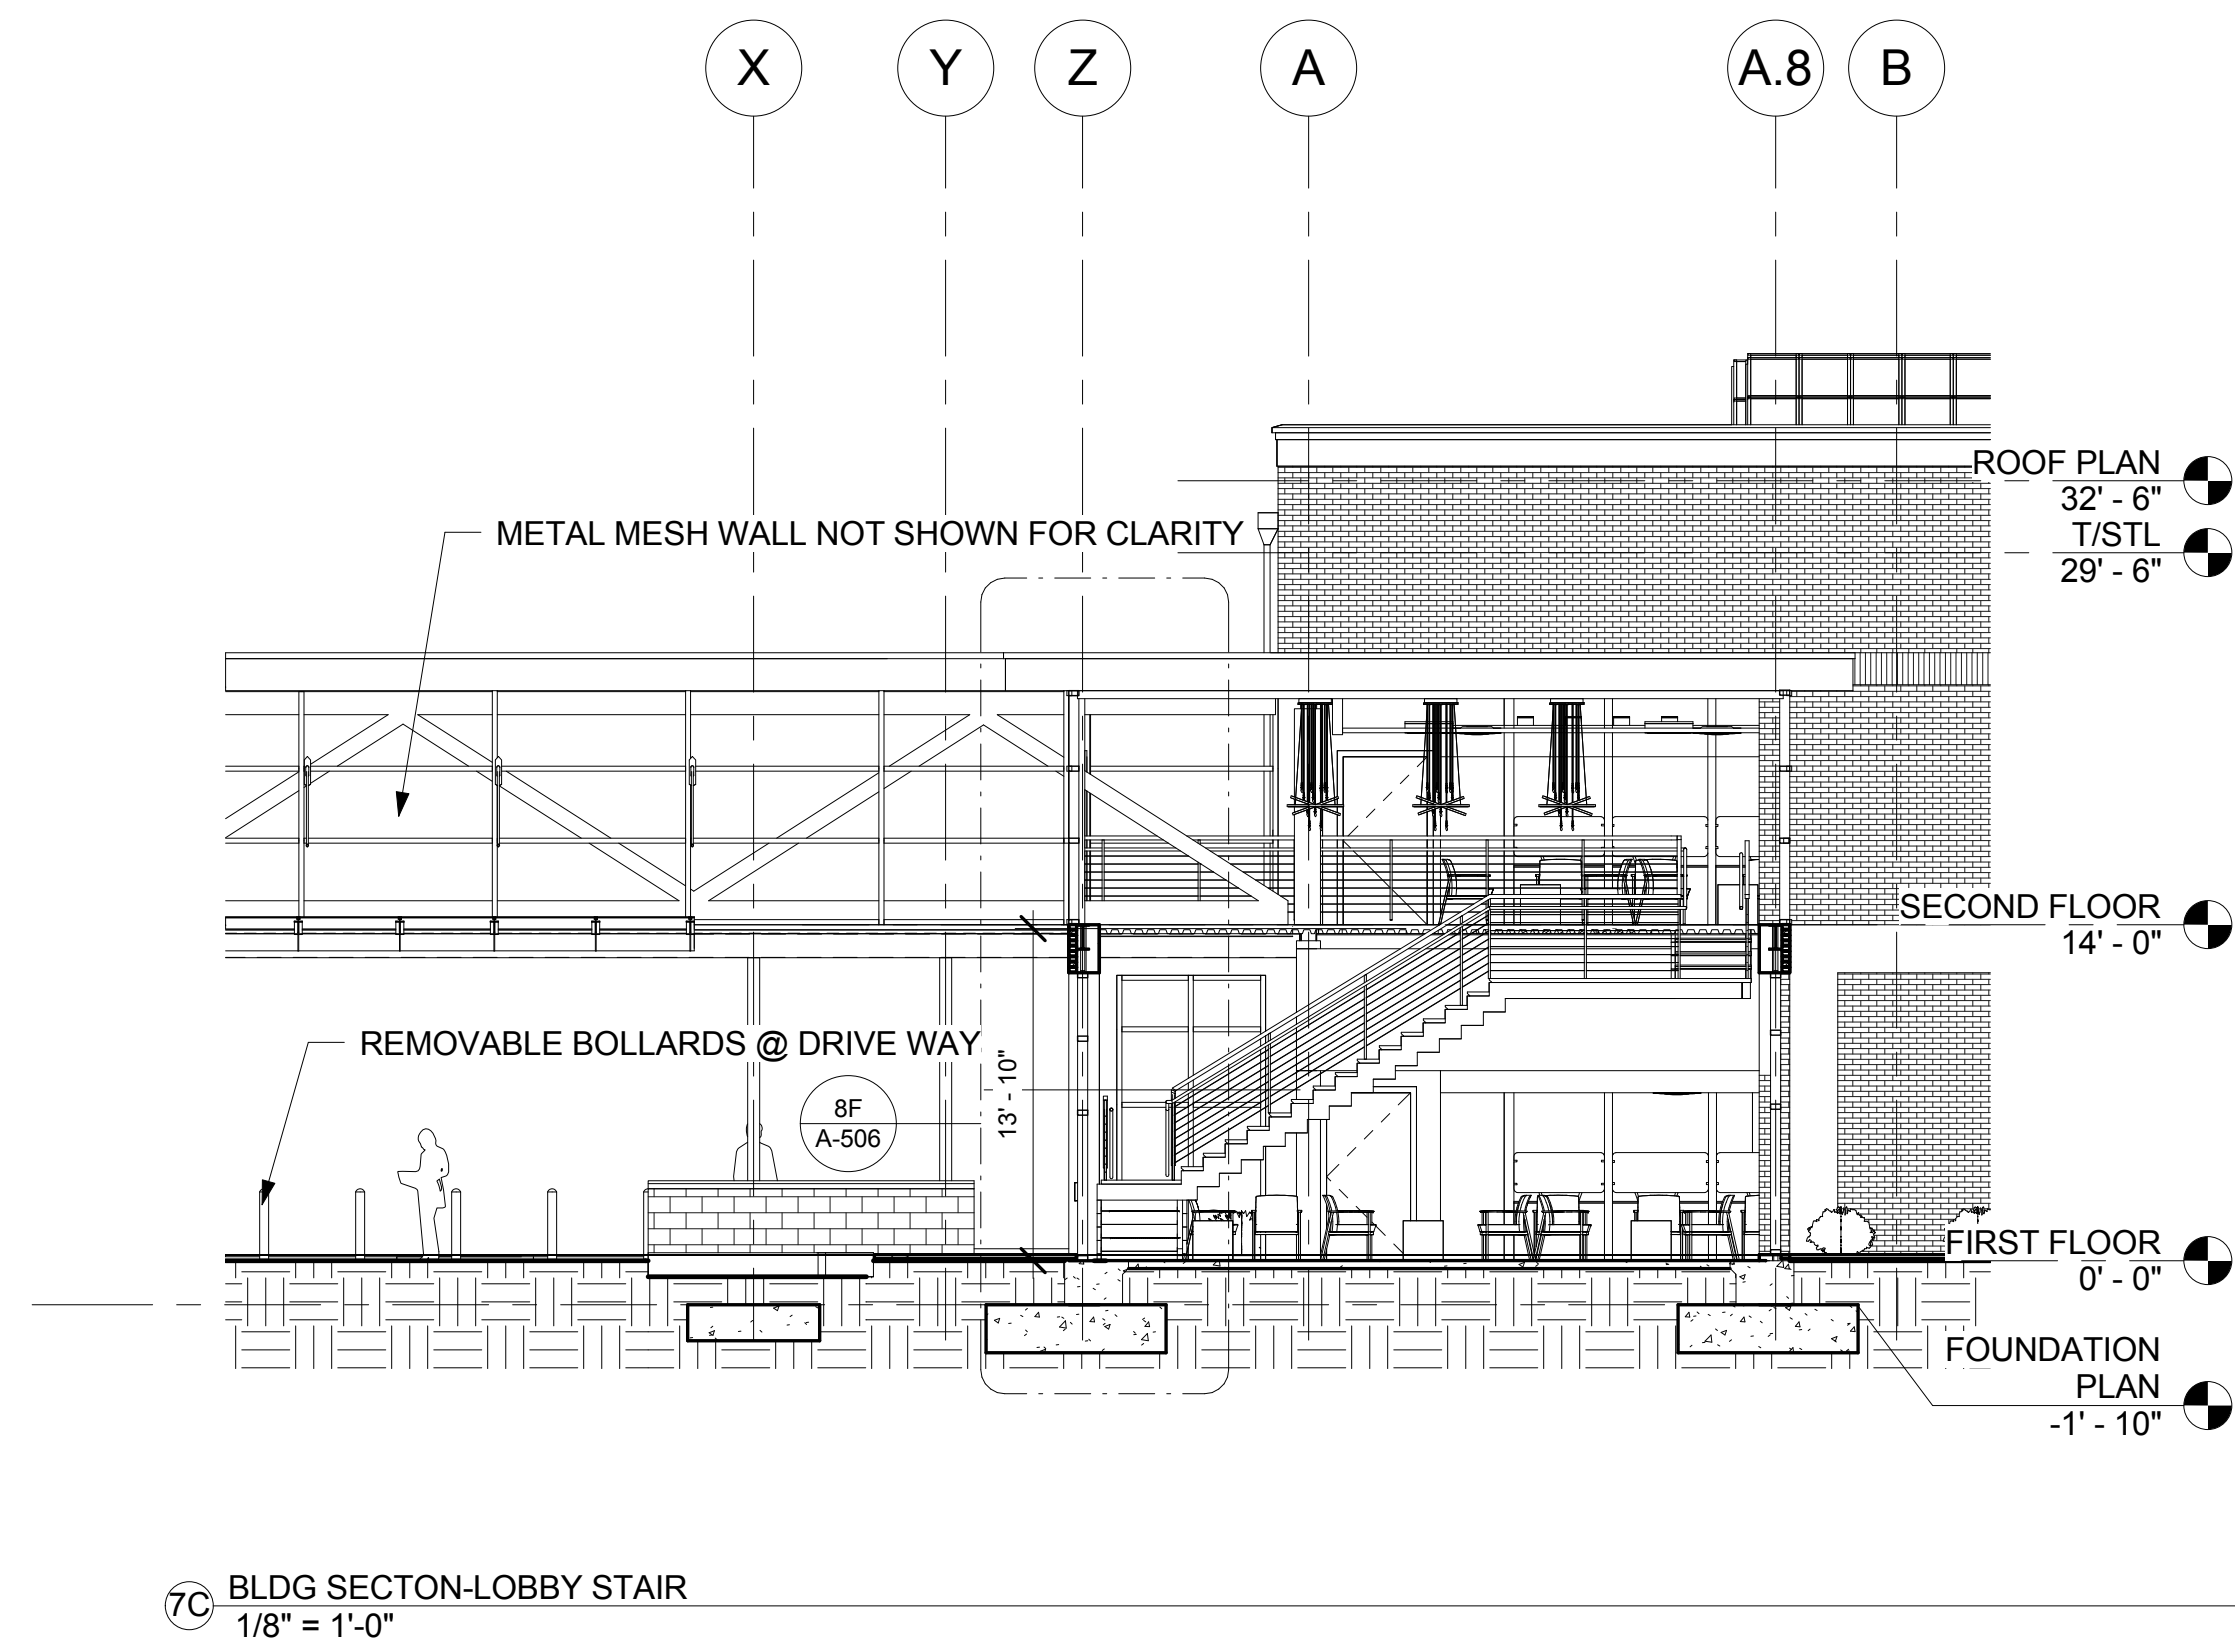


one thirty second inch = one foot
one sixteenth inch = one foot
one inch = one foot
three quarters inch = one foot
one half inch = one foot
three eighths inch = one foot
one eighth inch = one foot
one quarter inch = one foot

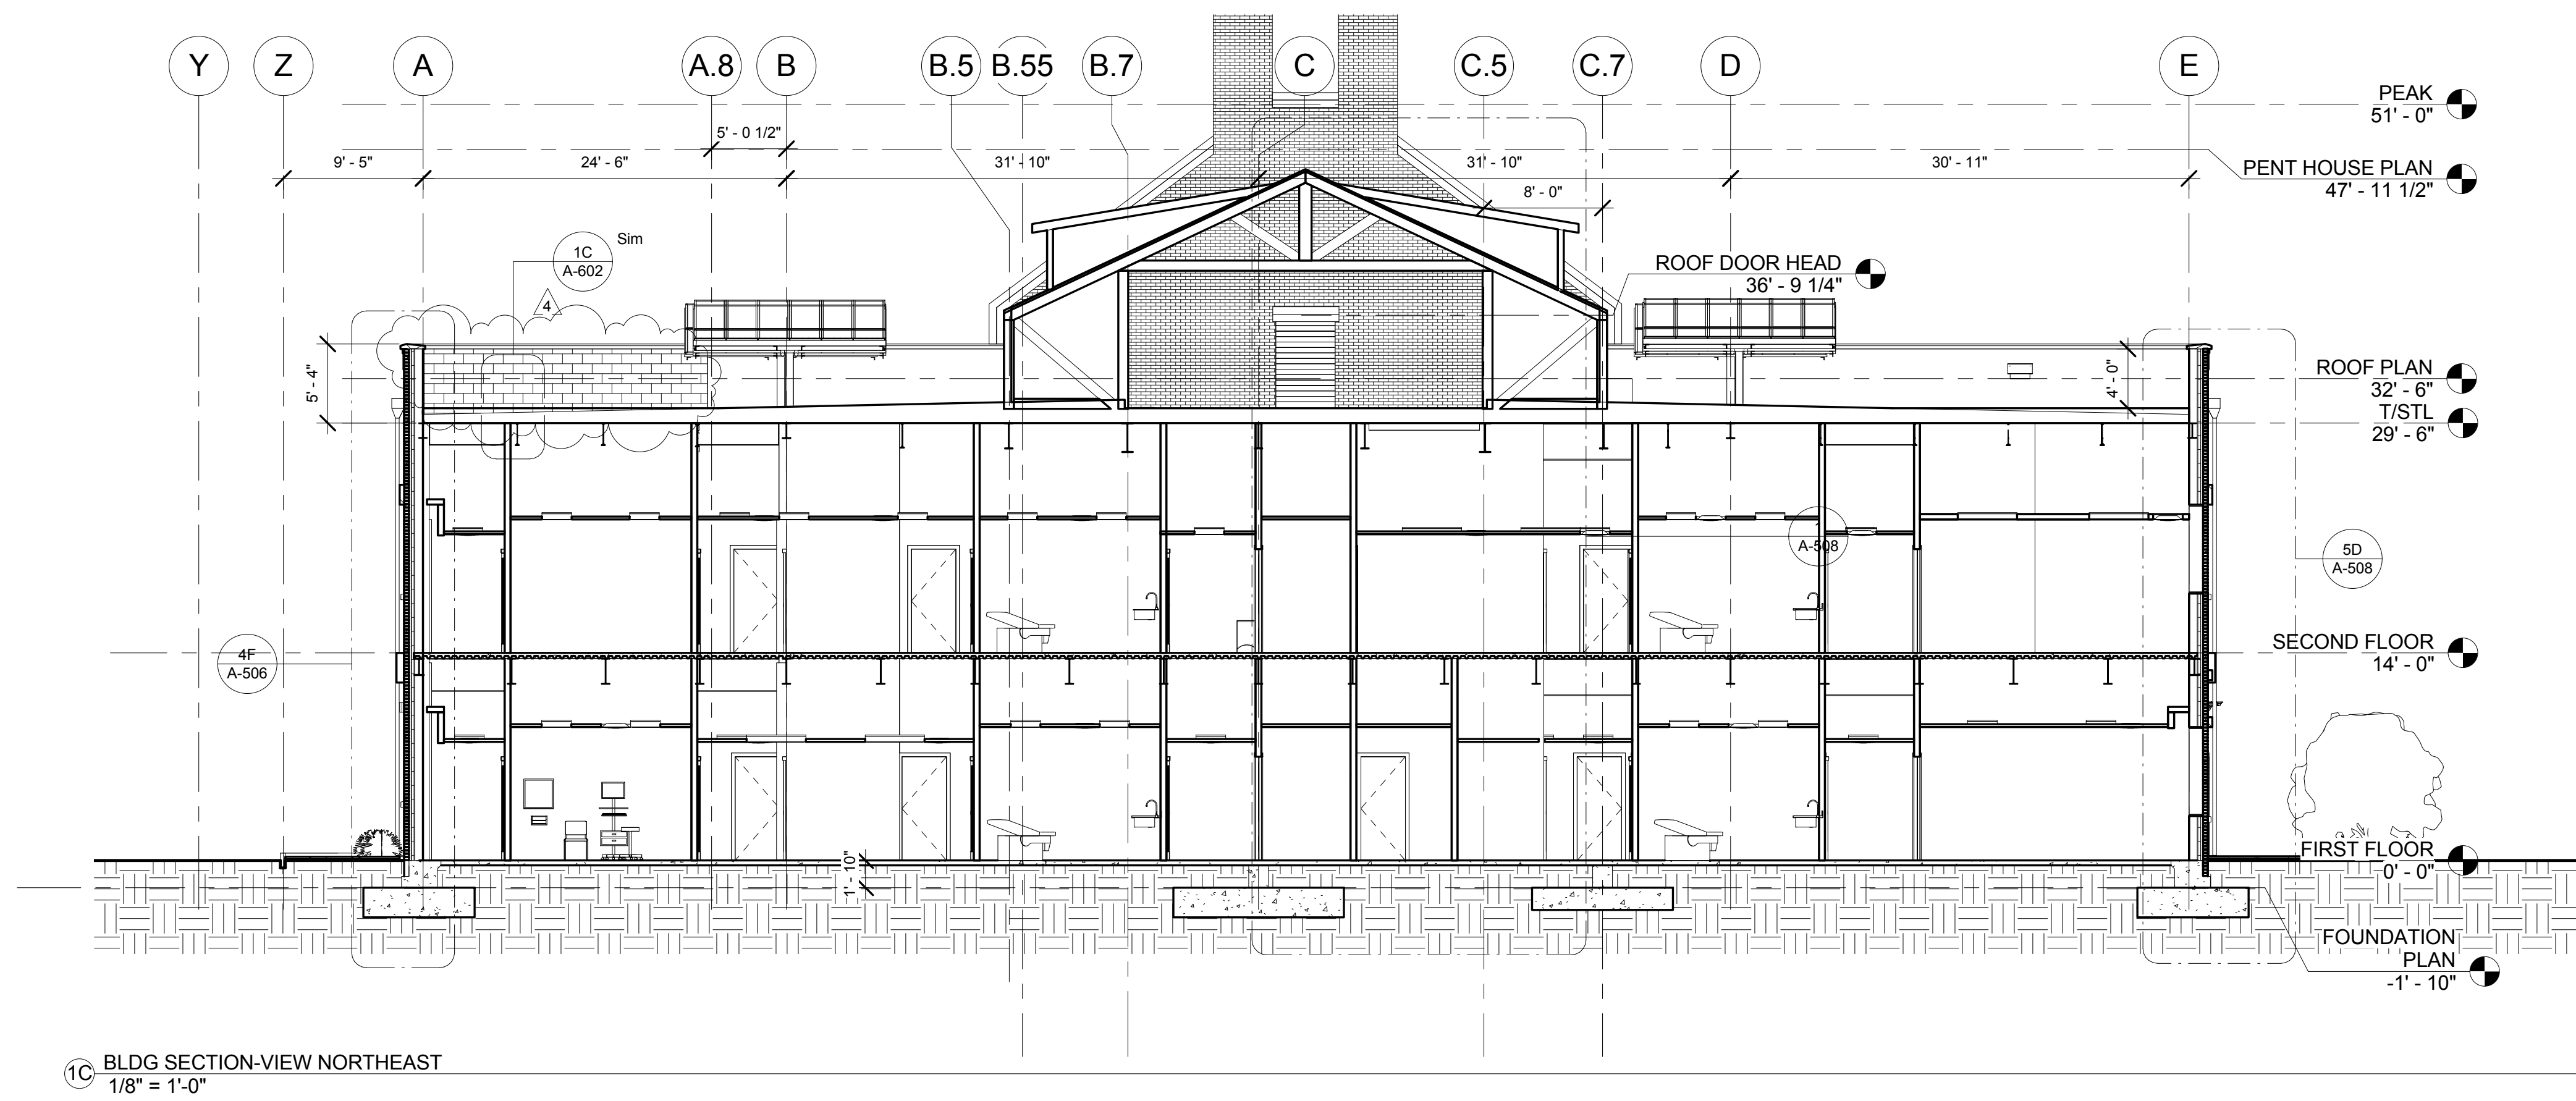

100% CONSTRUCTION DOCUMENTS

| | | | | | |
|--|--|--|---|--|--|
| <div>CONSULTANTS: ROWE PROFESSIONAL SERVICES COMPANY Engineering • Surveying • Aerial Photography / Mapping Landscape Architecture • Planning 511 Broadway Street, Myrtle Beach, SC 29577 Tel: 843.444.1020 www.rowepsc.com Fax: 843.444.3936</div> | <div> ARCHITECT/ENGINEERS: URS 1000 Abernathy Road NE, Suite 900 400 Northpark Tower Center Atlanta, Georgia 30328 Tel: 678.458.1800 aa+e 1101 Johnson Avenue, Suite 104 Myrtle Beach, SC 29577 843.712.1470 Accord Architects & Engineers</div> | <div>Drawing Title BUILDING SECTIONS - RENOVATION AND NOTES</div> <div>Approved: Project Director</div> | <div>Project Title DORN VAMC CLINIC ADDITION</div> <div>Location Columbia, South Carolina</div> <div>Date March 26, 2015</div> <div>Checked CC</div> <div>Drawn SS</div> | <div>Project Number 544-302</div> <div>Building Number 122</div> <div>Drawing Number A-501</div> | <div>Office of Facilities Management  Department of Veterans Affairs</div> |
|--|--|--|---|--|--|