


KEY NOTES:  
REFER TO WALL DETAILS ON  
SHEET A-901/ A-902 FOR WALL  
AND CEILING TYPES

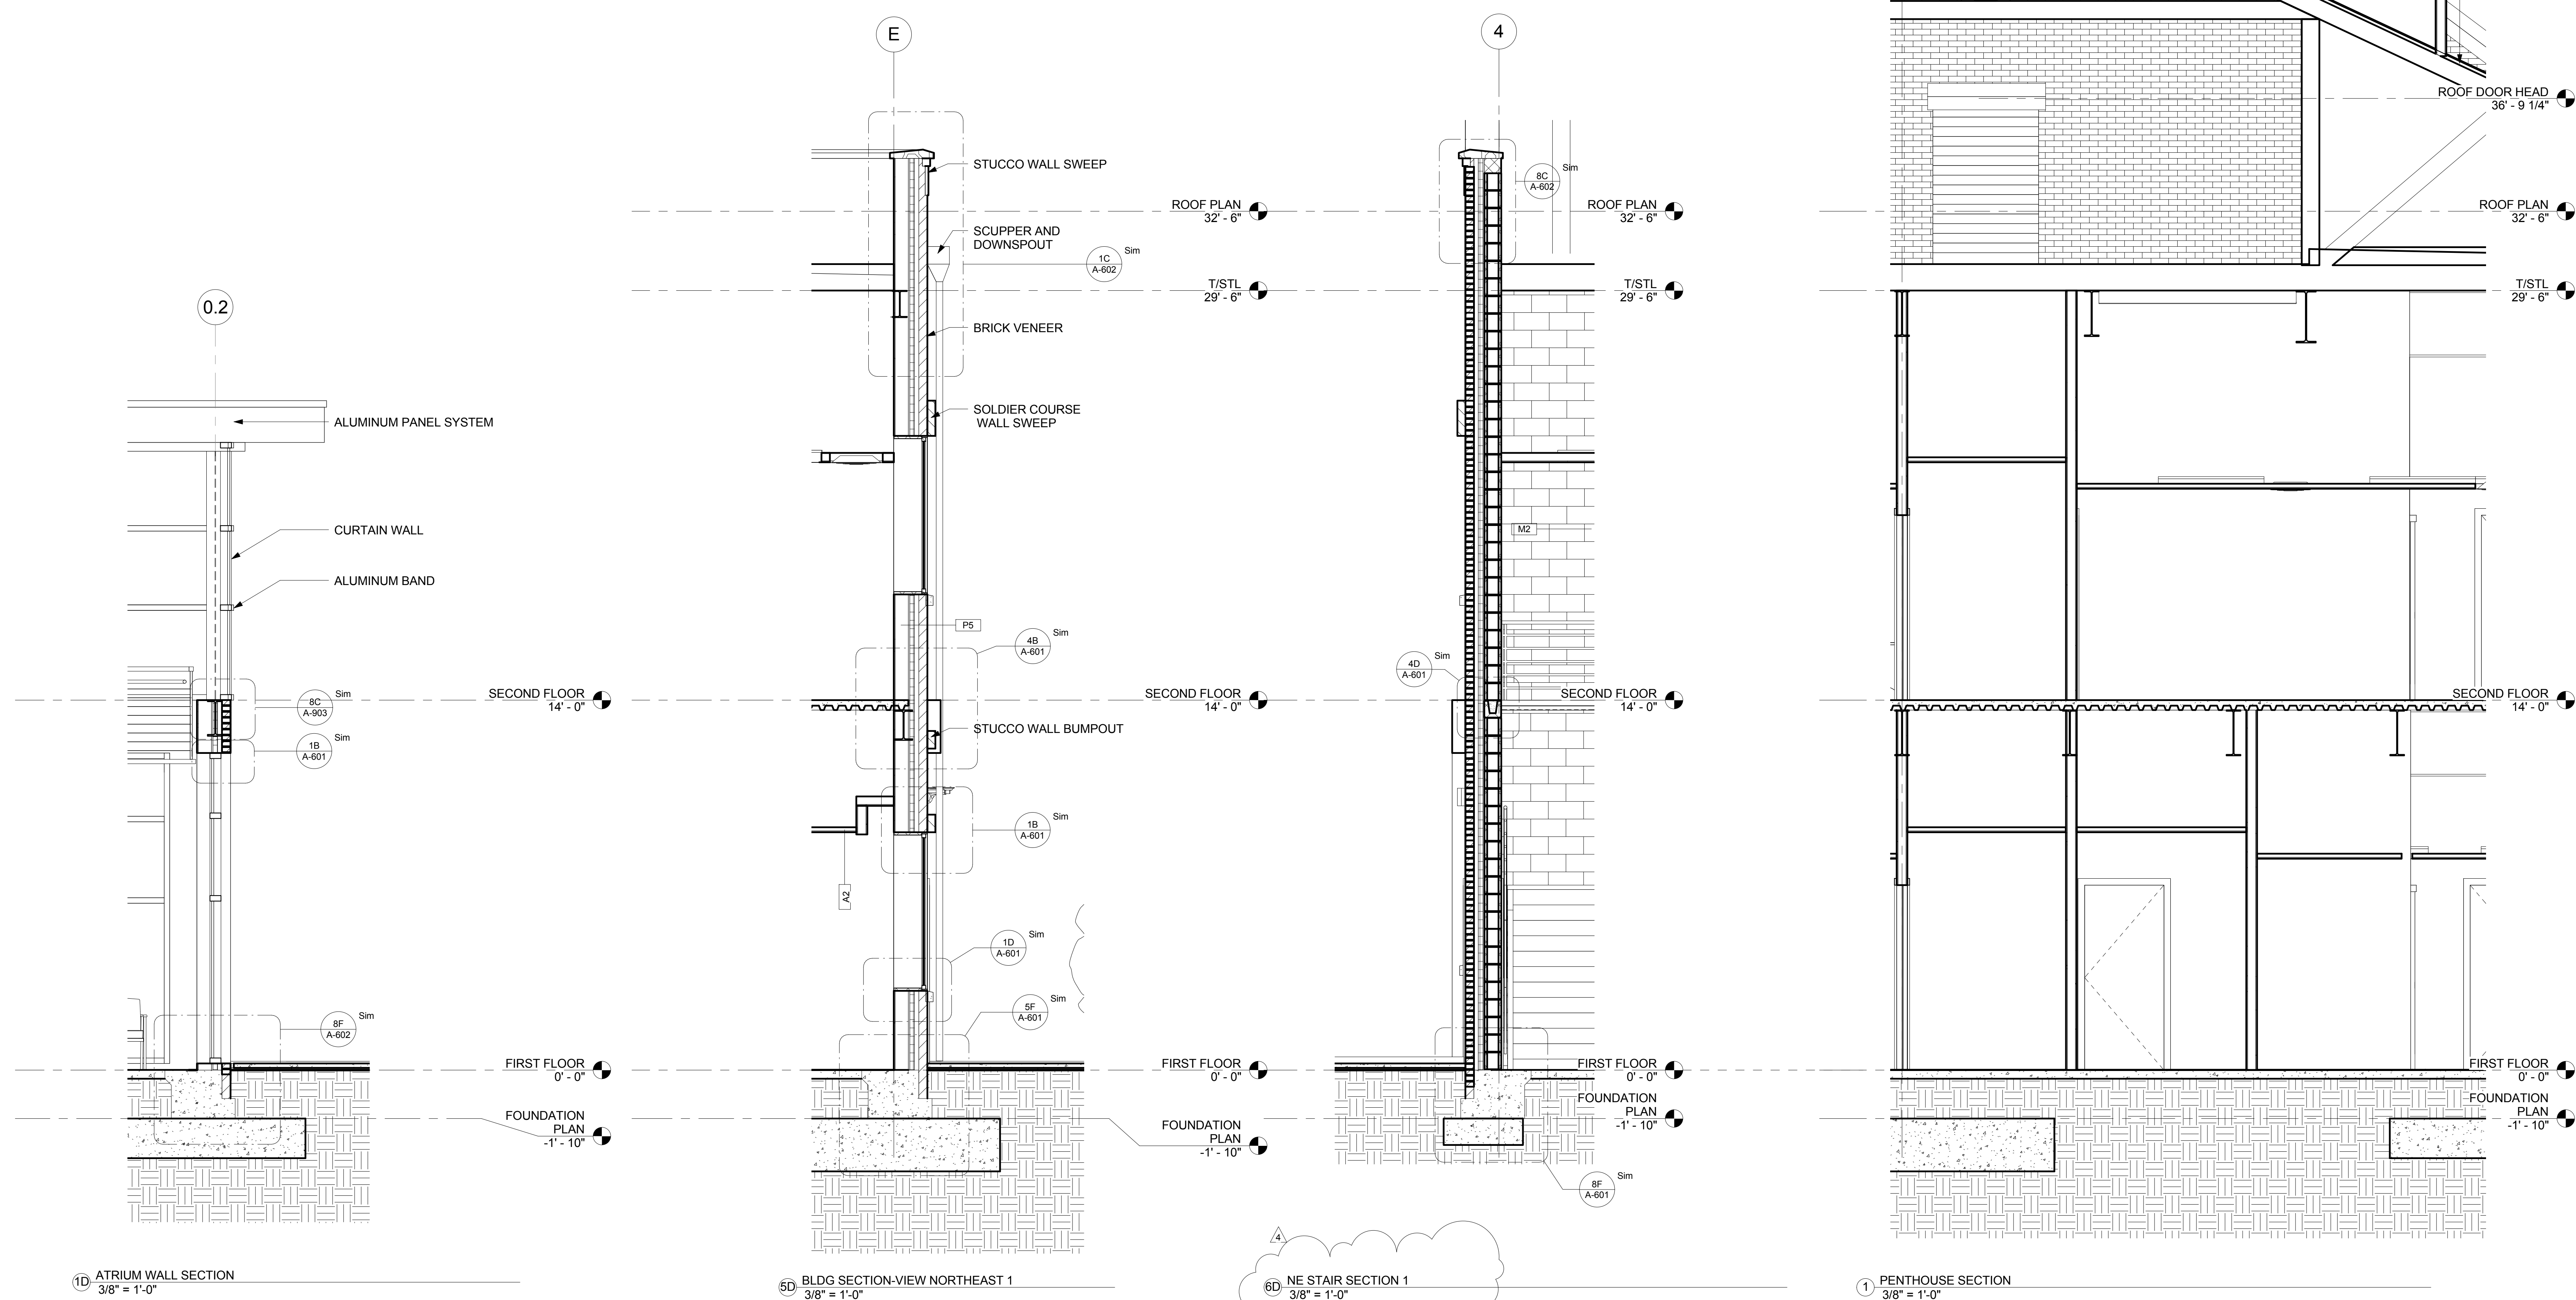

100% CONSTRUCTION DOCUMENTS

<p>CONSULTANTS:</p> <p><b>ROWE PROFESSIONAL SERVICES COMPANY</b> Engineering • Surveying • Aerial Photography / Mapping Landscape Architecture • Planning 511 Broadway Street, Myrtle Beach, SC 29577 Tel: 843.444.1020 www.rowepsc.com Fax: 843.444.3936</p>		<p>ARCHITECT/ENGINEERS:</p> <p><b>URS</b> 1000 Abernathy Road NE, Suite 900 400 Northpark Tower Center Atlanta, Georgia 30328 Tel: 678.838.8800</p> <p><b>aa+e</b> 1101 Johnson Avenue, Suite 104 Myrtle Beach, SC 29577 843.712.1470</p> <p>Accord Architects &amp; Engineers</p>		<p>Drawing Title</p> <p><b>EXTERIOR WALL SECTION</b></p> <p>Approved: Project Director</p>		<p>Project Title</p> <p><b>DORN VAMC CLINIC ADDITION</b></p> <p>Location Columbia, South Carolina</p> <p>Date March 26, 2015</p> <p>Checked CC</p> <p>Drawn SS</p>		<p>Project Number <b>544-302</b></p> <p>Building Number 122</p> <p>Drawing Number <b>A-508</b></p>		<p>Office of Facilities Management</p> <p>Department of Veterans Affairs</p>	
---	--	--	--	--	--	--	--	--	--	--	--

6/22/2015 3:38:42 PM