

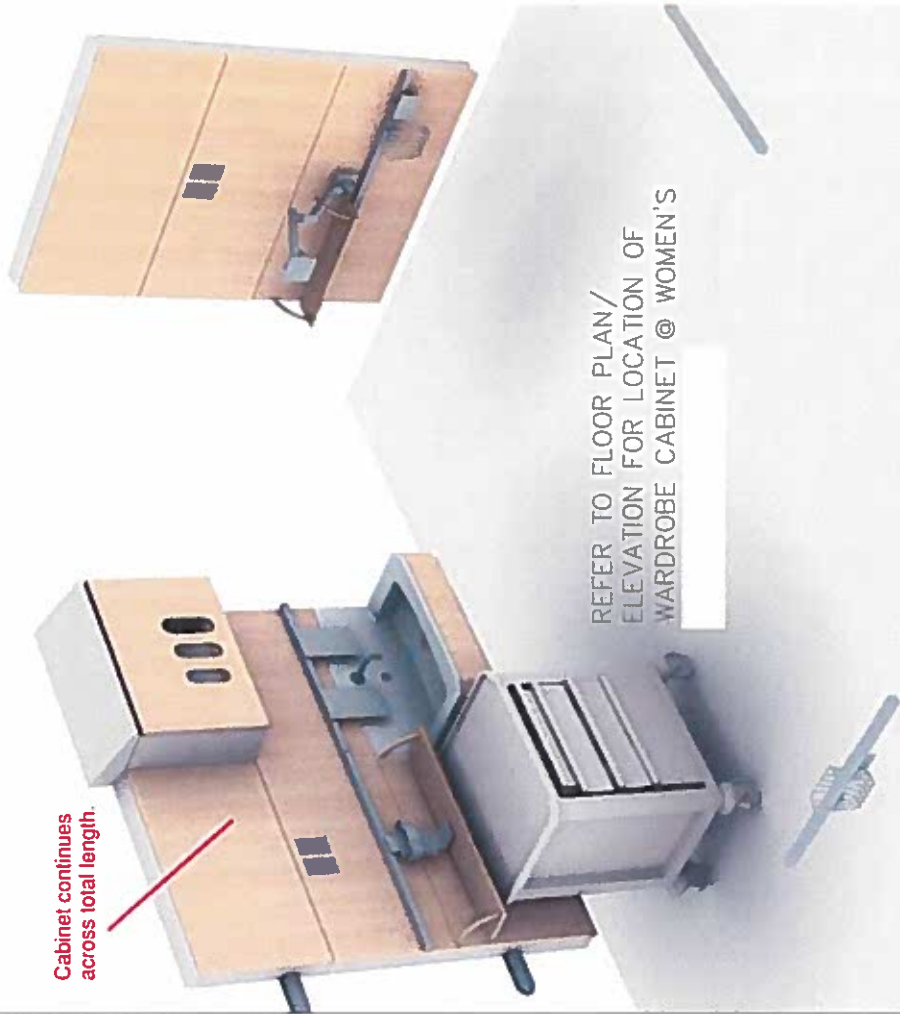
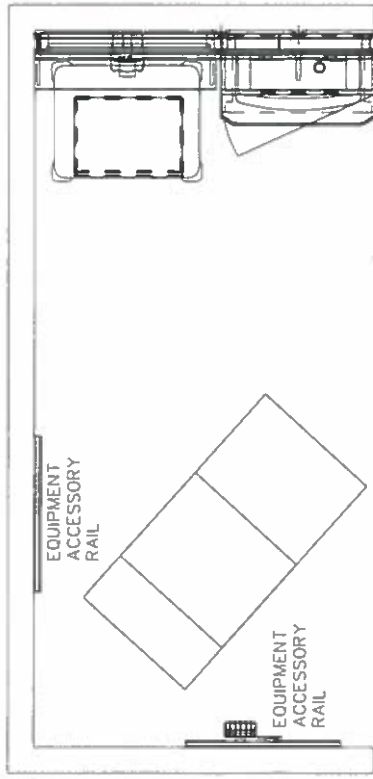
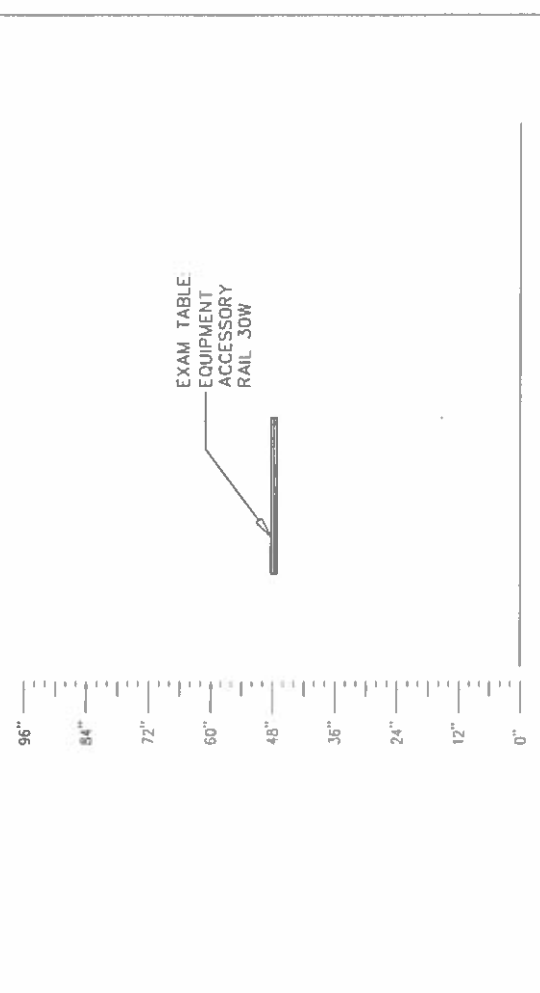
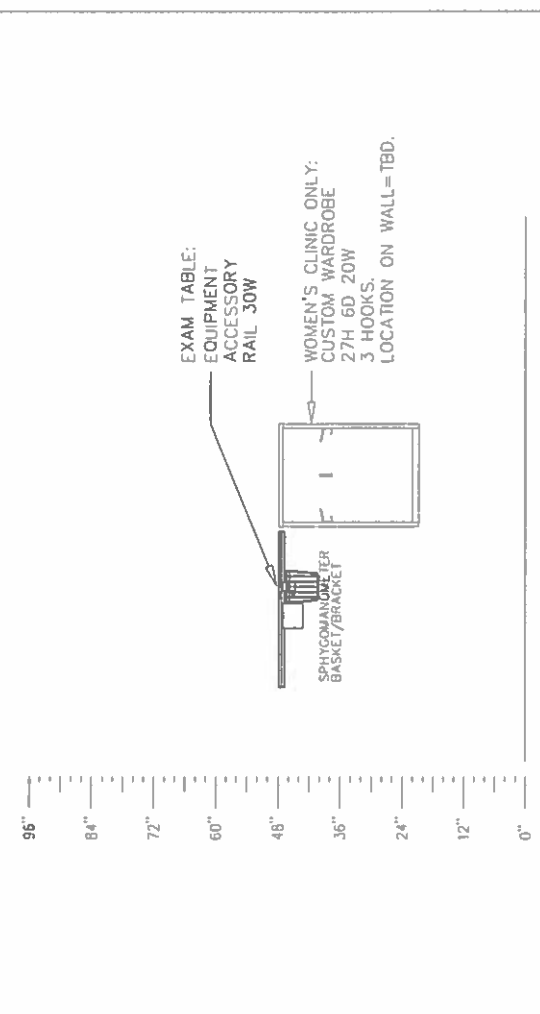


REFER TO NOTES IN BIDDER SHEET FOR REVISIONS.

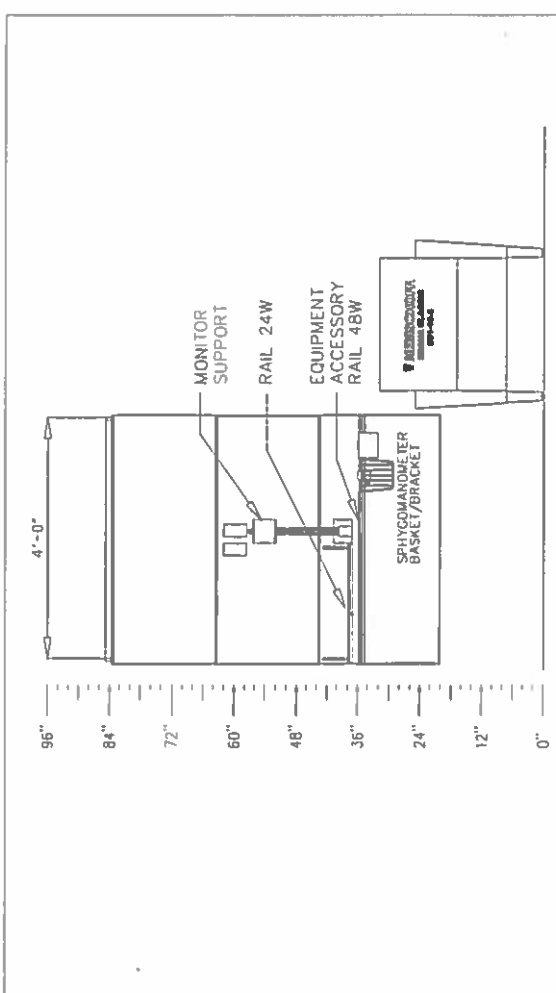

REFER TO FLOOR PLAN/
ELEVATION FOR LOCATION OF
WARDROBE CABINET @ WOMEN'S

Scale: 1/2"=1'-0"

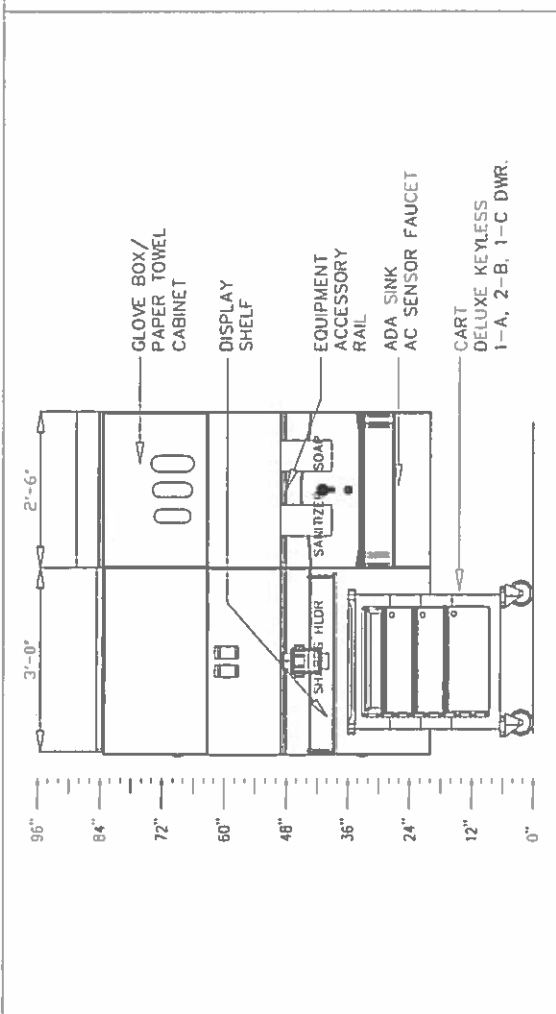

Scale: 1/2"=1'-0"

REFER TO NOTES IN BIDDER SHEET FOR REVISIONS.