


1. REFER TO DRAWINGS H-2 THRU H-7 FOR DETAILS, REQUIREMENT SCHEDULES FOR SYMBOLS.
2. INSTALL CLEANOUT DOORS ON ALL OPERATING ROOM DUCTWORK EVERY 40' AND ON ALL DUCTWORK SERVING OPERATING ROOMS. PLAN
3. HEAVY STEEL-BLADE SPANLESS STEEL PLATING CHAMPIERS IN THE BRACKET DUCTS TO THE SUBRAIL DIFFUSERS THERE ARE TO BE REQUIRED SLIP AS FOLLOWS:

- 2'-8" X 14"
- 2'-8" X 12"
- 2'-12" X 12"
- 4'-14" X 14"

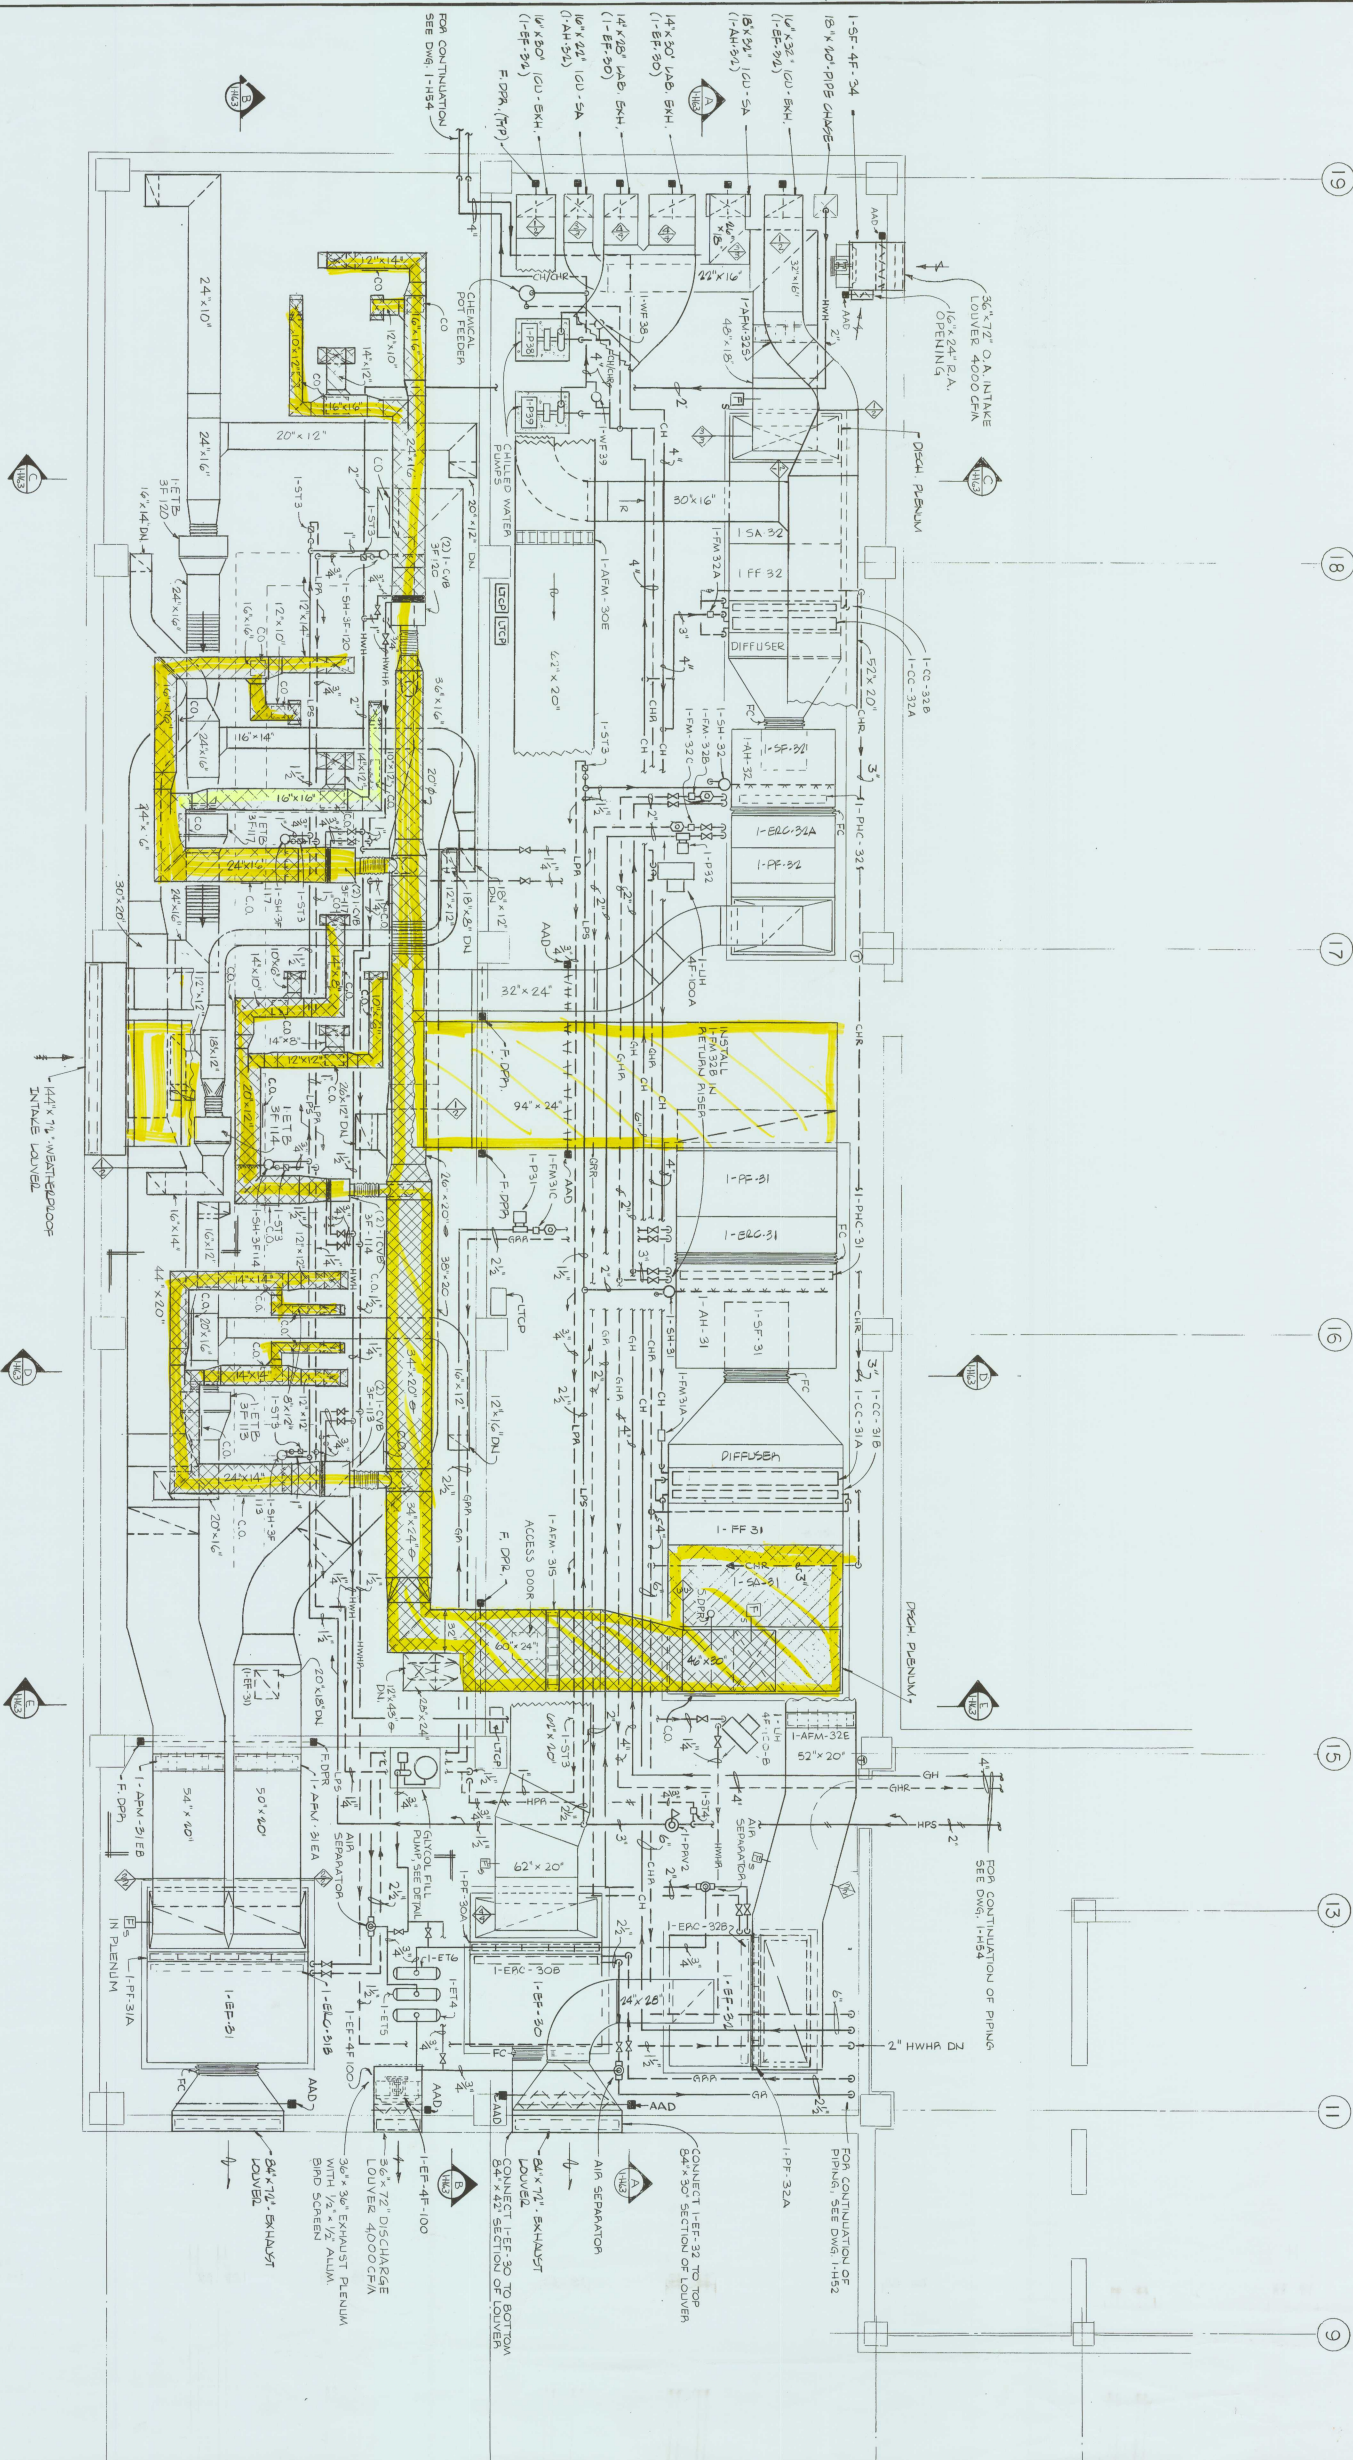

Revisions

Date	9/20
------	------

PETER F. LOFTUS DIVISION
EICHLAY ENGINEERS INC.
CONSULTING AND DESIGN ENGINEERS
PITTSBURGH, PA



TAG-VÝKR
ARCHITECTURE-ENGINEERING-PLANNING
Charleston, West Virginia
Alexandra, Virginia

Drawing Title
FOURTH FLOOR ADDITION
MECHANICAL PENTHOUSE

Project Title
CLINICAL ADDITION
AND ALTERATIONS

Date
7/18/86

Project No.
540-008

DRAWING No.
1-H67

Drawing 62 of 67