

A

three inches = one foot

1

0

6"

B

one and one half inches = one foot

2

0

6"

C

one inch = one foot

2

0

6"

D

three quarters inch = one foot

4

0

6"

E

one half inch = one foot

4

0

6"

F

three eighths inch = one foot

8

0

6"

G

one quarter inch = one foot

16

0

6"


H

one eighth inch = one foot

32

0

6"


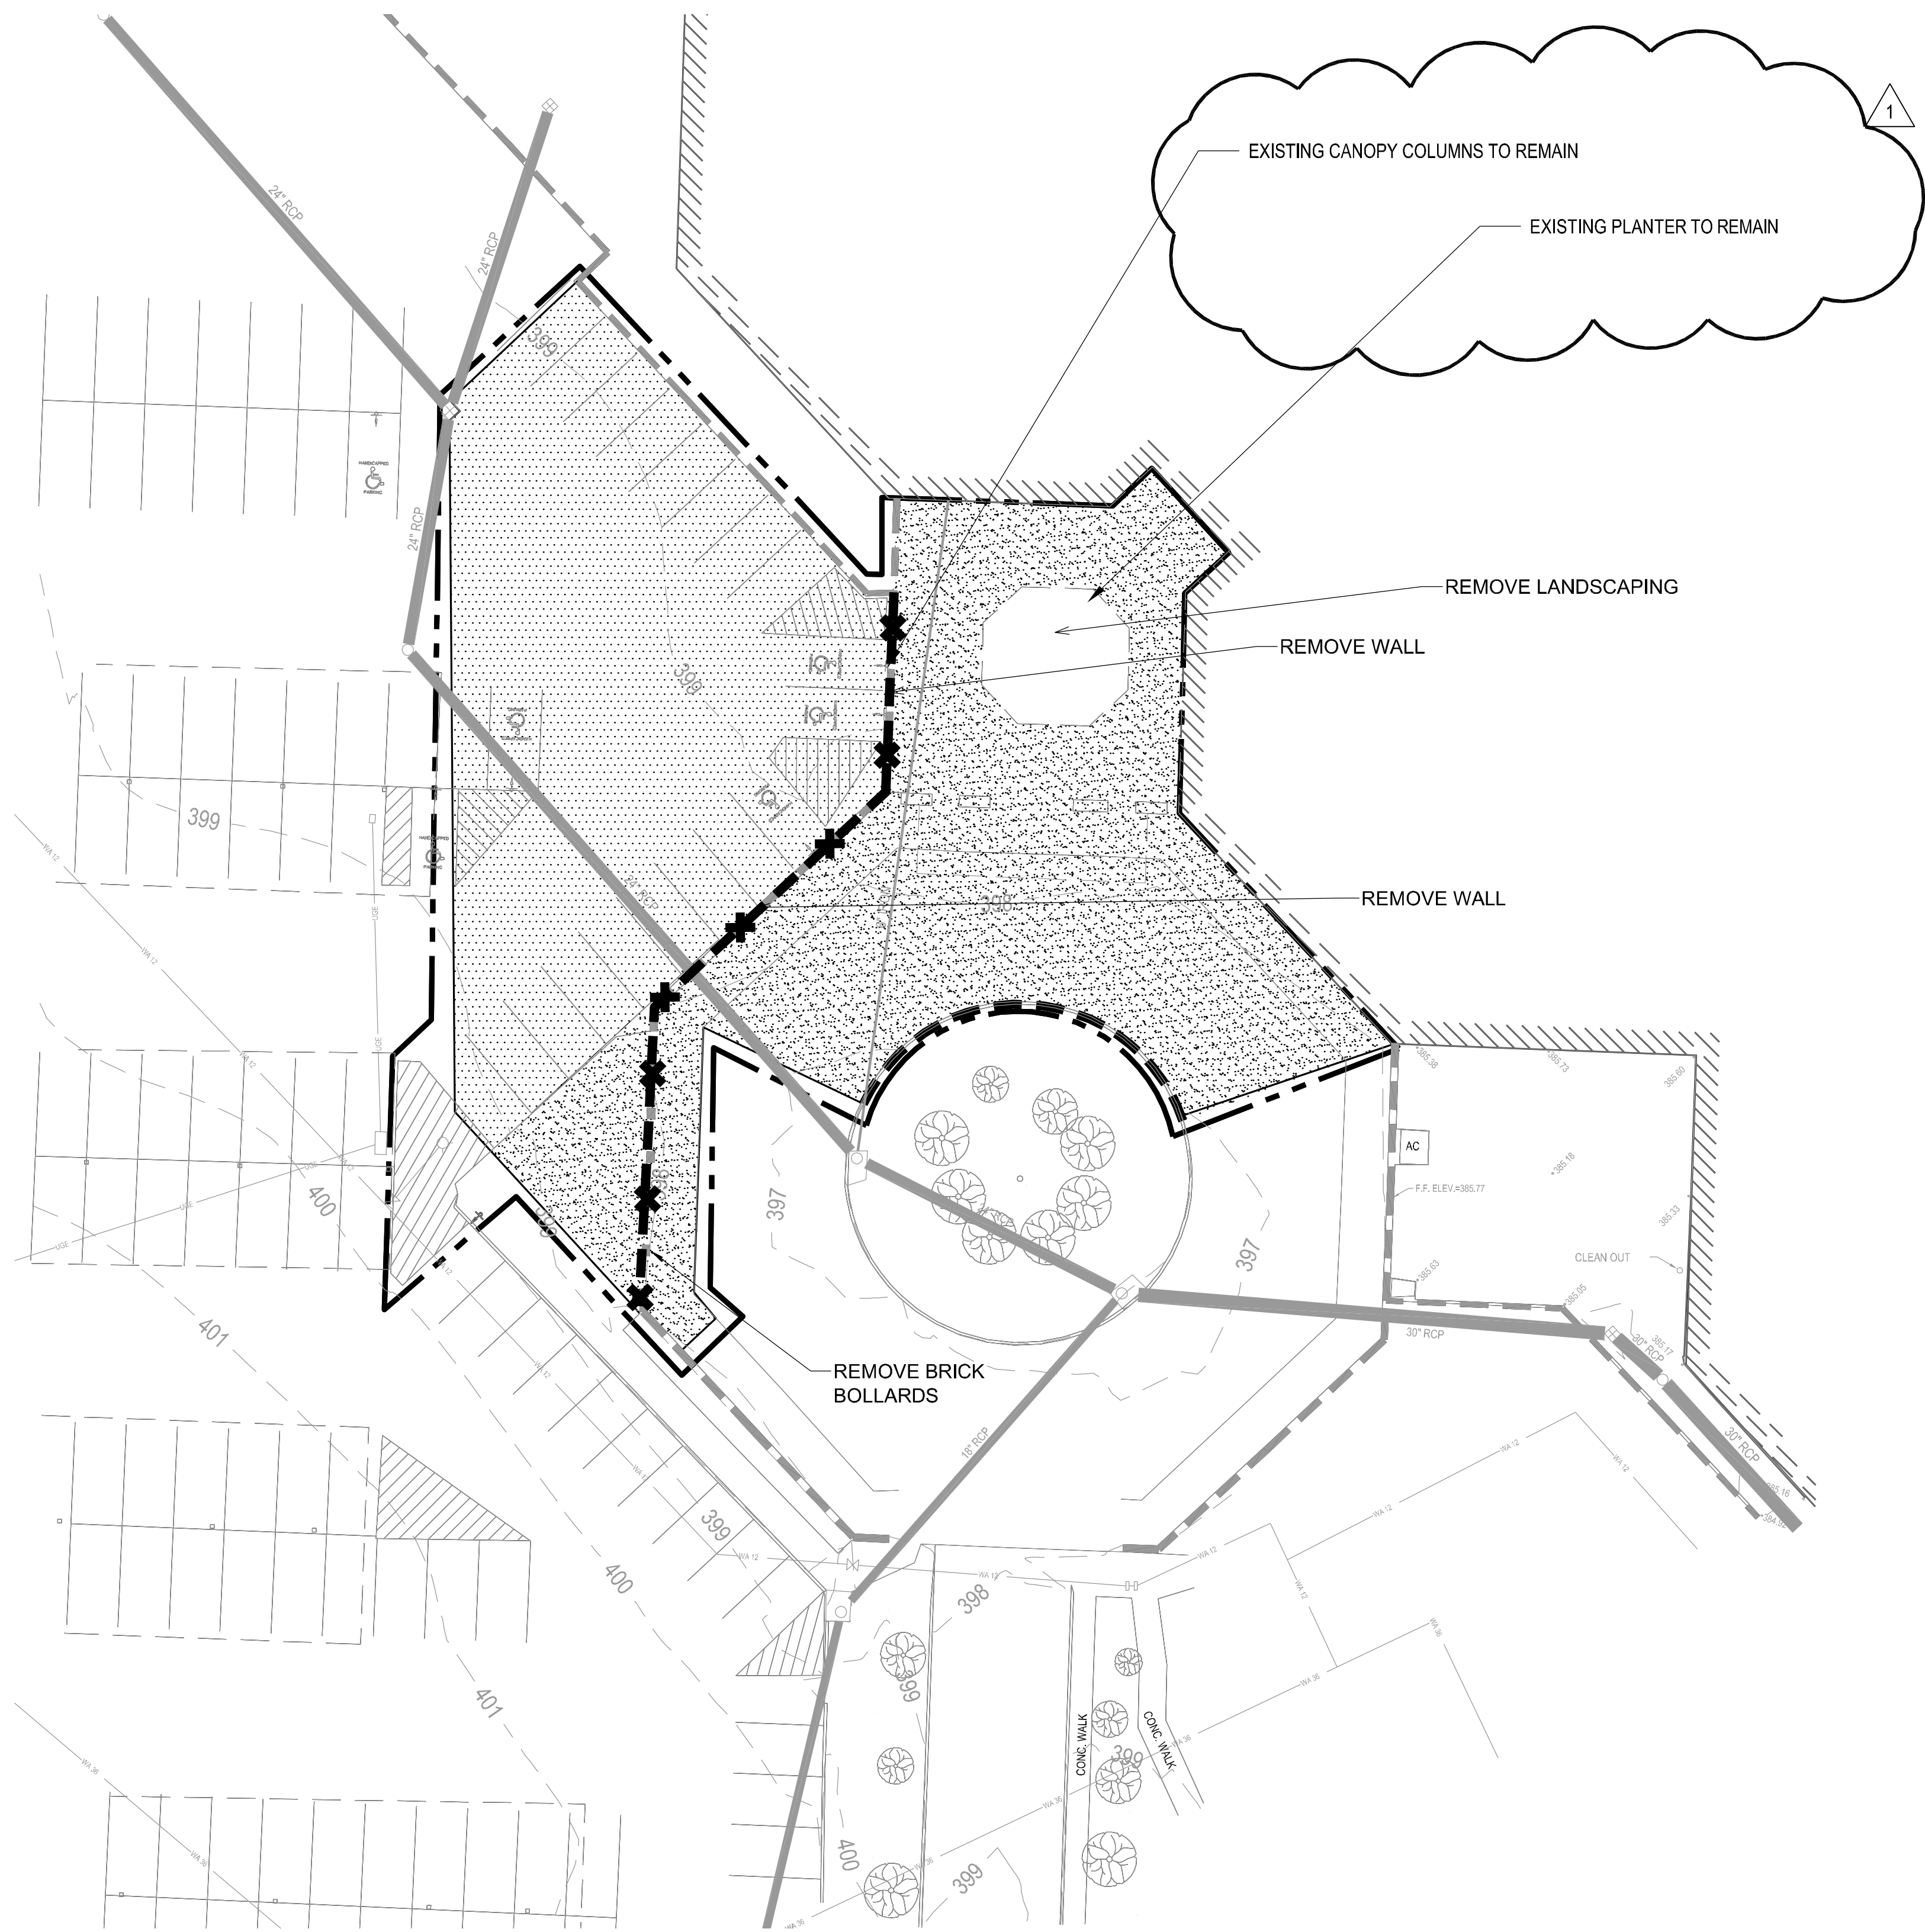


LEGEND


- REMOVE CONCRETE WALK OR ISLAND
- REMOVE ASPHALT PAVEMENT
- REMOVE INTEGRAL CURB
- REMOVE WALL

NOTES:

1. CONTRACTOR SHALL SAW CUT IMPROVEMENTS @ REMOVAL LINES.
2. CONTRACTOR SHALL VERIFY THE LOCATION OF ALL EXISTING UTILITIES PRIOR TO EXCAVATING. ANY DAMAGE TO EXISTING UTILITIES SHALL BE REPAIRED AT THE CONTRACTOR'S EXPENSE.

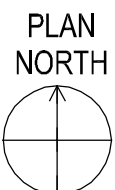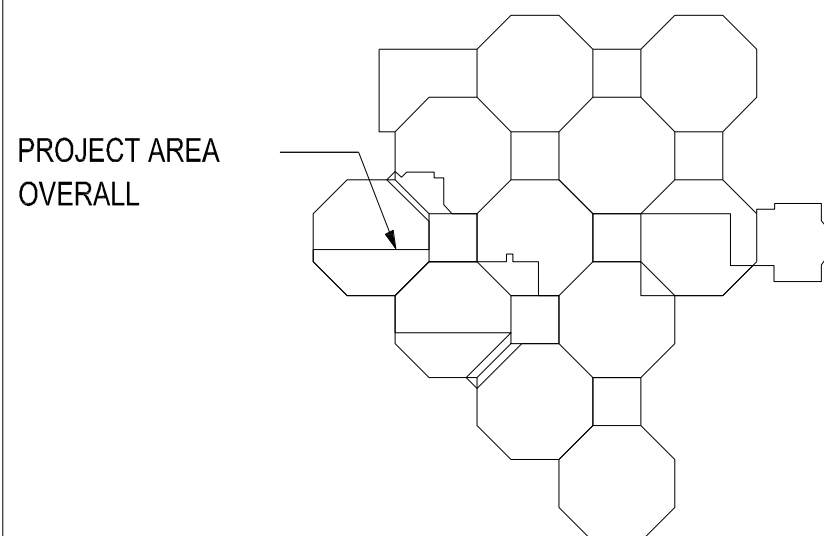

KEY PLAN
LEVEL 1 F.F.E.:
PROJECT TOTAL:

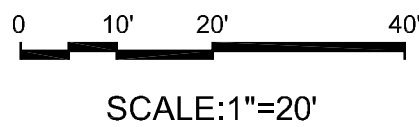

SCHEMATIC DESIGN SUBMISSION
FULLY SPRINKLERED

<div>1 ADD NOTES</div> <div>Revisions:</div> <div>6/29/2015</div> <div>Date</div>		<div>CONSULTANTS:</div> <div>CIVIL DESIGN</div> <div>CROMWELL AVE</div> <div>101 SOUTH SPRING STREET</div> <div>LITTLE ROCK, ARKANSAS 72201</div> <div>501-372-2900</div>		<div>ARCHITECT/ENGINEERS:</div> <div>BES DESIGN/BUILD</div> <div>BES DESIGN/BUILD, LLC</div> <div>766 Middle St. Fairhope, AL 36532</div> <div>Phone: 251.990.5778</div> <div>Fax: 251.990.3716</div>		<div>Drawing Title</div> <div>SITE DEMOLITION PLAN</div> <div>Approved: Project Director</div>		<div>Project Title</div> <div>IMPROVE OUTPATIENT SPECIALTY CLINIC SUPPORT AREAS</div> <div>Location</div> <div>LITTLE ROCK, AR</div> <div>Date</div> <div>2015.03.06</div> <div>Drawn</div> <div>MJT</div> <div>Checked</div> <div>SBM</div>		<div>Project Number</div> <div>598-13-107</div> <div>Building Number</div> <div>1</div> <div>Drawing Number</div> <div>CD101</div> <div>Dwg. 19 of 143</div>		<div>CENTRAL ARKANSAS VETERANS AFFAIRS HEALTHCARE SYSTEM</div>	
---	--	---	--	---	--	--	--	--	--	--	--	--	--