



6
5
4
3
2
1
A
B
C
NO
NP
NQ
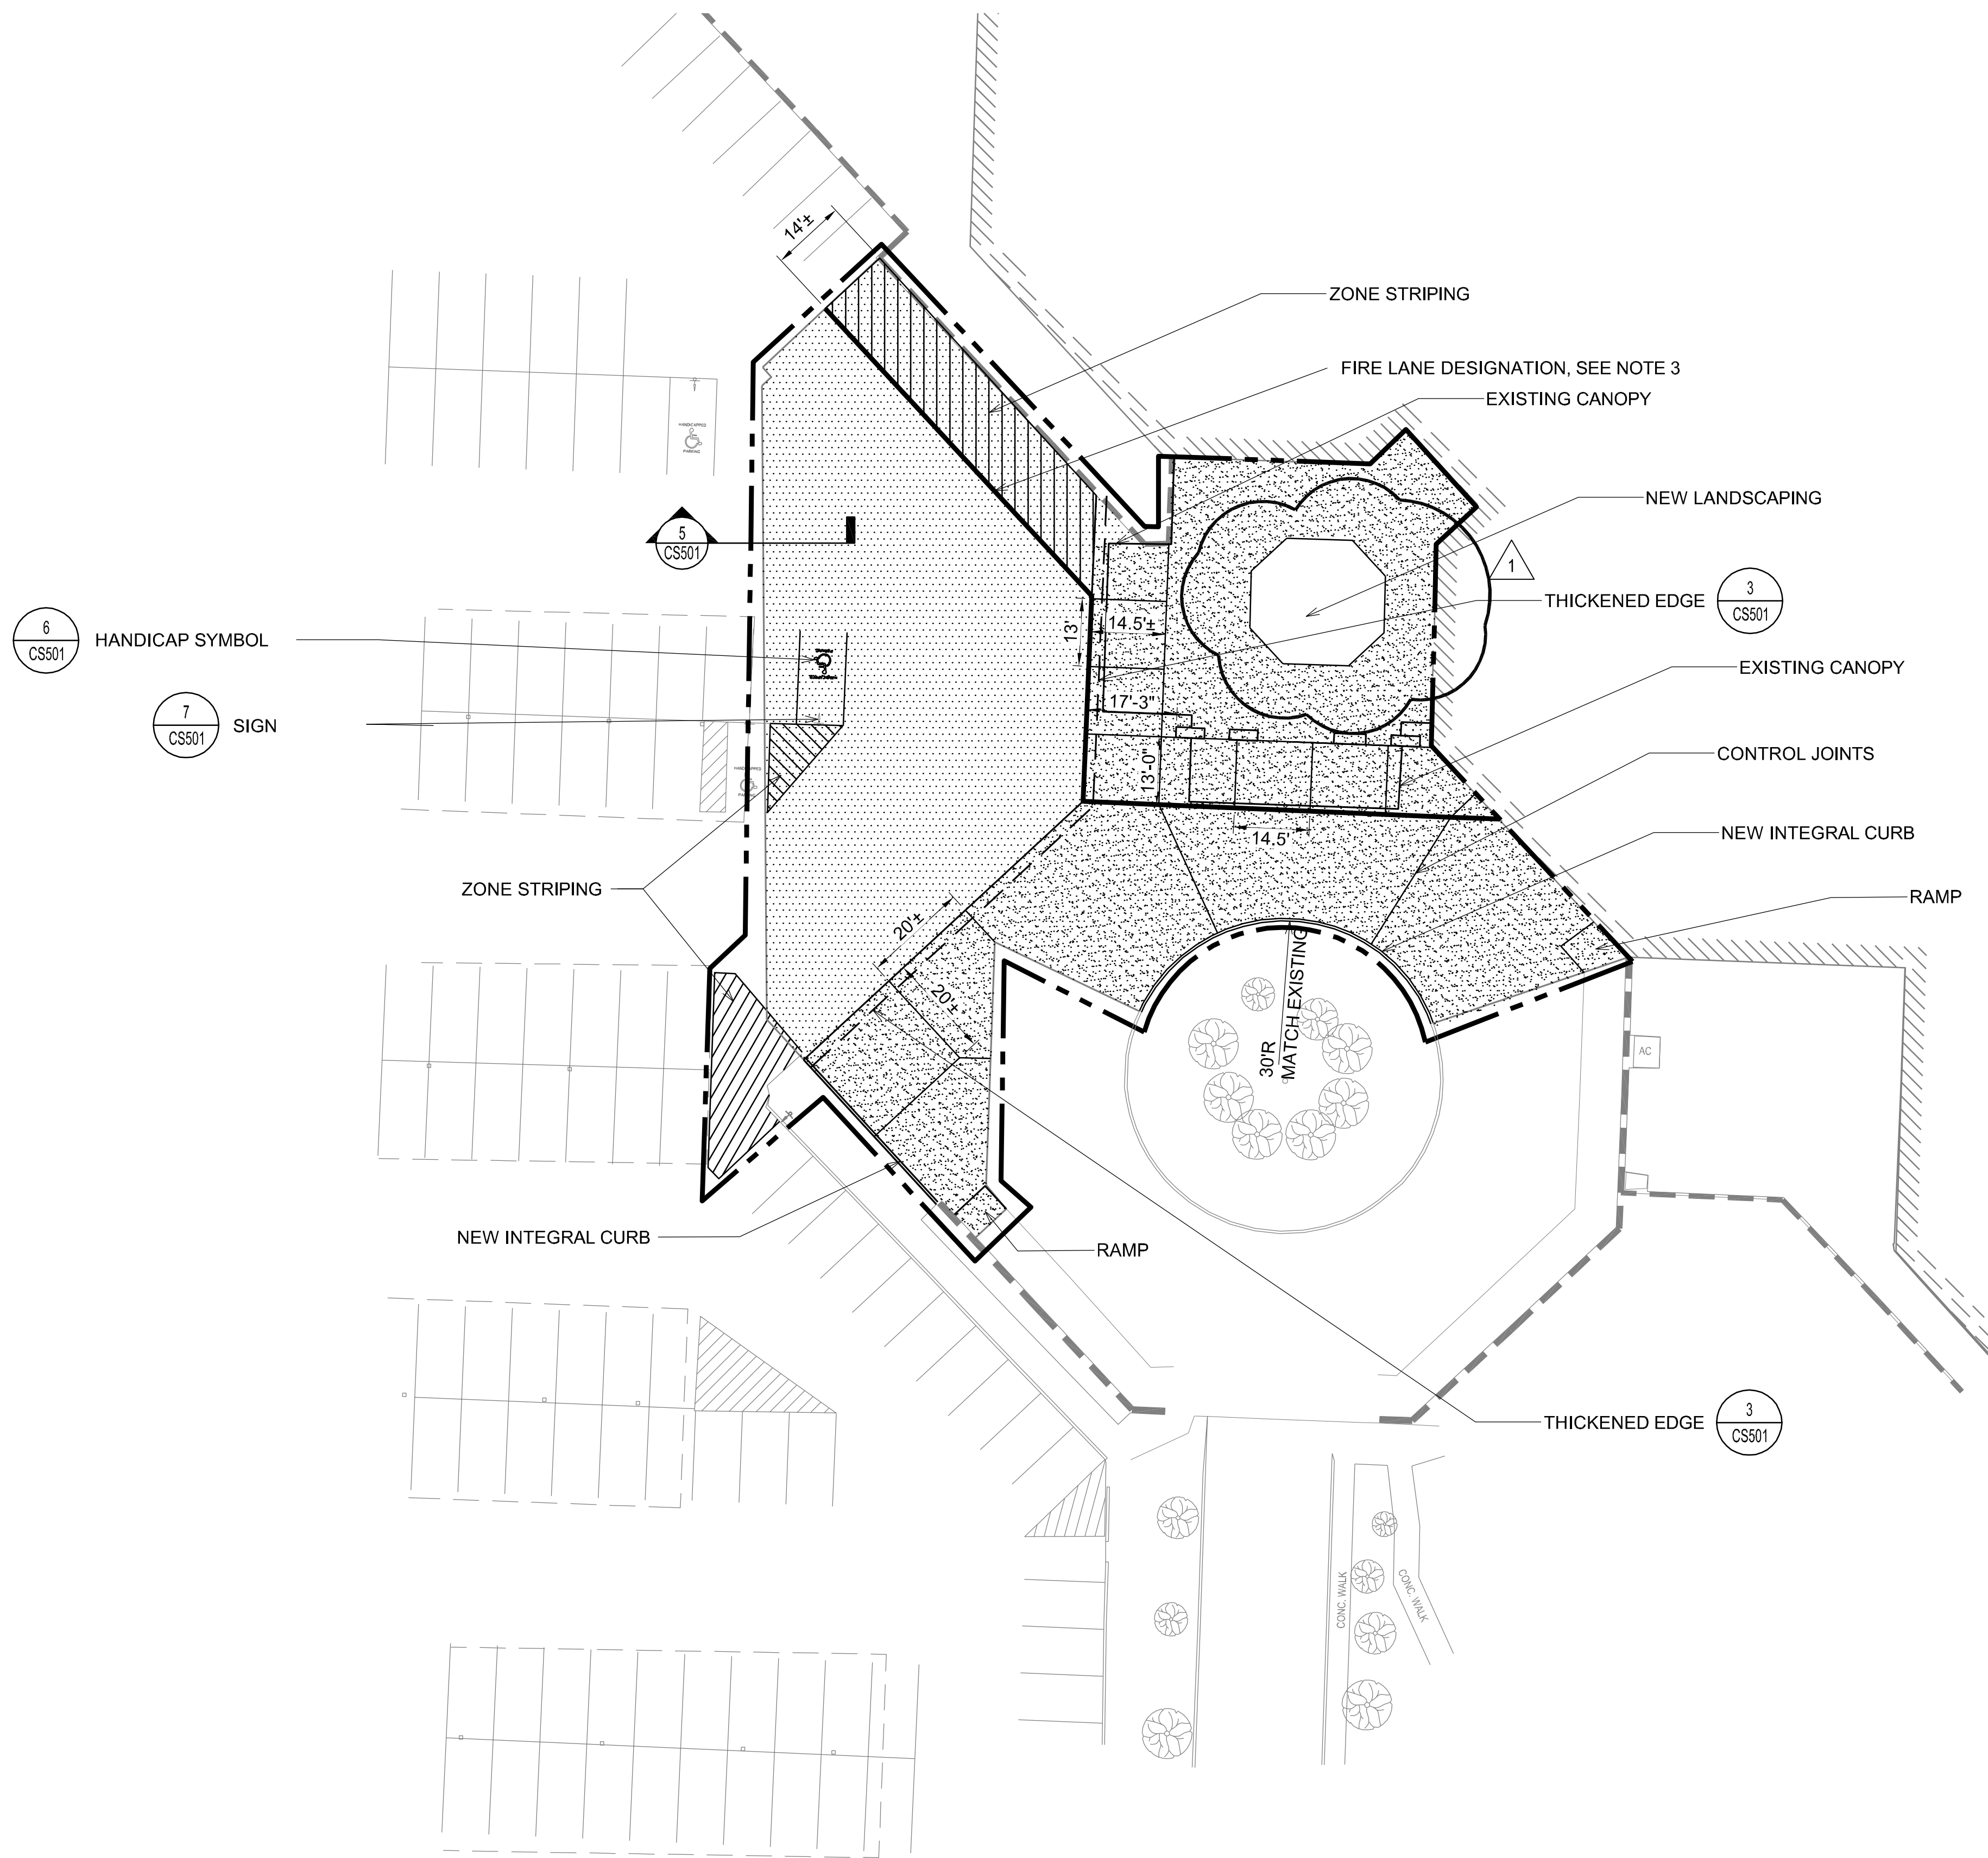

LEGEND		DETAIL REFERENCE
NEW CONCRETE PAVEMENT		2 CS501
NEW CONCRETE WALK		2 CS501
NEW ASPHALT PAVEMENT		1 CS501
NEW INTEGRAL CURB		4 CS501

NOTES:

- PARKING LOT STRIPING SHALL BE 4" WIDE, WHITE, NON-REFLECTIVE TRAFFIC PAINT. ZONE STRIPING SHALL BE @ 2' CENTERS AND AT 45° TO LINE OF TRAFFIC.
- DIMENSIONS TO CURBS ARE TO BACK OF CURB. DIMENSIONS TO BUILDINGS ARE TO OUTSIDE FACE OF BUILDING WALL.
- FIRE LANE STRIPING SHALL BE 6" WIDE, RED NON-REFLECTIVE TRAFFIC PAINT AND SHALL HAVE "NO PARKING- FIRE LANE" IN 4" WHITE REFLECTIVE PAINT WITH 3/4" STROKE WITH 25' BETWEEN LETTERING CENTERED WITHIN RED STRIPE.
- RE-FINISH AND REPAINT EXISTING COLUMNS IN AREA WHERE BRICK WALL WAS REMOVED ON THE WEST SIDE OF THE CANOPY, TO MATCH THE EXISTING CANOPY COLUMNS.

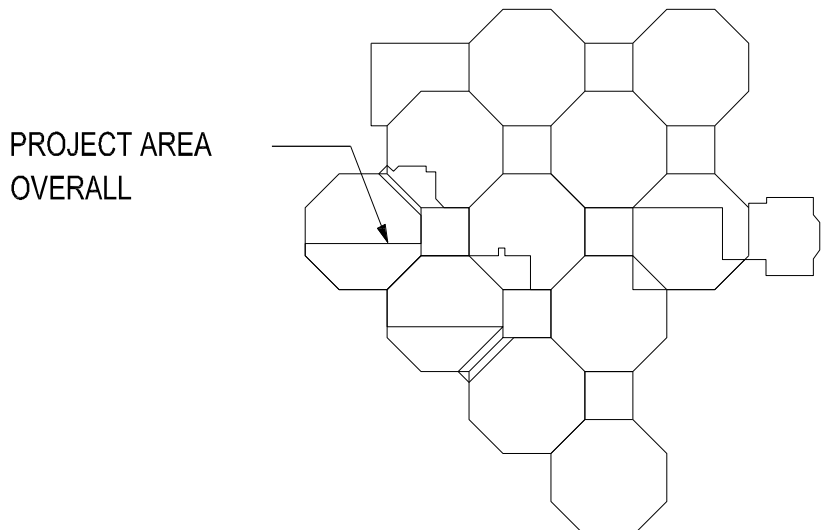

KEY PLAN
LEVEL 1 F.F.E.:
PROJECT TOTAL:

0 10' 20' 40'
SCALE: 1"=20'

SCHEMATIC DESIGN SUBMISSION
FULLY SPRINKLERED

CONSULTANTS: CIVIL DESIGN CROMWELL AVE 101 SOUTH SPRING STREET LITTLE ROCK, ARKANSAS 72201 501-372-2900		ARCHITECT/ENGINEERS: BES DESIGN/BUILD 766 Middle St. Fairhope, AL 36532 Phone: 251.990.5778 Fax: 251.990.3716		Drawing Title SITE PLAN		Project Title IMPROVE OUTPATIENT SPECIALTY CLINIC SUPPORT AREAS		Project Number 598-13-107		Building Number 1		CENTRAL ARKANSAS VETERANS AFFAIRS HEALTHCARE SYSTEM	
1 REVISE SIDEWALK AROUND EXISTING LANDSCAPING Revisions: 6/29/2015 Date		Approved: Project Director		Location LITTLE ROCK, AR		Date 2015.03.06		Drawn MJT		Checked SBM		Drawing Number CS101	
Dwg. 21 of 143													