

1.24 BULK OXYGEN STORAGE SYSTEM. PROVIDE FENCE ENCLOSURE WITH GATE PER DETAIL 14/AS4.1.3. GATE SHALL BE DOOR TYPE A2A PER AS9.1.1. PROVIDE THE FF HARDWARE: LOCK F07, STAINLESS STEEL HINGES (4) EACH LEAF, BOLT KEEPER, CANE BOLT, AND PADLOCK, TYPE AS REQUIRED BY MEDICAL CENTER.

1.25 FOR EMERGENCY OXYGEN INLET DETAIL, SEE 30/AE5.3.4. FOR O2 RISER AND PRV PENETRATION DETAIL SEE 24/AE4.3.4. SEE MECH DWGS FOR ADDL INFO.

ASI-027-ASK-01

ENLARGED ARCHITECTURAL SITE PLAN

ASK SKETCH NUMBER

SKETCH TITLE

1" = 30'-0"

AE1.1.2

SCALE

DOCUMENT REFERENCE

VA PALO ALTO POLYTRAUMA AND BLIND REHABILITATION CENTER

POLYTRAUMA

PROJECT NAME

640-424

38363.101

14 DEC 2012


VA PROJECT NUMBER

PROJECT NUMBER

DATE

SMITHGROUP JJR, INC. 301 Battery Street 7th Floor San Francisco, CA T 415.227.0100

SMITHGROUP JJR
The Design Partnership LLP

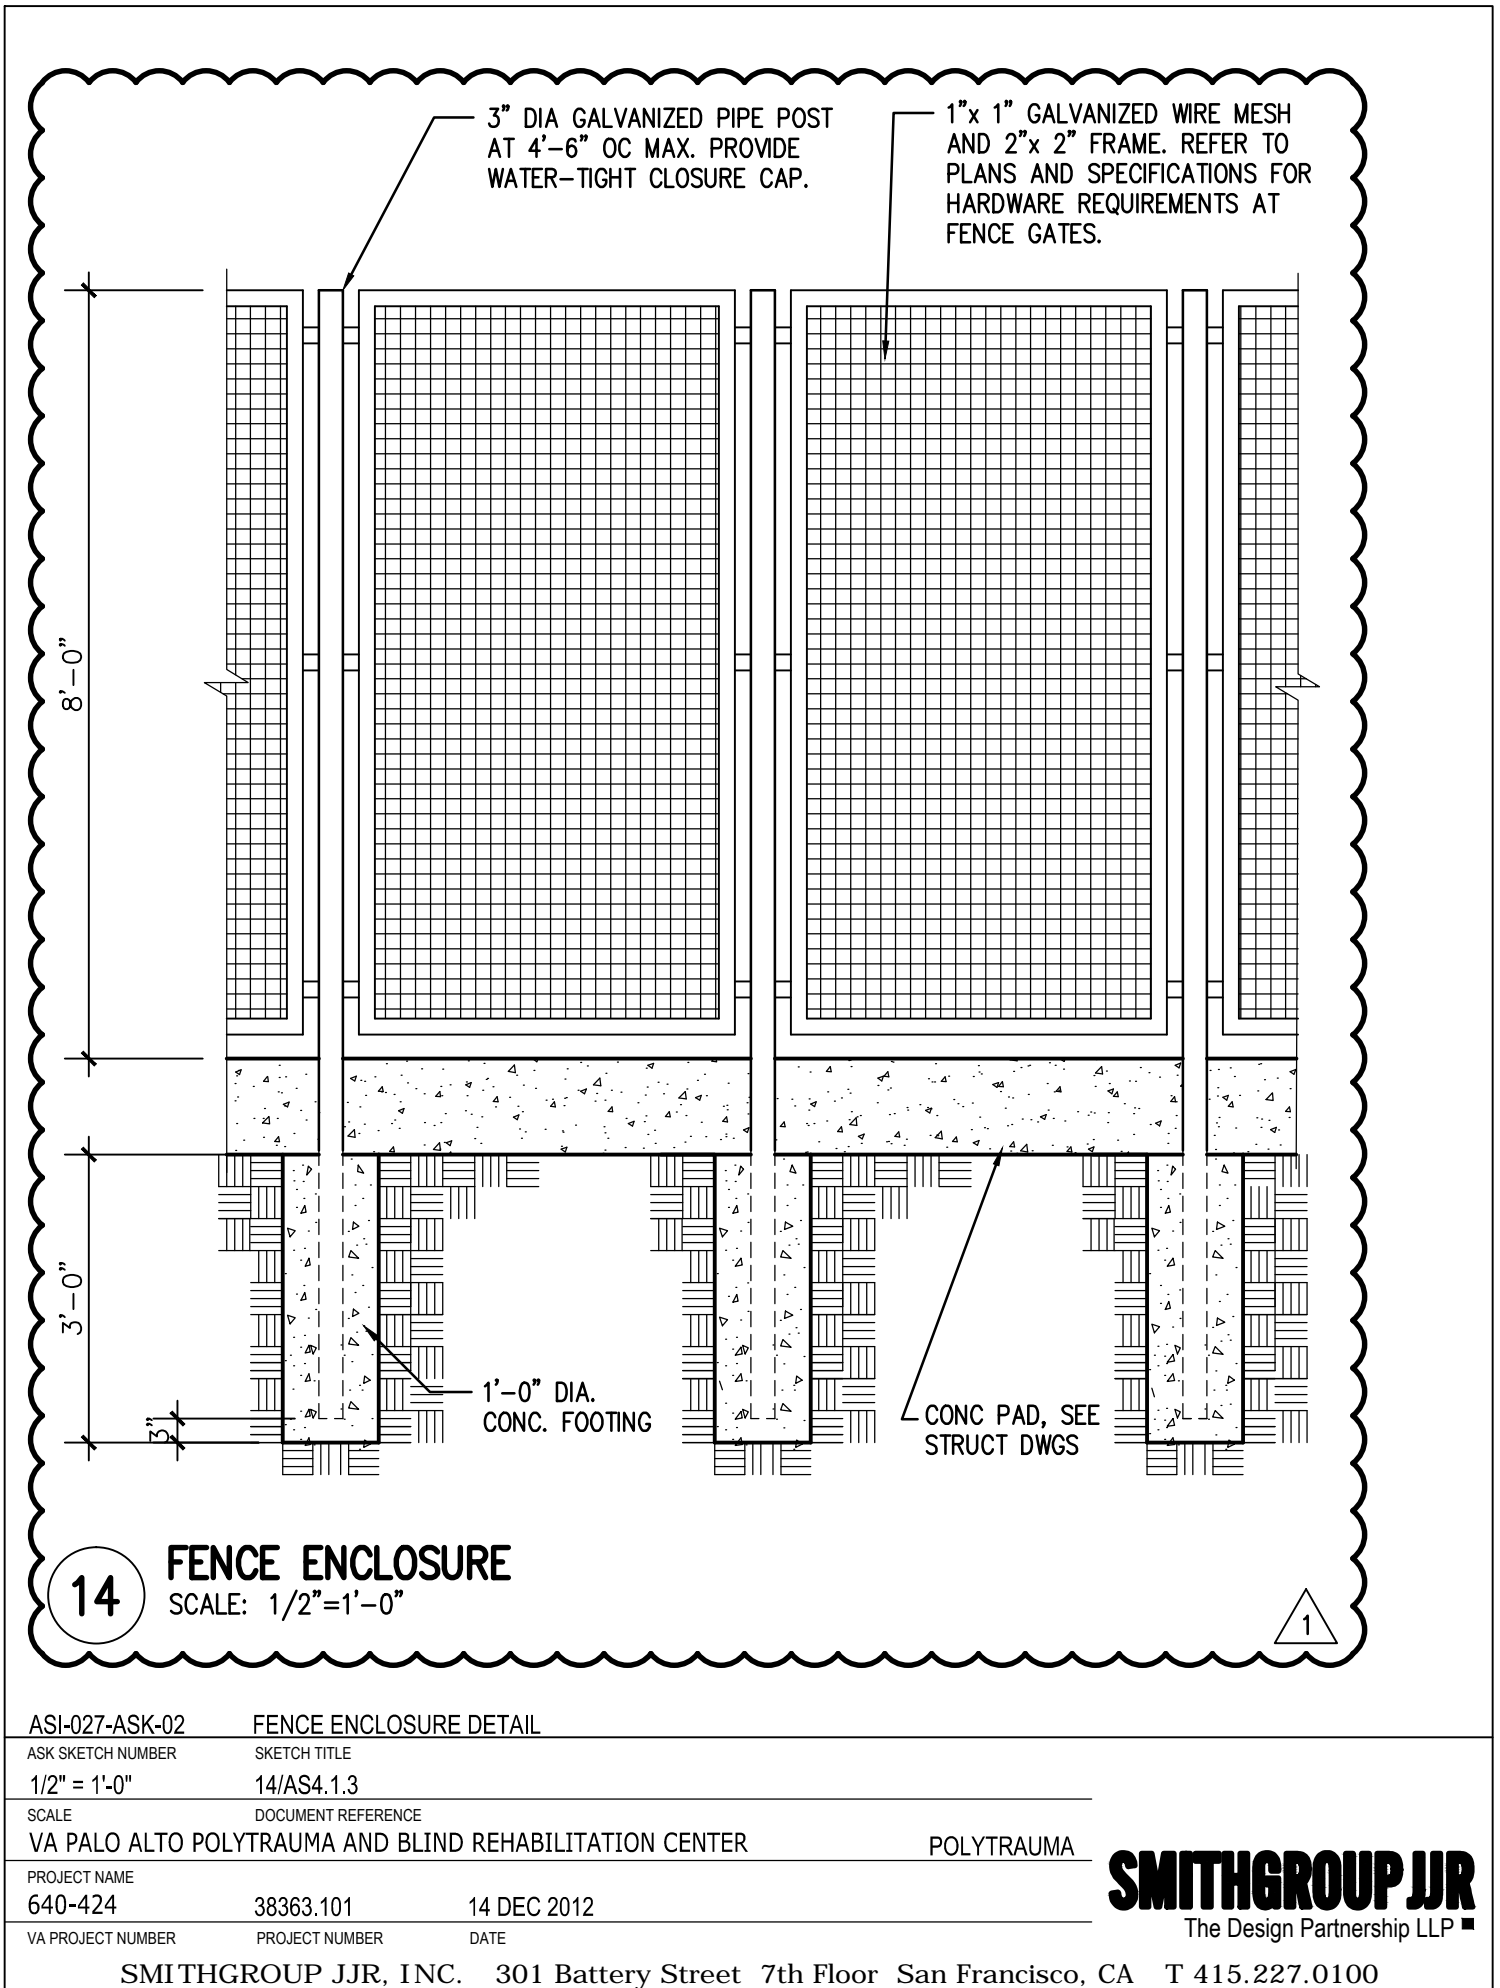

ASI-027-ASK-02

FENCE ENCLOSURE DETAIL

ASK SKETCH NUMBER

SKETCH TITLE

1/2" = 1'-0"

14/AS4.1.3

SCALE

DOCUMENT REFERENCE

VA PALO ALTO POLYTRAUMA AND BLIND REHABILITATION CENTER

POLYTRAUMA

PROJECT NAME

640-424

38363.101

14 DEC 2012

VA PROJECT NUMBER

PROJECT NUMBER

DATE

SMITHGROUP JJR, INC. 301 Battery Street 7th Floor San Francisco, CA T 415.227.0100

SMITHGROUP JJR
The Design Partnership LLP ■