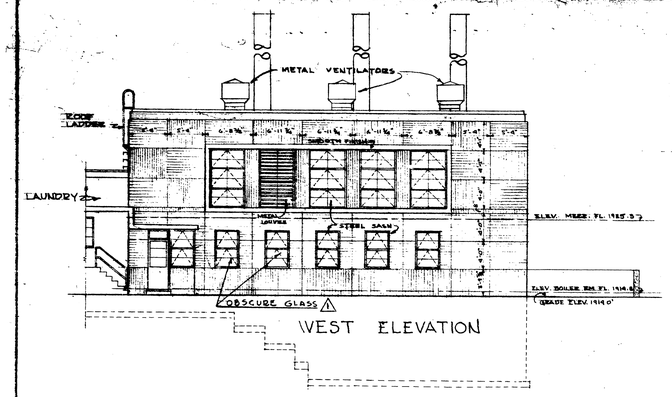

WEST ELEVATION

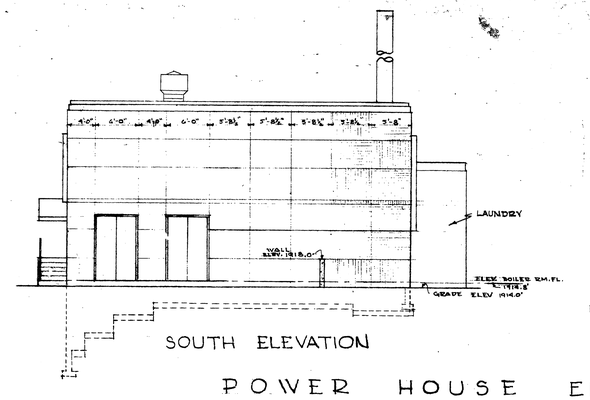

SOUTH ELEVATION

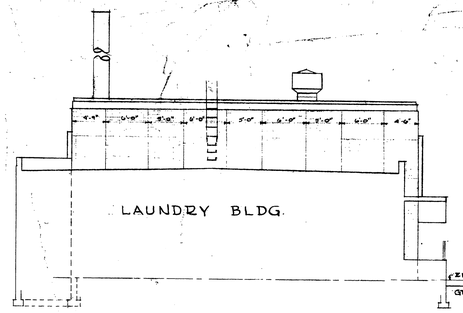

NORTH ELEVATION

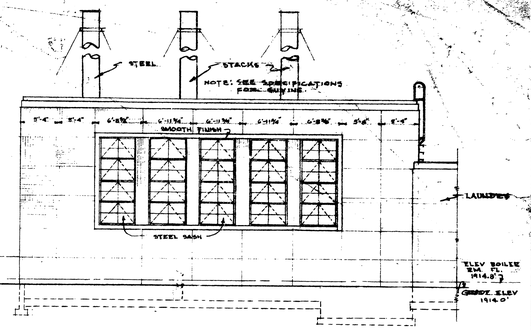

EAST ELEVATION

POWER HOUSE ELEVATIONS

SCALE 1/8" = 1'-0"

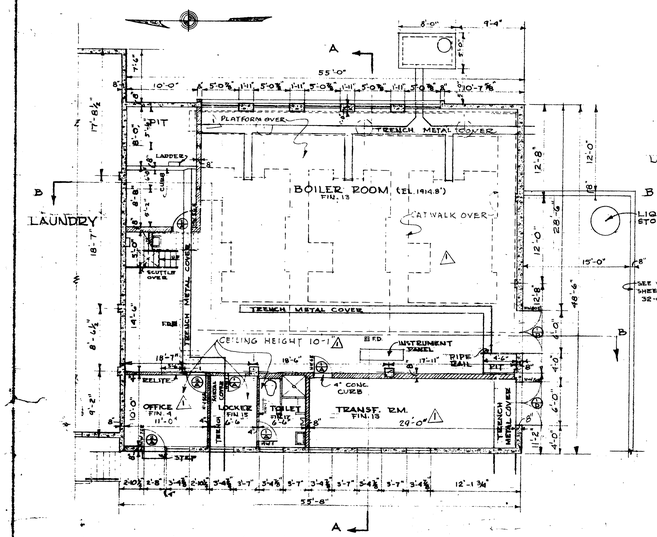

BOILER RM. PLAN

SCALE 1/8" = 1'-0"

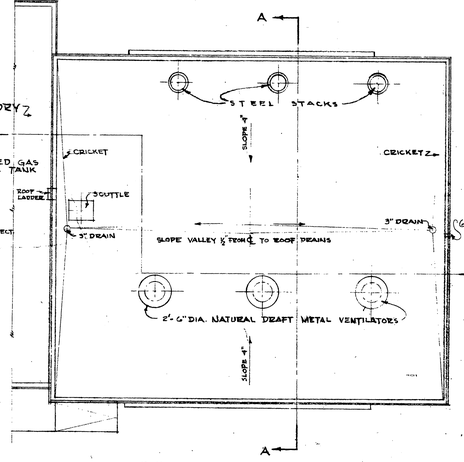

ROOF PLAN

SCALE 1/8" = 1'-0"

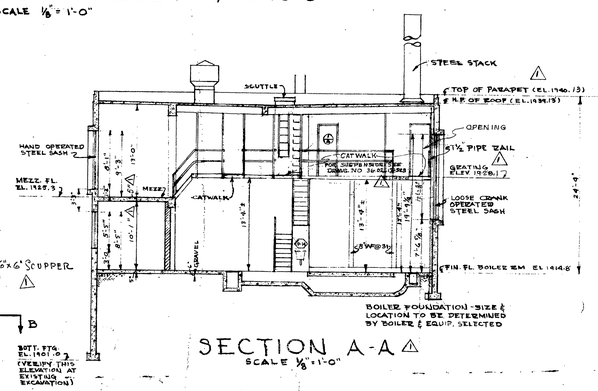

SECTION A-A

SCALE 1/8" = 1'-0"

NOT.
DETAILS SHOWN ON THIS SHEET WILL SUPERSEDE DETAILS SHOWN ON DRWG. NO. 36-02,13-A31

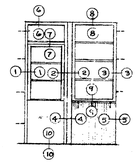

ENTRANCE DOOR & WINDOW

SCALE ¼" = 1'-0"

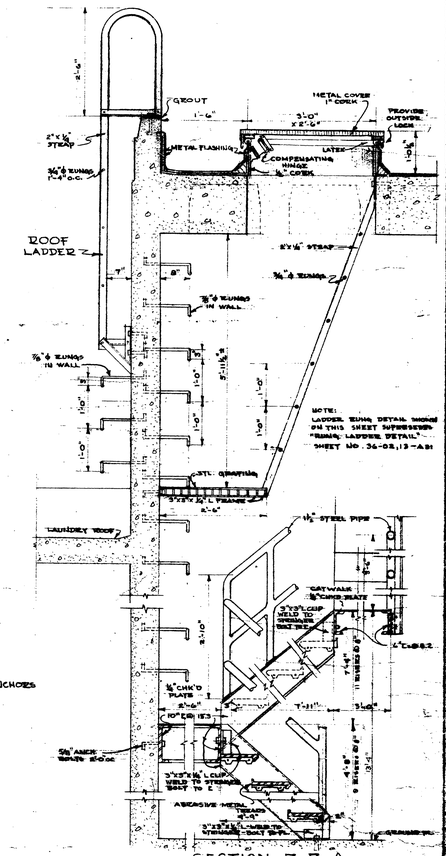

SECTION Z-Z

SCALE ¾" = 1'0"

NOTE:
LADDER RUNG DETAIL SHOWN ON THIS SHEET SUPERSEDES "RUNG, LADDER DETAIL" SHEET NO. 36-02,13-A31

PLAN

SCALE ¾" = 1'-0"

SCUTTLE, CATWALK & STAIRWAY DETAILS

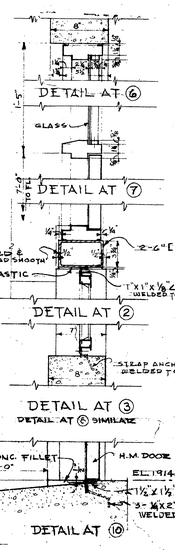

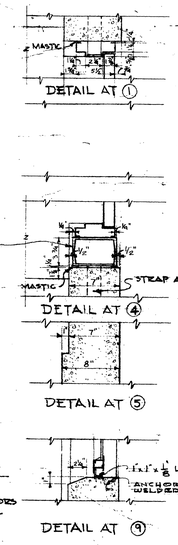

OFFICE ENTRANCE DETAILS

SCALE 1½" = 1'-0"

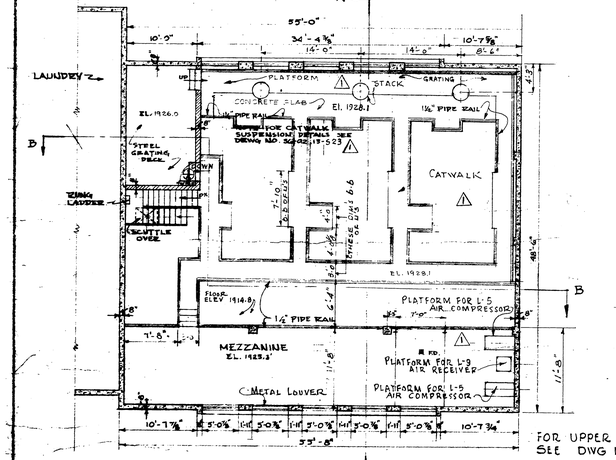

UPPER BOILER RM. PLAN

SCALE 1/8" = 1'-0"

FOR LOCATIONS OF CATWALKS & PLATFORMS SEE DRWG NO 36-02,13-523

FOR UPPER BOILER HOUSE DETAILS SEE DWG NO 36-02-13-523.

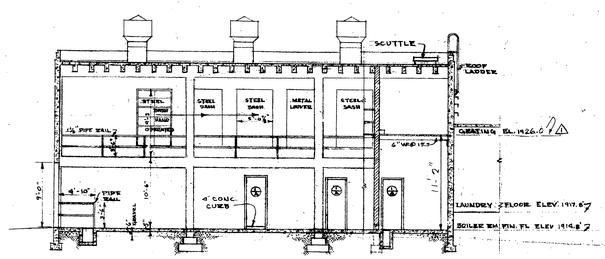

SECTION B-B

SCALE 1/8" = 1'-0"

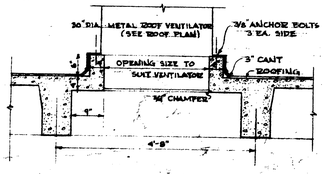

VENT. OPENING DET.

SCALE ¾"=1'-0"

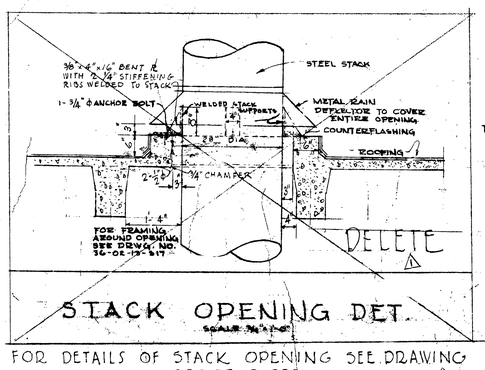

STACK OPENING DET.

SCALE ¾"=1'-0"

FOR DETAILS OF STACK OPENING SEE DRAWING 536-02, 13-522 ⚠

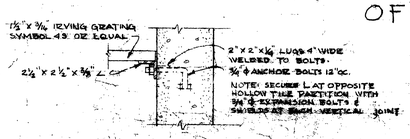

SEC. C-C

SCALE 1½"=1'-0"

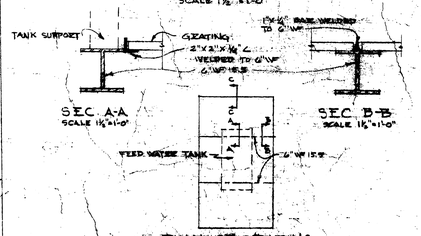

PLAN OF GRATING

NTS

STEEL GRATING DECK DETAIL

THIS SHEET SUPERSEDES DWG. NUMBER 36-02, 13-A38

3-2-1-1107

REVISION	DATE	DESCRIPTION	BY
	12-8-54	REVISED AS BUILT	

CORPS OF ENGINEERS, U.S. ARMY
OFFICE OF THE DISTRICT ENGINEER
SEATTLE, WASHINGTON

DRAWN BY: L.M.F.C.
TRACED BY:
CHECKED BY: P.G.S.
PREPARED BY: [signature]
CHIEF DESIGN SECTION
SUBMITTED BY: [signature]
CHIEF ENGINEERING BRANCH
RECOMMENDED BY: [signature]
CHIEF, CONSTRUCTION DIV.
APPROVED: [signature]
DATE:
CHIEF OF ENGINEERS

VETERANS ADMINISTRATION HOSPITAL
SPOKANE, WASH.
200 BED ADD.
POWERHOUSE

SCALE: AS SHOWN | SPEC NO.
DRAWING NUMBER: 36-02, 13 - A 39
V. A. PROJECT NO. 2910
SHEET A 39 OF 39

RETURN TRACINGS TO PLAN FILES

CONTRACT DRAWING ORDER NO. 4

13

05 10

36 13 A39