


- АНЧ#1 -
АНЧ#2 -
АНЧ#3 -
АНЧ#4 -
АНЧ#5 -
АНЧ#6 -
АНЧ#7 -
АНЧ#13 -

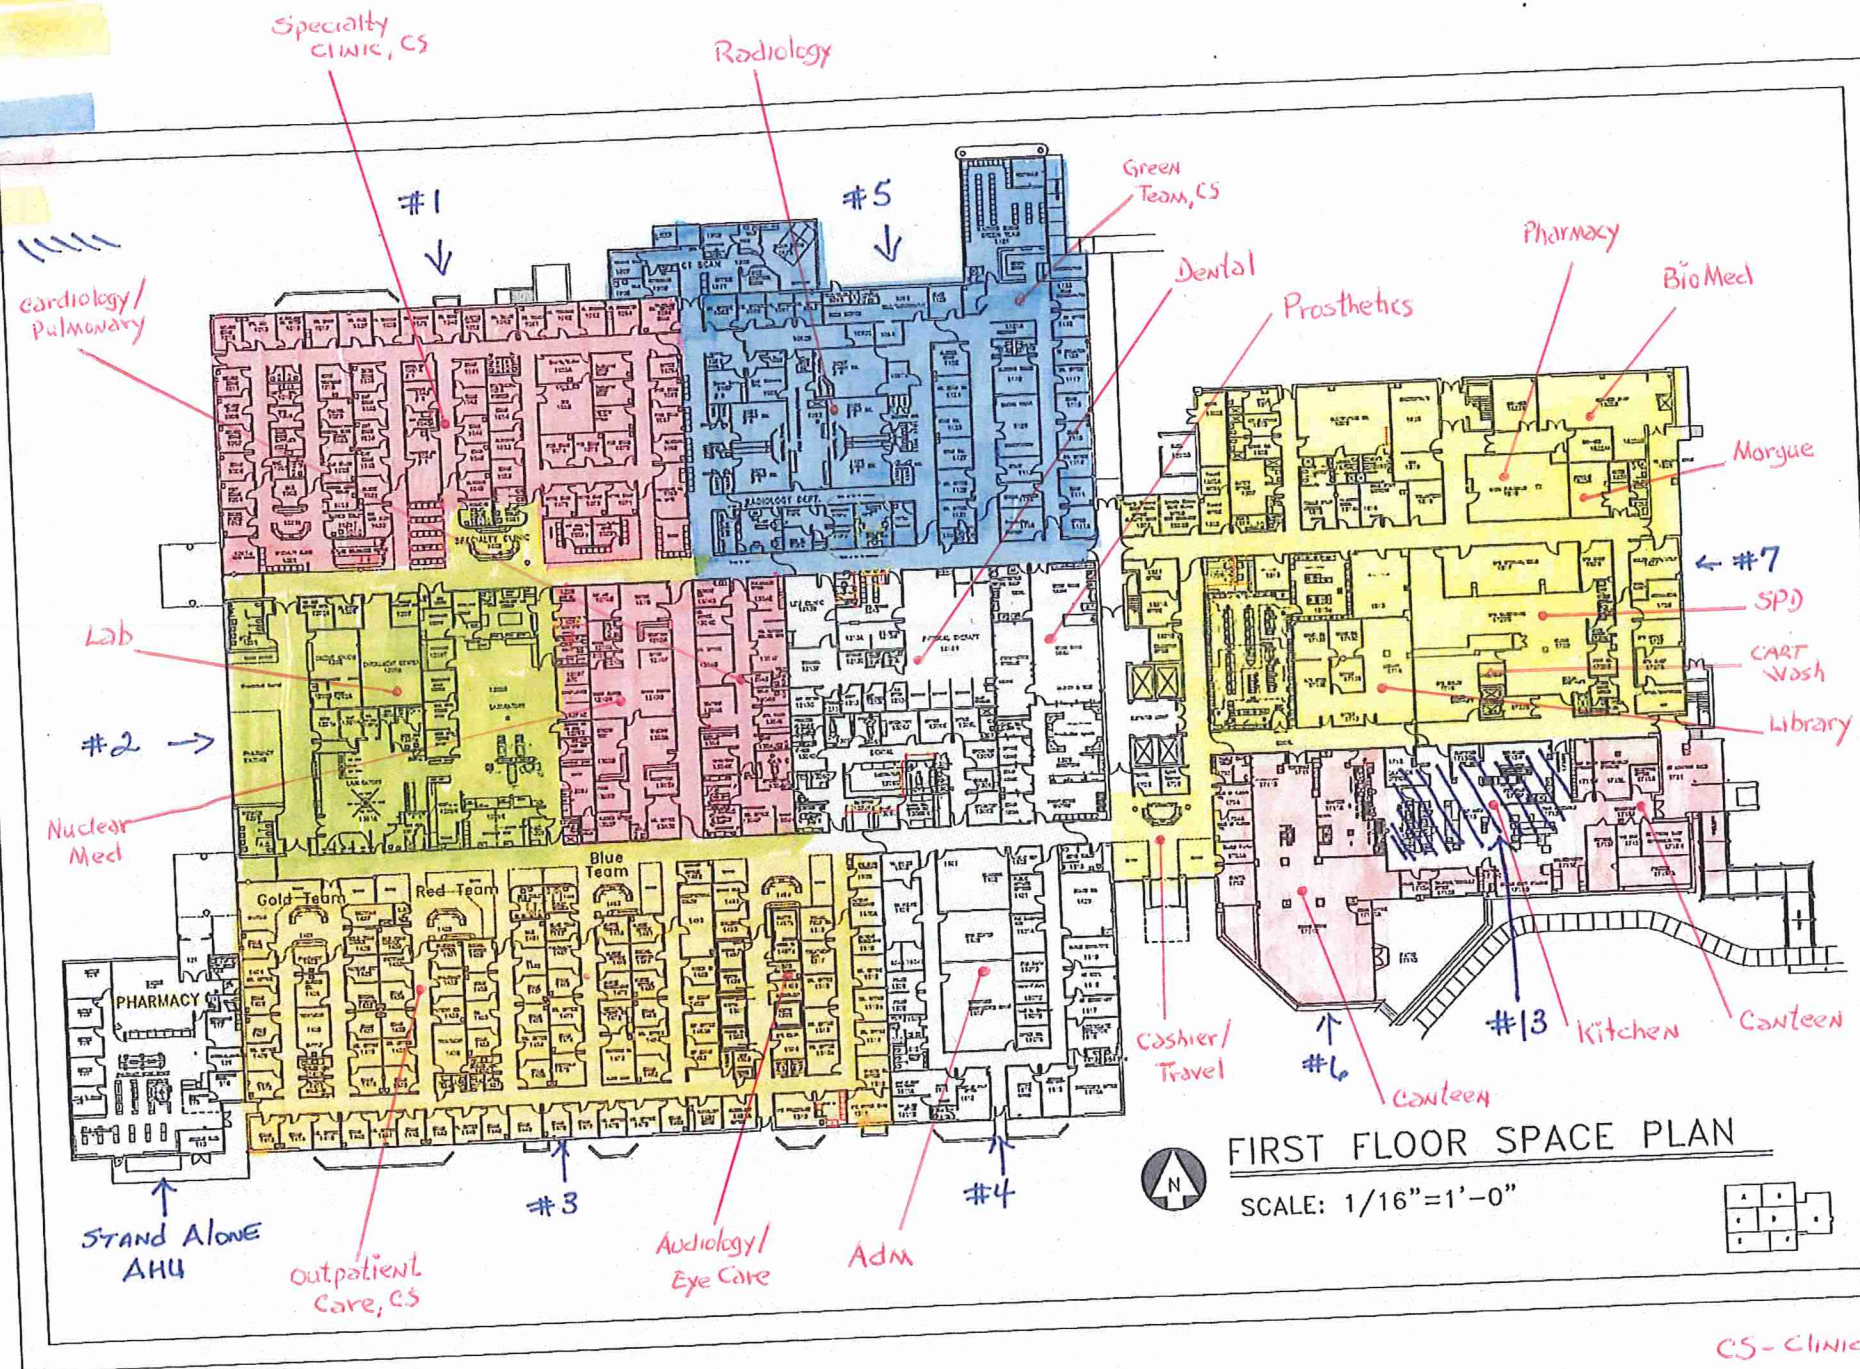

CS - Clinical Space