REVISIONS				
LET	DESCRIPTION	PREP'D BY	DATE	APPROVED
REV. A	DRWG. CORRECTED TO AS-BUILT	BROWN	11-14-80	CHASE

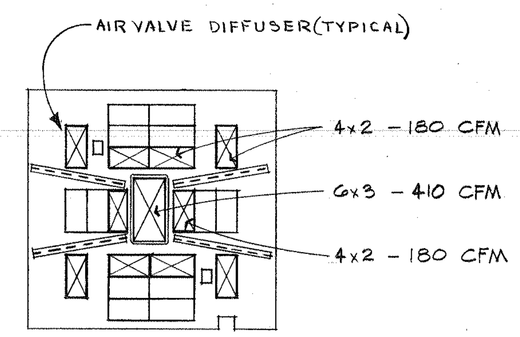

1 M53 OP RM (1) H2051
NOTE: FOR DIFF DETAIL SEE DETAIL 6 M60 ON NAVFAC DWG 5046891

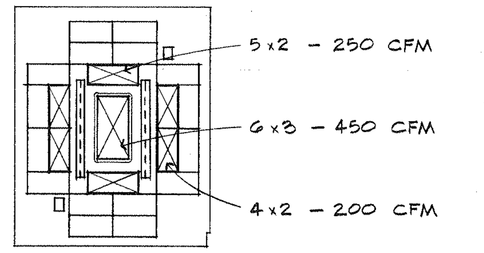

2 M53 OP RMS (2) H2053, (3) H2055, (4) H2057
NOTE: FOR DIFF DETAIL SEE DETAIL 6 M60 ON NAVFAC DWG 5046891

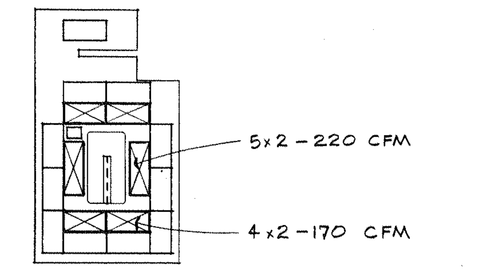

3 M53 CYSTO/IVP H2062
NOTE: FOR DIFF DETAIL SEE DETAIL 6 M60 ON NAVFAC DWG 5046891

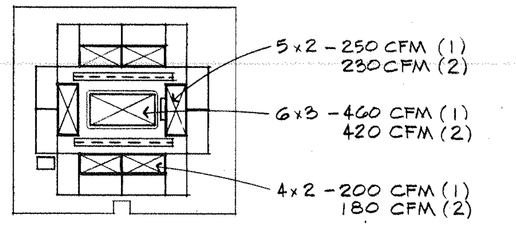

4 M53 DELIVERY ROOMS (1) H2078, (2) H2081
NOTE: FOR DIFF DETAIL SEE DETAIL 6 M60 ON NAVFAC DWG 5046891

NOTES:
1. FOR AREA 'J' DUCTWORK SEE NAVFAC DWG NO 5046875
2. IN RM H2021 RUN THE 8x4 EXH DUCT DN IN WALL TO A 6x6 EXH REG @ +1'-0" AFF
3. FOR ROOF PLAN OF AREA "H" SEE NAVFAC DWG 5046841

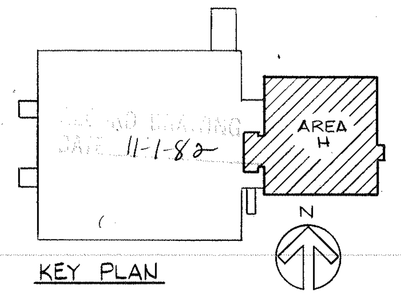

KEY PLAN

HVAC - SECOND FLOOR PLAN - AREA "H"

SCALE: 1/8" = 1'-0"

GRAPHIC SCALE 1/8" = 1'-0" 4' 0 5' 10' 15' 20'

ROGERS, LOVELOCK, FRITZ, ROGERS & BUTLER LOPATKA, McQUAIG & WALL CORPORATION ARCHITECTS - ENGINEERS - PLANNERS WINTER PARK, FLORIDA 32789	DEPARTMENT OF THE NAVY NAVAL FACILITIES ENGINEERING COMMAND SOUTHERN DIVISION CHARLESTON, S.C.
DSGN SEKAR DR BROWN CHK CHASE	NAVAL REGIONAL MEDICAL CENTER ORLANDO, FLORIDA
SUPV CHASE CH ENGR MARTEN	HOSPITAL REPLACEMENT
SUBMITTED BY DATE 28 FEB 77	
FIRM MEMBER (TITLE) PARTNER	
SOUTHERN DIV — DESIGN DIVISION PDE DIR	HVAC PLAN, AREA "H"
APPROVED DATE	SIZE F; CODE IDENT NO. 80091; NAVFAC DRAWING NO. 5046884
OFFICER IN CHARGE	CONSTR CONTR NO. N62467-75-C-0340
APPROVED DATE 3/21/77	SCALE AS SHOWN; SPEC 06-75-0340; SHEET 293 OF
EFD FOR COMMANDER, NAVFAC	

M53

7-16-80 AS-BUILT