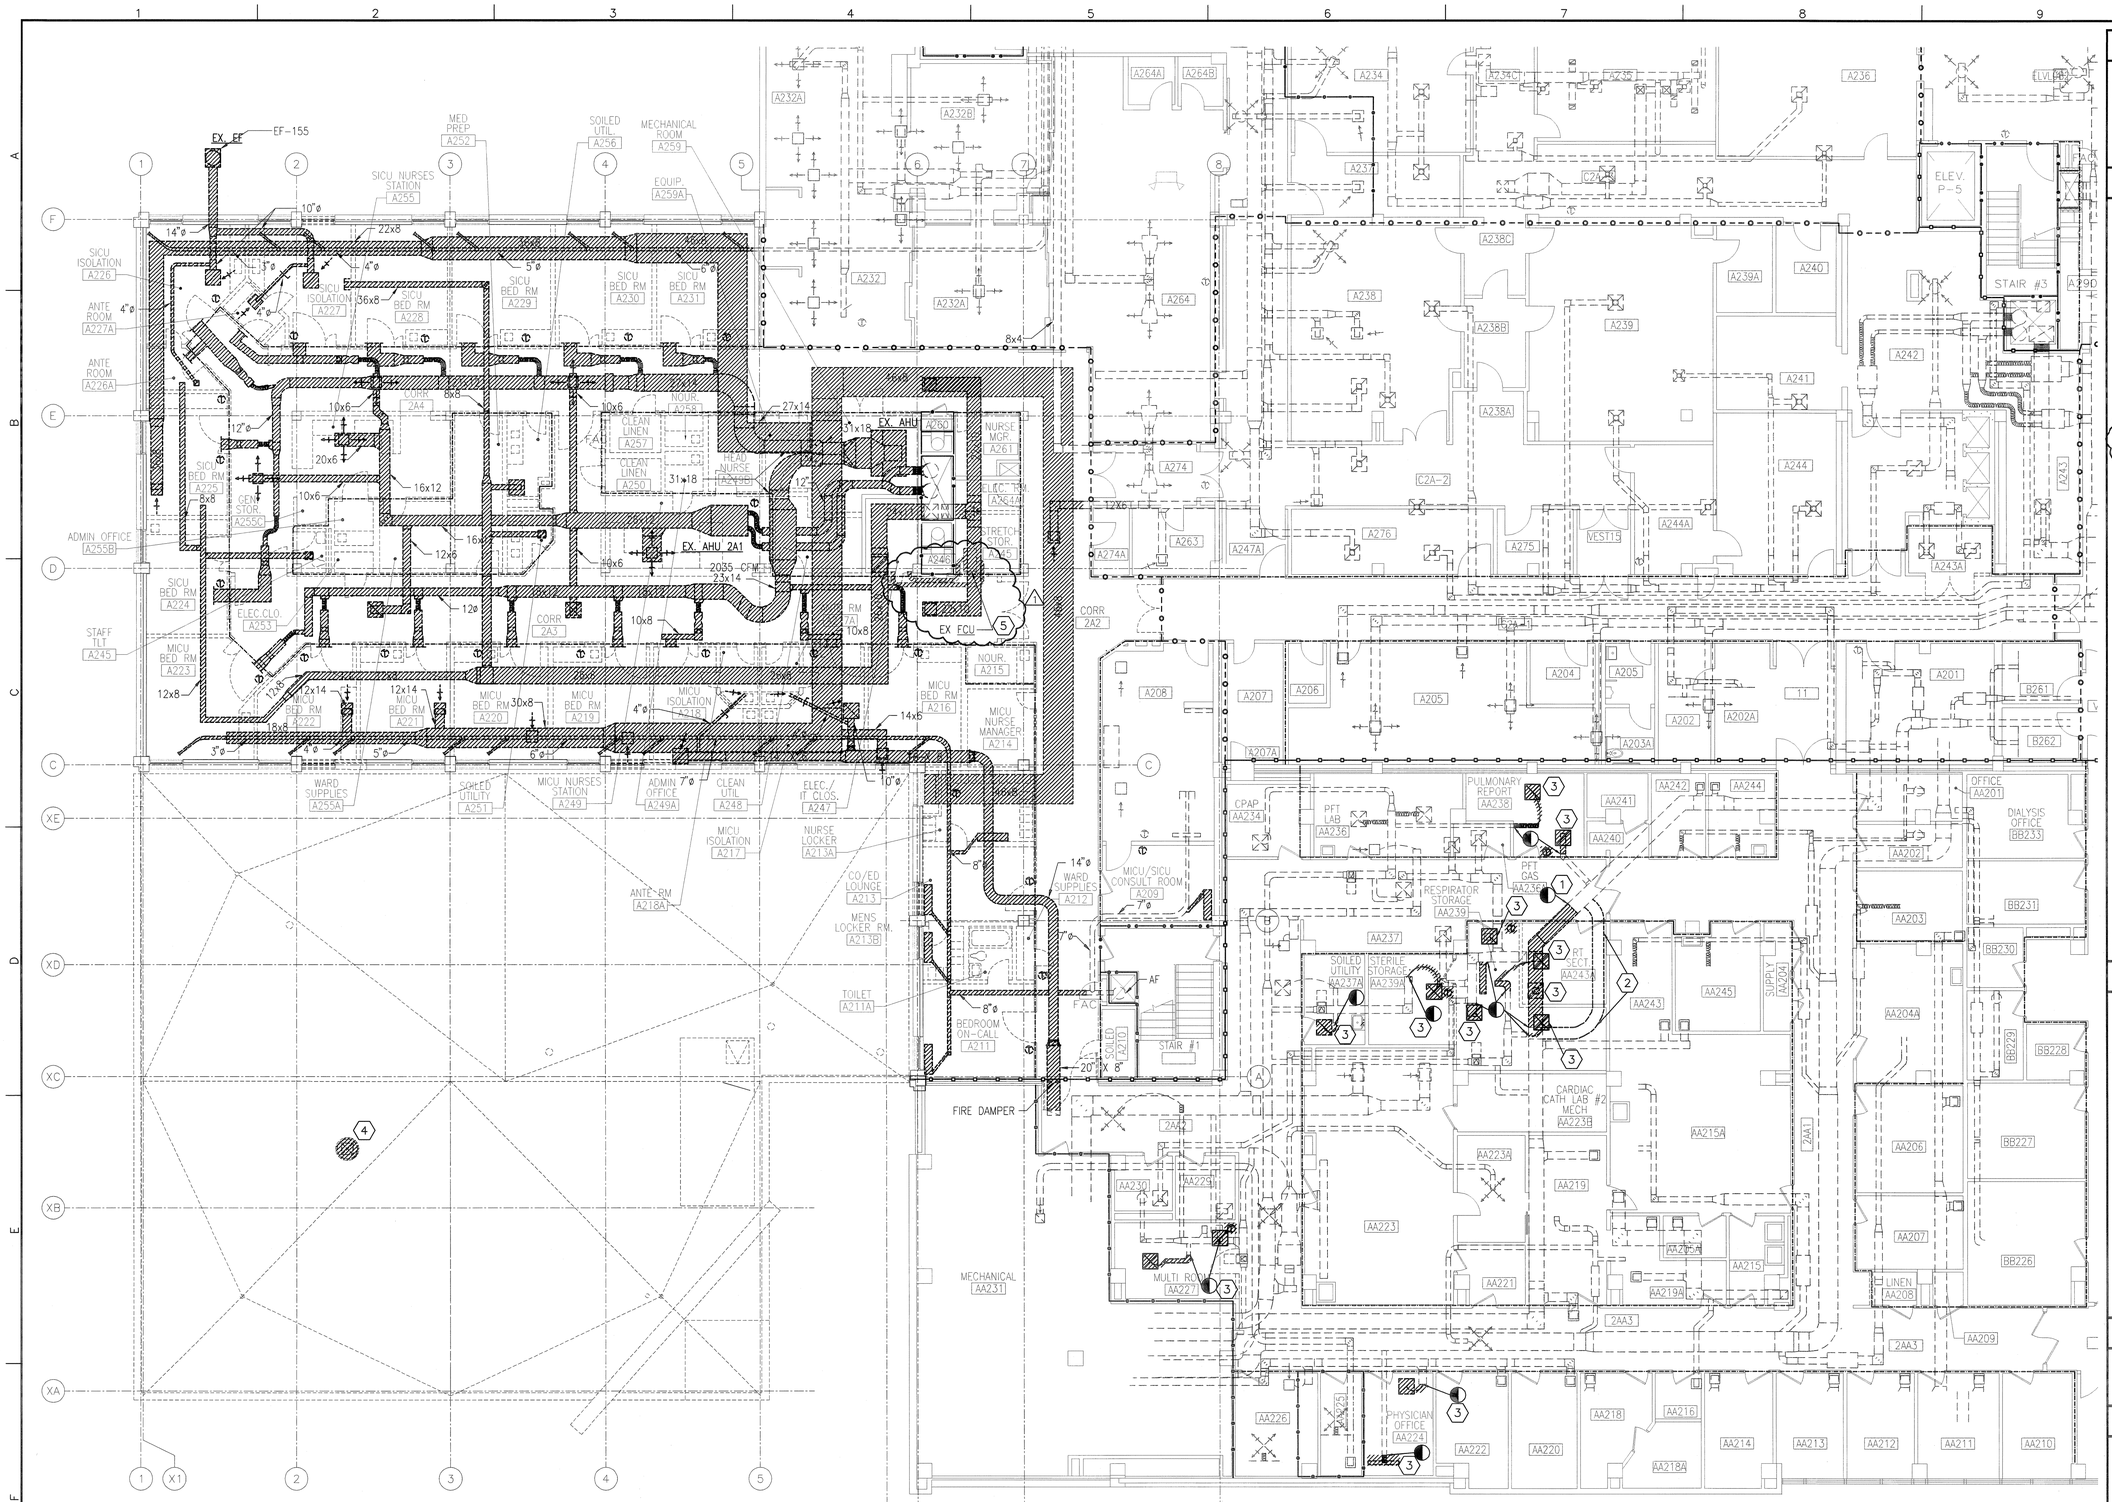

F1 SECOND FLOOR DUCTWORK DEMOLITION PLAN

SCALE: 1/8" = 1'-0"

GENERAL SHEET NOTES

A. REFER TO H-001 FOR TYPICAL SYMBOLS AND ABBREVIATIONS USED ON THIS DRAWING.

B. REFER TO H-052 SERIES SHEETS FOR PHASING OF WORK.

SHEET KEYNOTES

1. DEMOLISH DUCTWORK AS SHOWN. SEE SHEET H-102.C FOR NEW WORK IN THIS AREA.
2. INSTALL TEMPORARY 18"ø FLEX DUCT PRIOR TO DEMOLITION TO ALLOW SYSTEM TO REMAIN OPERATIONAL. AFTER NEW CONNECTION IS MADE AS SHOWN ON H-102.C, REMOVE TEMPORARY DUCT AND REPAIR DUCT WITH INSULATED CAP.
3. DEMOLISH EXISTING DIFFUSER/GRILLE AND ASSOCIATED FLEXIBLE DUCT. PATCH, SEAL AND RE-INSULATE DUCT. SEE H-102.C FOR NEW WORK.
4. DEMOLISH EXISTING EXHAUST FAN SERVING KITCHEN HOOD BELOW. SEE H-011 FOR CONTINUATION OF DUCT BELOW.
5. RELOCATE EXISTING FCU TO I.T. ROOM A247 AND RENAME TO 1-FCU2. SEE H-102.A AND H-112.A FOR NEW WORK. DEMOLISH DUCTWORK.

BARRIER / WALL LEGEND

REFER TO SHEET PD-102 FOR REQUIRED RATINGS

- EXISTING ELEMENT TO BE REMOVED
- EXISTING ELEMENT TO REMAIN
- NEW PARTITION / BARRIER / WALL
- SMOKE-RESISTIVE WALL
- 1-HOUR RATED FIRE BARRIER
- 2-HOUR RATED FIRE BARRIER
- 1-HOUR RATED FIRE SMOKE BARRIER
- 2-HOUR RATED FIRE SMOKE BARRIER
- HATCHING INDICATES AREAS OUTSIDE PRIMARY PROJECT LIMITS. SOME ACCESSORY WORK WILL OCCUR IN SHADED AREAS. REFER TO ALL DISCIPLINE DRAWINGS FOR COMPLETE SCOPE.
- CONCRETE SHEAR WALL

COORDINATION DRAWINGS

SEE COVER SHEET FOR COORDINATION NOTES.

KEYPLAN

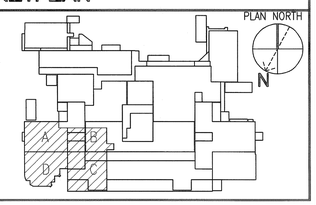

REVISION NO.	REVISION DESCRIPTION	
1	CLARIFICATION #1	7/20/2015
Revisions		By Date

Department of Veterans Affairs
Ralph H Johnson VA Medical Center
109 Bee Street
Charleston, SC 29401

SEAL

Architect/Engineer Address
HARRELL
• DESIGN GROUP, PC •
formerly HARRELL, SALTRICK & HOPPER, PC
8016 TOWER POINT DRIVE CHARLOTTE, NC 28227
P 704.814.1320 F 704.321.0833
WWW.HARRELLDG.COM

COPYRIGHT © 2014 HARRELL DESIGN GROUP, PC

HDG PROJECT # 13026

Recommended Approvals:	
1. CHIEF, ENGINEERING SERVICE	
2. PROJECT MANAGER	

Drawing Title: SECOND FLOOR DUCTWORK DEMOLITION PLAN

Project Title: EXPAND/REPAIR INTENSIVE CARE UNIT, STEP DOWN UNIT, AND PULMONARY

Date: 05/29/2015

Project Number: 534-325

BUILDING IS FULLY SPRINKLERED

CONSTRUCTION DOCUMENTS

Drawn	Building Number	AutoCAD File Name	DRAWING No.
DJB	1		H-012

Checked	Reviewed	Const. Contract No.
DTB	WSP	

Veterans Affairs