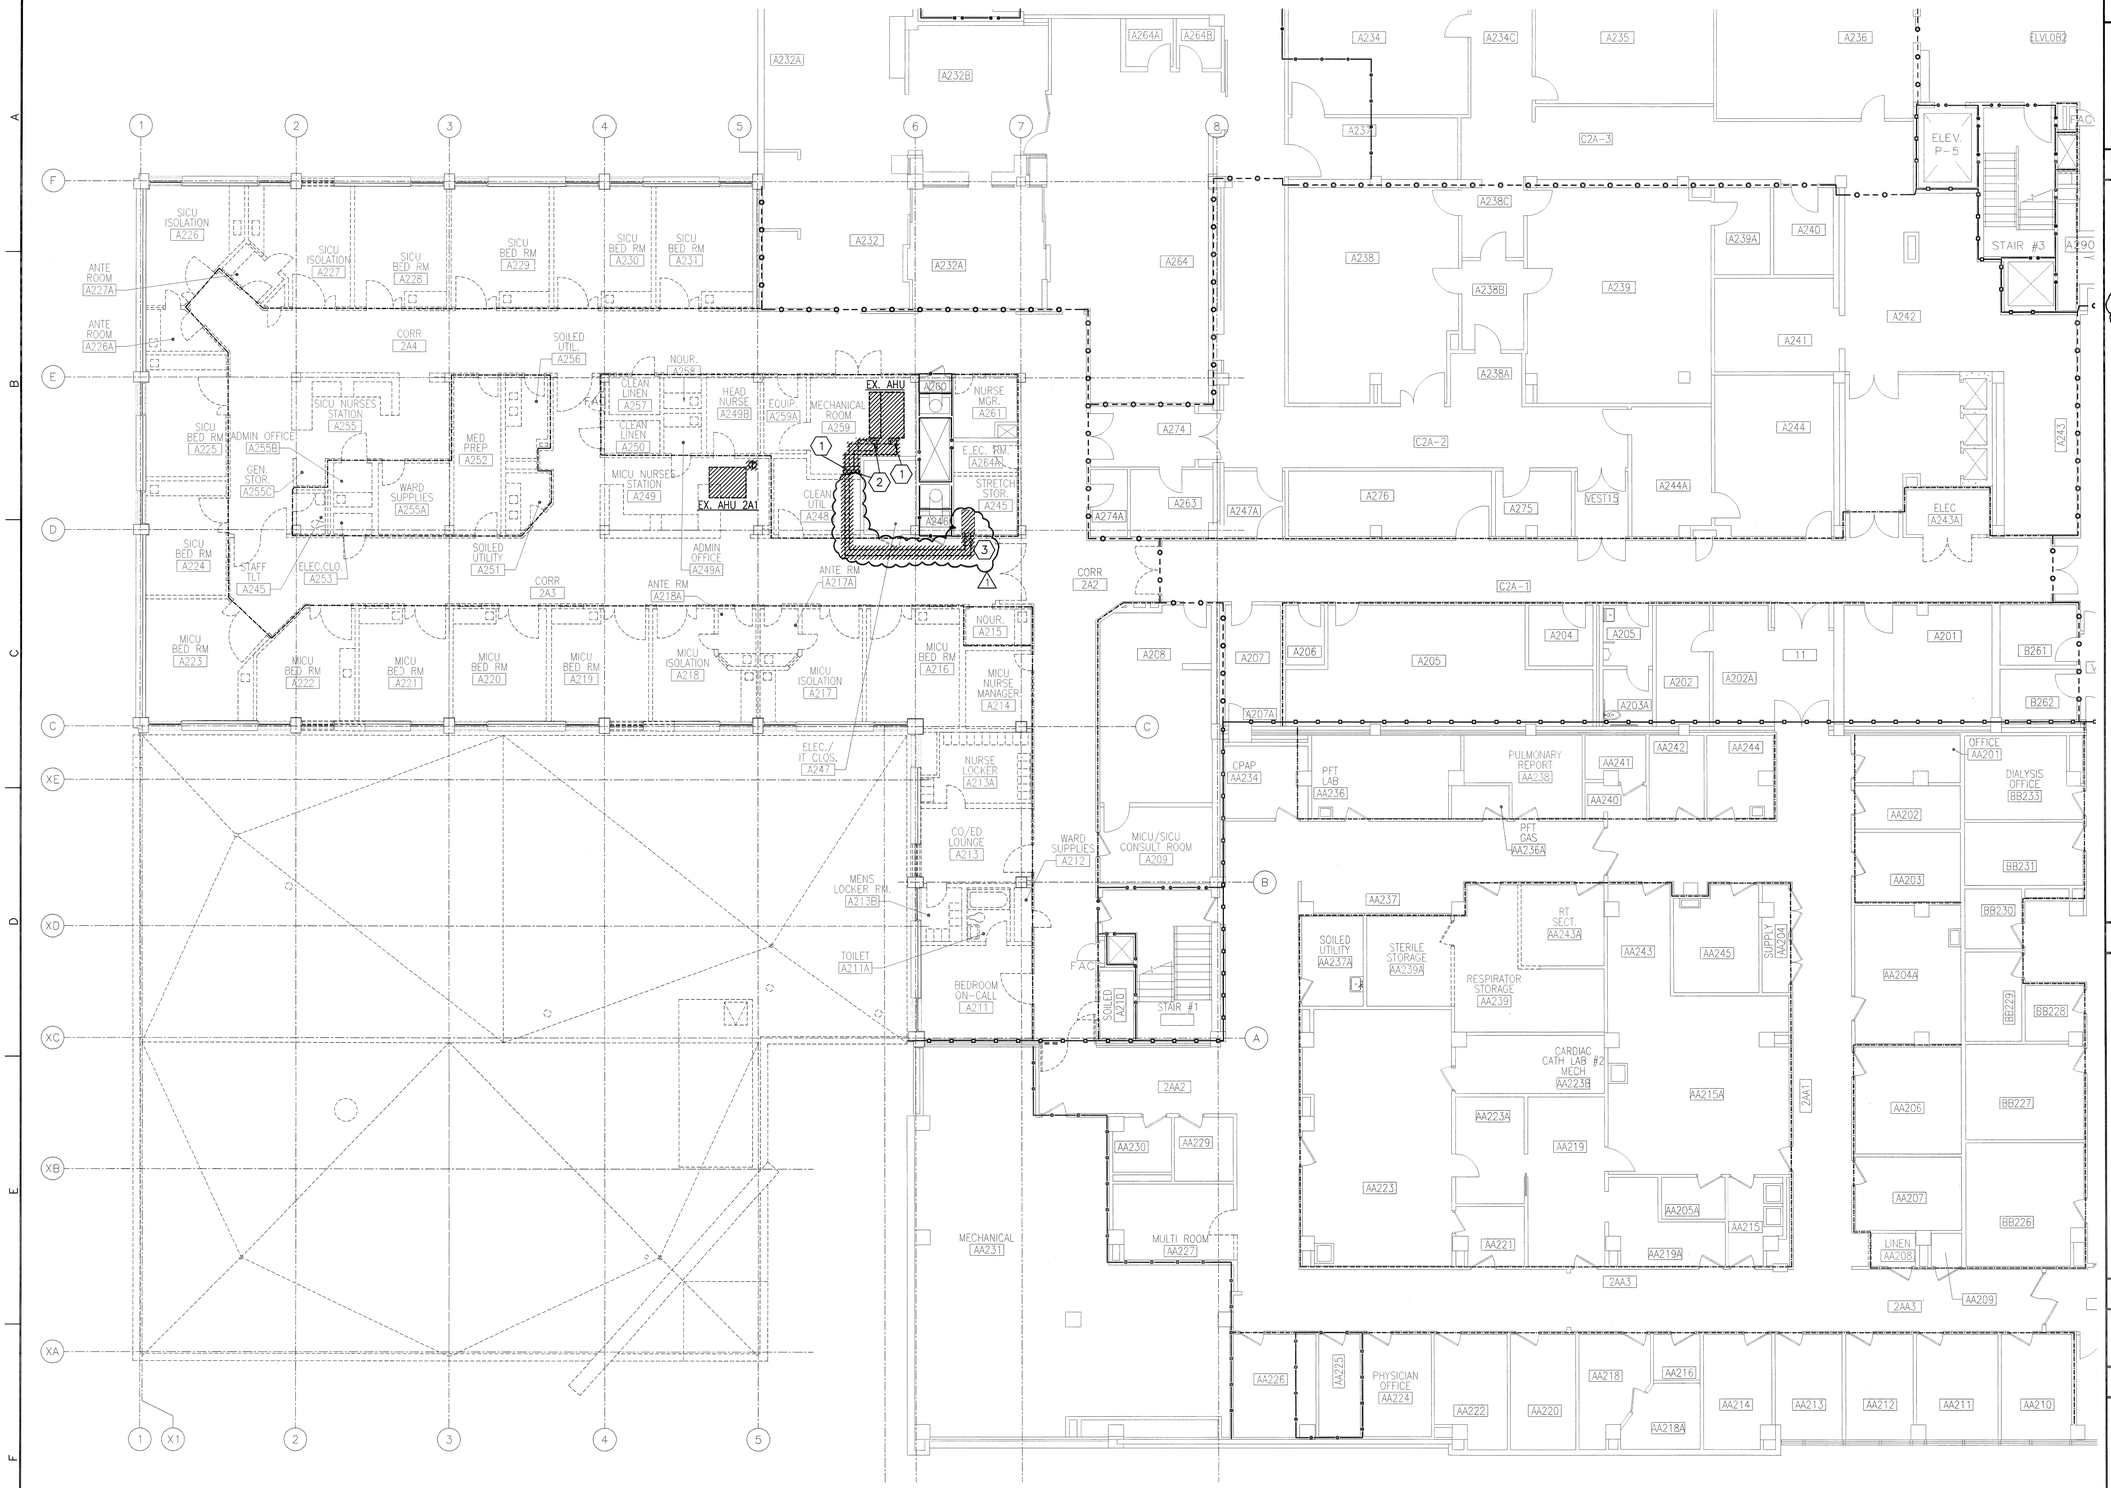

F1 SECOND FLOOR PIPING DEMOLITION PLAN

SCALE: 1/8" = 1'-0"

GENERAL SHEET NOTES

A. REFER TO H-001 FOR TYPICAL SYMBOLS AND ABBREVIATIONS USED ON THIS DRAWING.

B. REFER TO PIPING QUADRANT PLANS FOR NEW WORK IN THIS AREA.

C. REFER TO H-052 SERIES SHEETS FOR PHASING OF WORK.

SHEET KEYNOTES

1. DEMOLISH 1-1/2" CHS AND 1-1/2" CHR PIPING FROM FIRST FLOOR TO EXISTING AIR HANDLER. SEE H-101.A FOR NEW CONNECTION AT THIS PIPE.
2. DEMOLISH 1" MPS AND 1" MPR PIPING FROM FIRST FLOOR TO EXISTING AIR HANDLER. CAP PIPE IN FIRST FLOOR CEILING.
3. RELOCATE EXISTING FCU TO I.T. ROOM A247 AND RENAME TO 1-FCU2. SEE H-102.A AND H-112.A FOR NEW WORK. DEMOLISH DUCTWORK.

BARRIER / WALL LEGEND

REFER TO SHEET PD-102 FOR REQUIRED RATINGS

- EXISTING ELEMENT TO BE REMOVED
- EXISTING ELEMENT TO REMAIN
- NEW PARTITION / BARRIER / WALL
- SMOKE-RESISTIVE WALL
- 1-HOUR RATED FIRE BARRIER
- 2-HOUR RATED FIRE BARRIER
- 1-HOUR RATED FIRE SMOKE BARRIER
- 2-HOUR RATED FIRE SMOKE BARRIER
- HATCHING INDICATES AREAS OUTSIDE PRIMARY PROJECT LIMITS. SOME ACCESSORY WORK WILL OCCUR IN SHADED AREAS. REFER TO ALL DISCIPLINE DRAWINGS FOR COMPLETE SCOPE.
- CONCRETE SHEAR WALL

COORDINATION DRAWINGS

SEE COVER SHEET FOR COORDINATION NOTES.

KEYPLAN

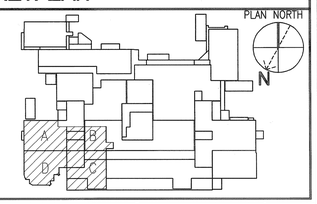

REVISION NO.	REVISION DESCRIPTION	
1	CLARIFICATION #1	7/20/2015
Revisions		By Date

Department of Veterans Affairs
Ralph H Johnson VA Medical Center
109 Bee Street
Charleston, SC 29401

SEAL

Architect/Engineer Address
HARRELL
• DESIGN GROUP, PC •
formerly HARRELL, SALTRICK & HOPPER, PC
8056 TOWER POINT DRIVE CHARLOTTE, NC 28227
P 704.814.1320 F 704.321.0833
WWW.HARRELLDG.COM
COPYRIGHT © 2014 HARRELL DESIGN GROUP, PC
HDG PROJECT # 13026

Recommended Approvals:	
1. CHIEF, ENGINEERING SERVICE	
2. PROJECT MANAGER	

Drawing Title: SECOND FLOOR PIPING DEMOLITION PLAN
BUILDING IS FULLY SPRINKLERED
CONSTRUCTION DOCUMENTS

Project Title: EXPAND/REPAIR INTENSIVE CARE UNIT, STEP DOWN UNIT, AND PULMONARY

Date: 05/29/2015
Project Number: 534-325

Drawn	Building Number	AutoCAD File Name
DJB	1	
Checked: DJB	Reviewed: WCP	Const. Contract No.

DRAWING No. H-013

Veterans Affairs