



- Smoking permitted in parking lots 35 feet from walkways.
- Patient Smoking
- Staff Smoking
- Combined Patient/Staff Smoking
- Construction Area

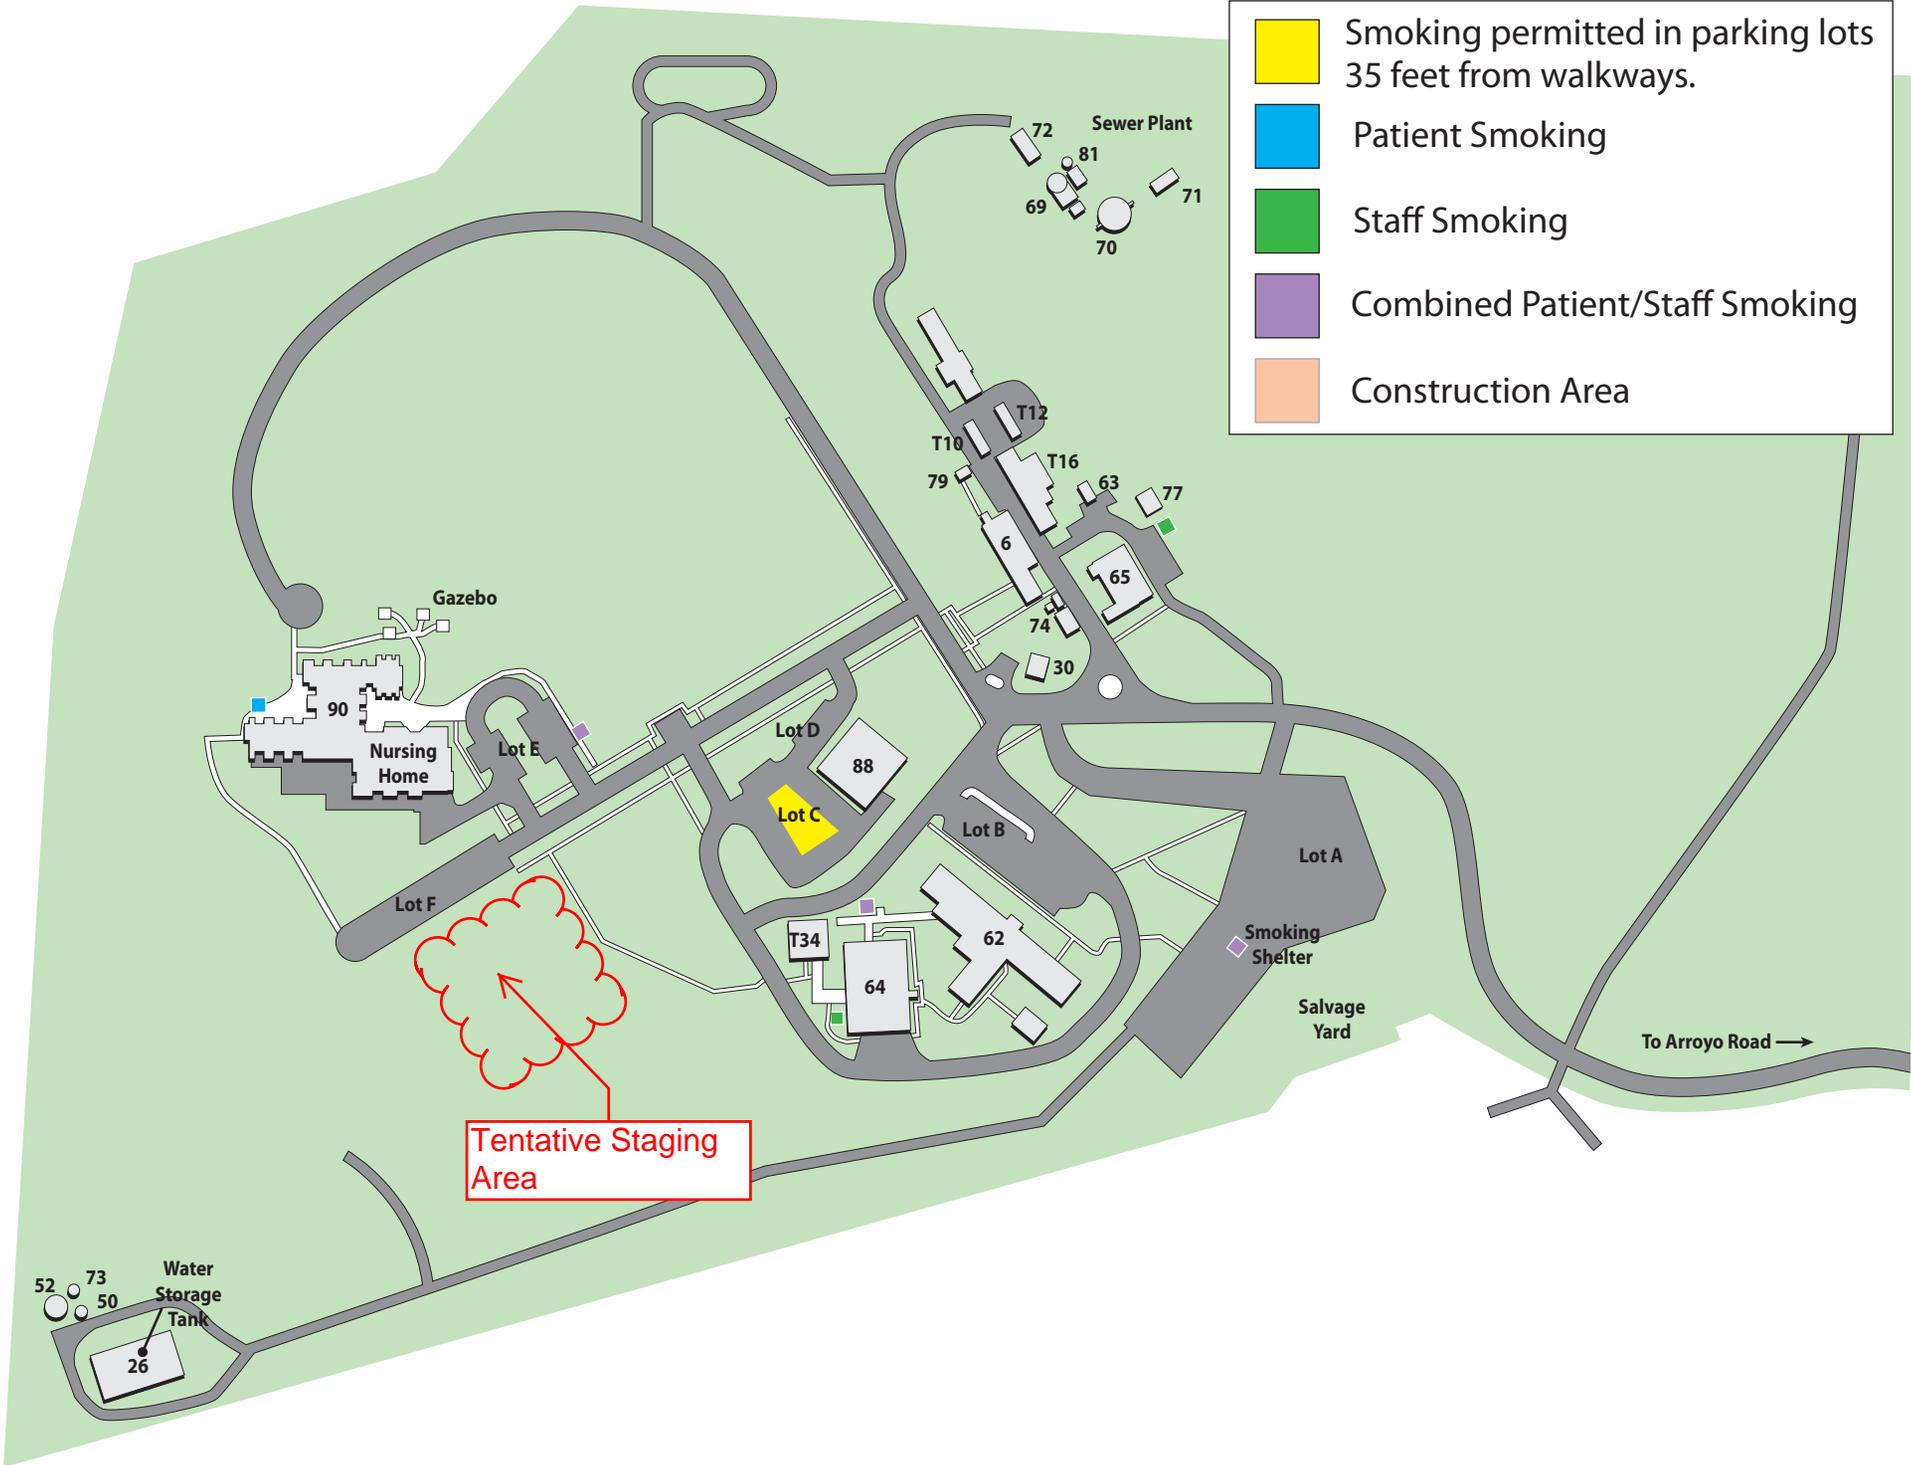

Tentative Staging Area

three inches = one foot
 one and one half inches = one foot
 one inch = one foot
 three quarters inch = one foot
 one half inch = one foot
 three eighths inch = one foot
 one quarter inch = one foot
 one eighth inch = one foot
 one sixteenth inch = one foot

S:\Engineering\PROJECTS\CAO_Files\Temp_RTL\LD\Engineering_Provided\140212_BU B_090\640.000000.090.LD\Architectural_floor_plan.01.dwg 2-12-14 10:34:08 AM vnapalst

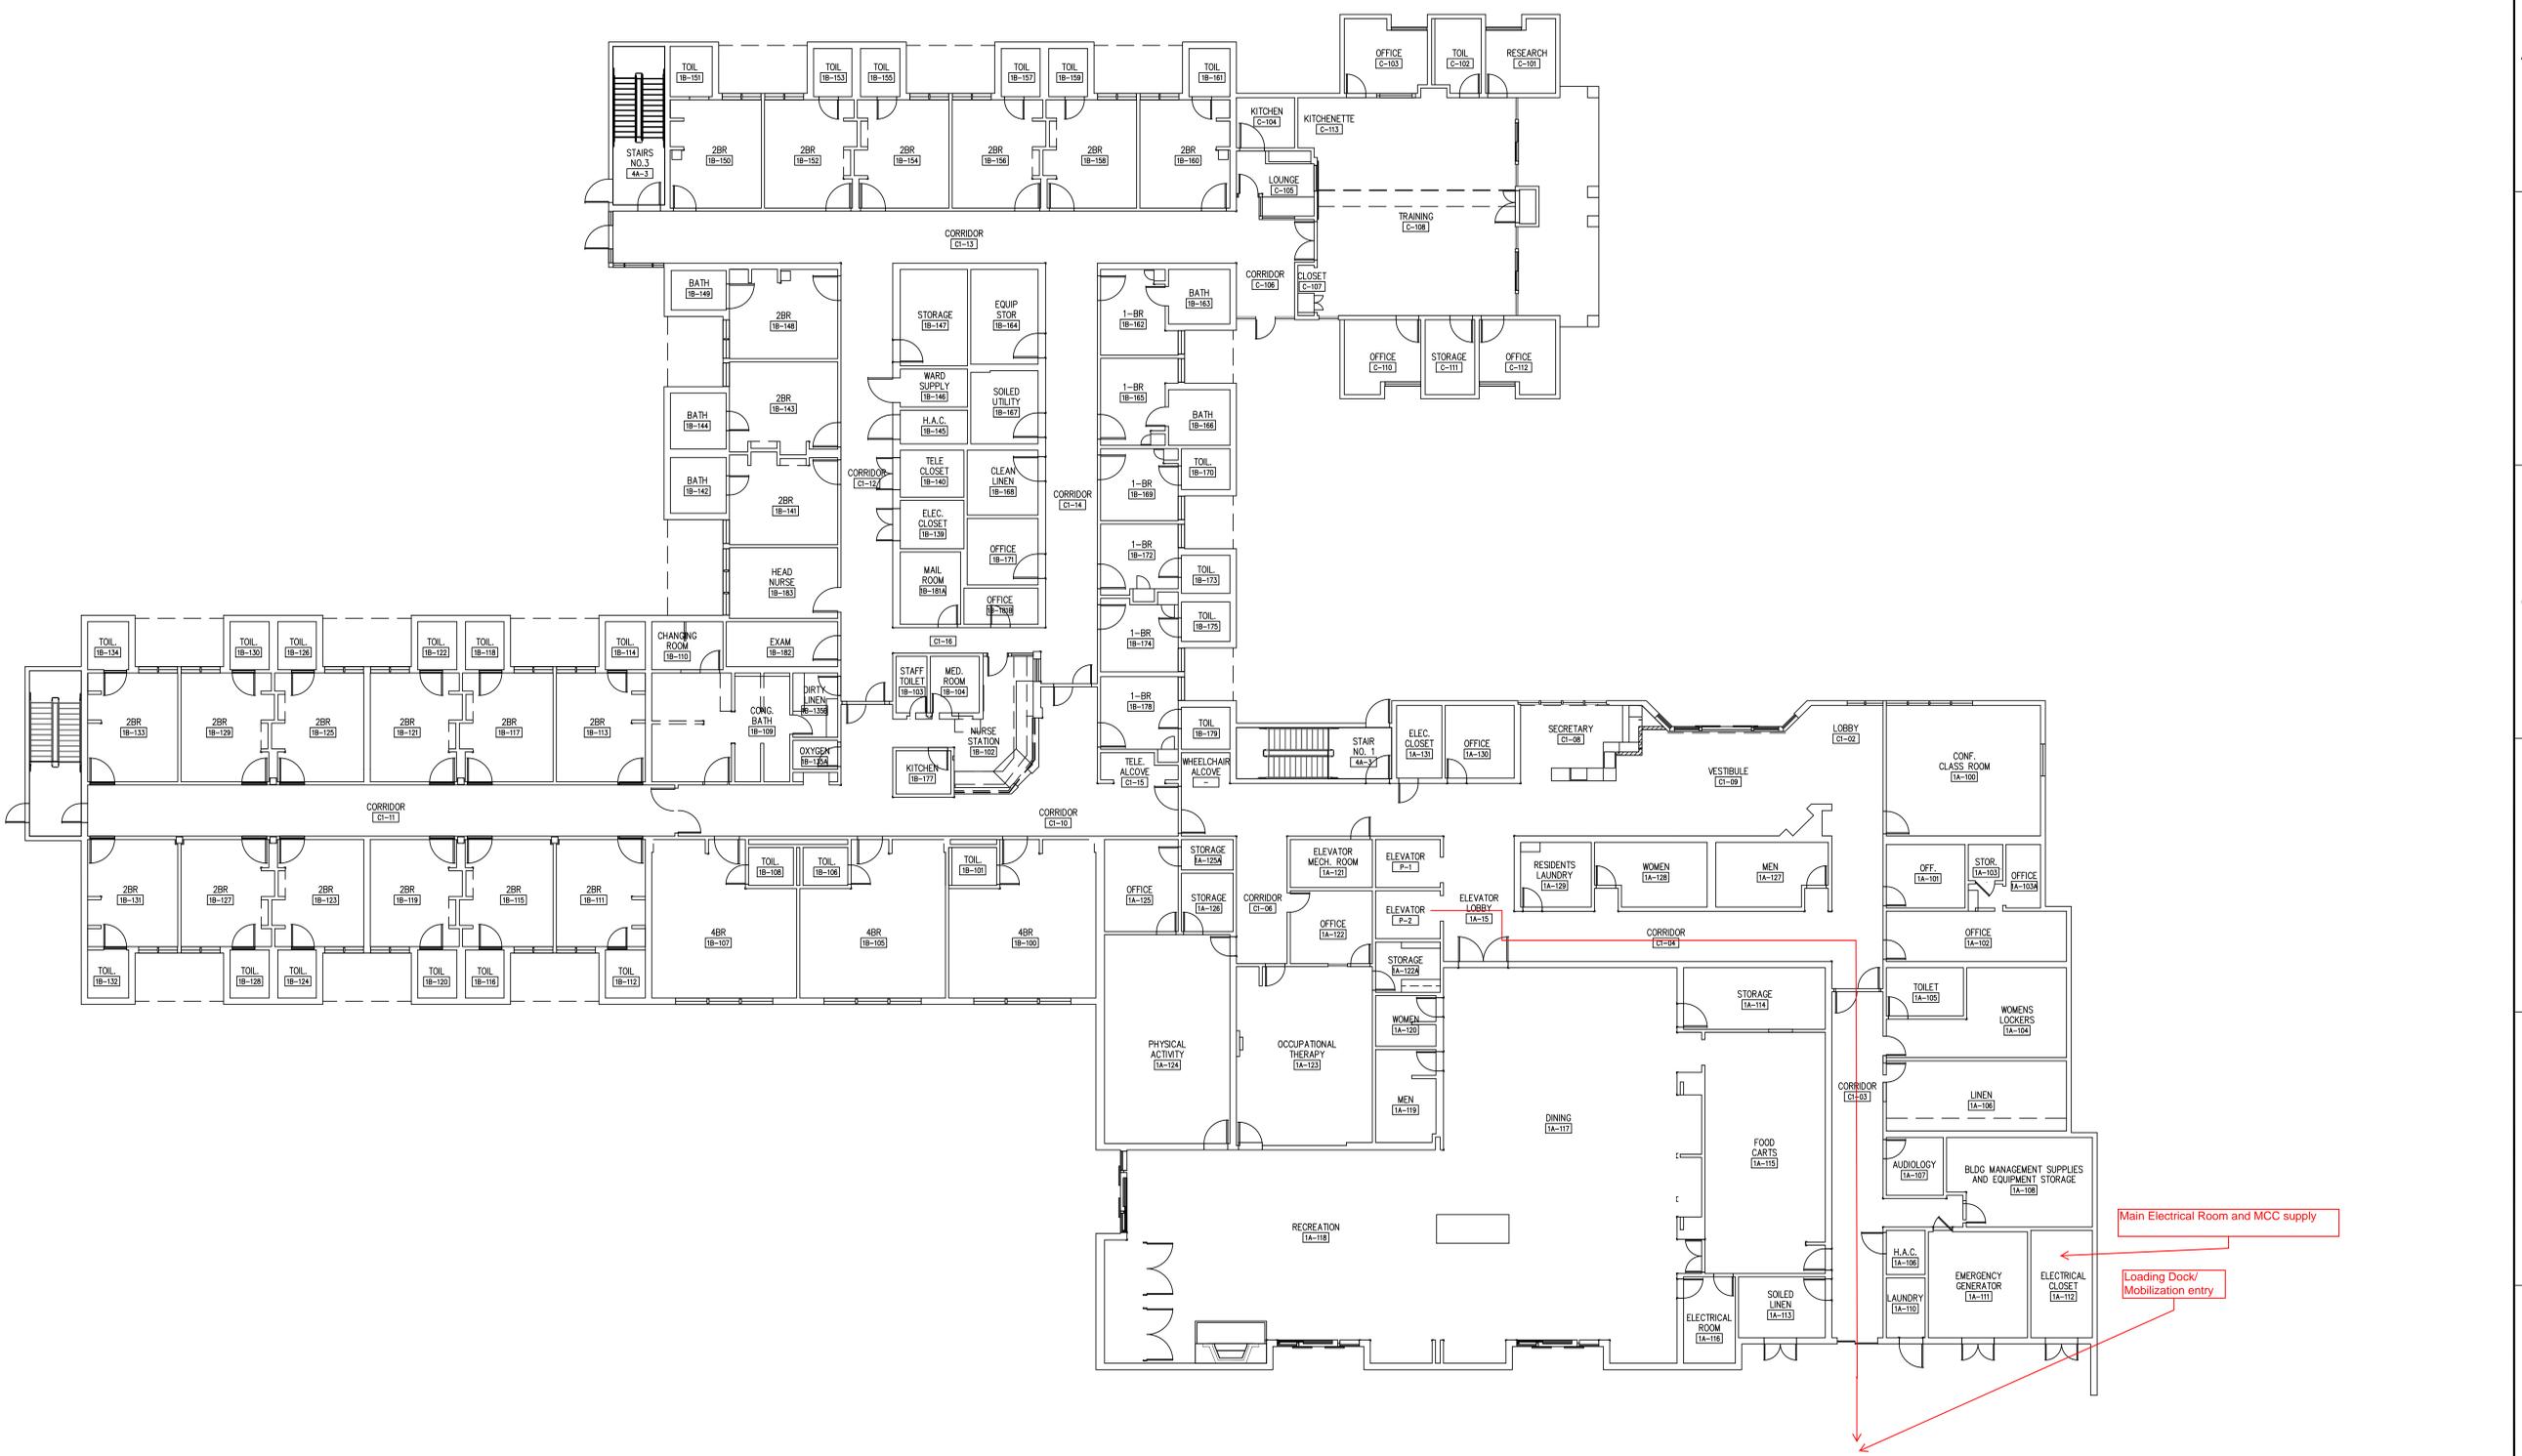

FOR REFERENCE ONLY - NOT FIELD VERIFIED

Scale: 3/32" = 1'-0"

CONSULTANTS: 		ARCHITECT/ENGINEERS: 		Drawing Title FIRST FLOOR ARCHITECTURE PLAN Approved Project Director VAPAHCS PLANNING AND ENGINEERING		Project Title COMMUNITY LIVING CEN. FOR REFERENCE ONLY (NOT FIELD VERIFIED)		Project Number 000000 Building Number 090		Office of Construction and Facilities Management Department of Veterans Affairs	
Revisions Date						Location LVD LIVERMORE CA.		Drawing Number -			
						Date 2010/06/03		Checked JR		Drawn KR	
								Dwg. -- of --			

