


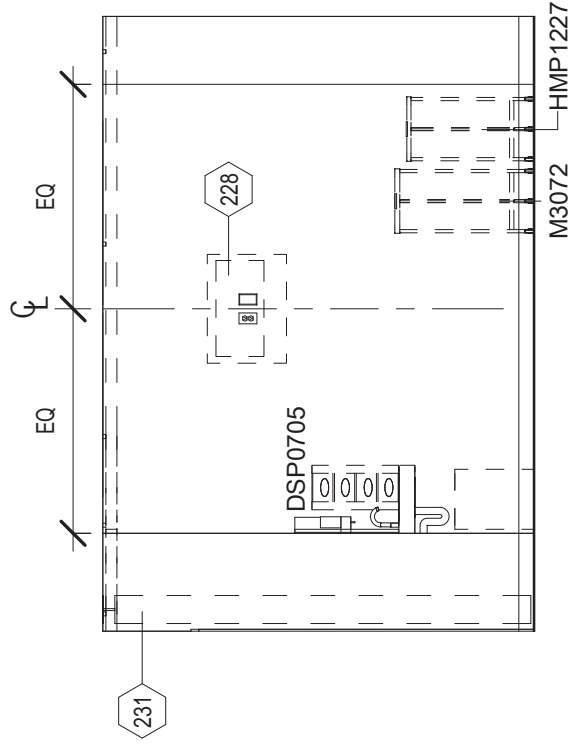

SCALE: 1/4" = 1'-0"




B2

BED STATION ISO 4C134_E

SCALE: 1/4" = 1'-0"



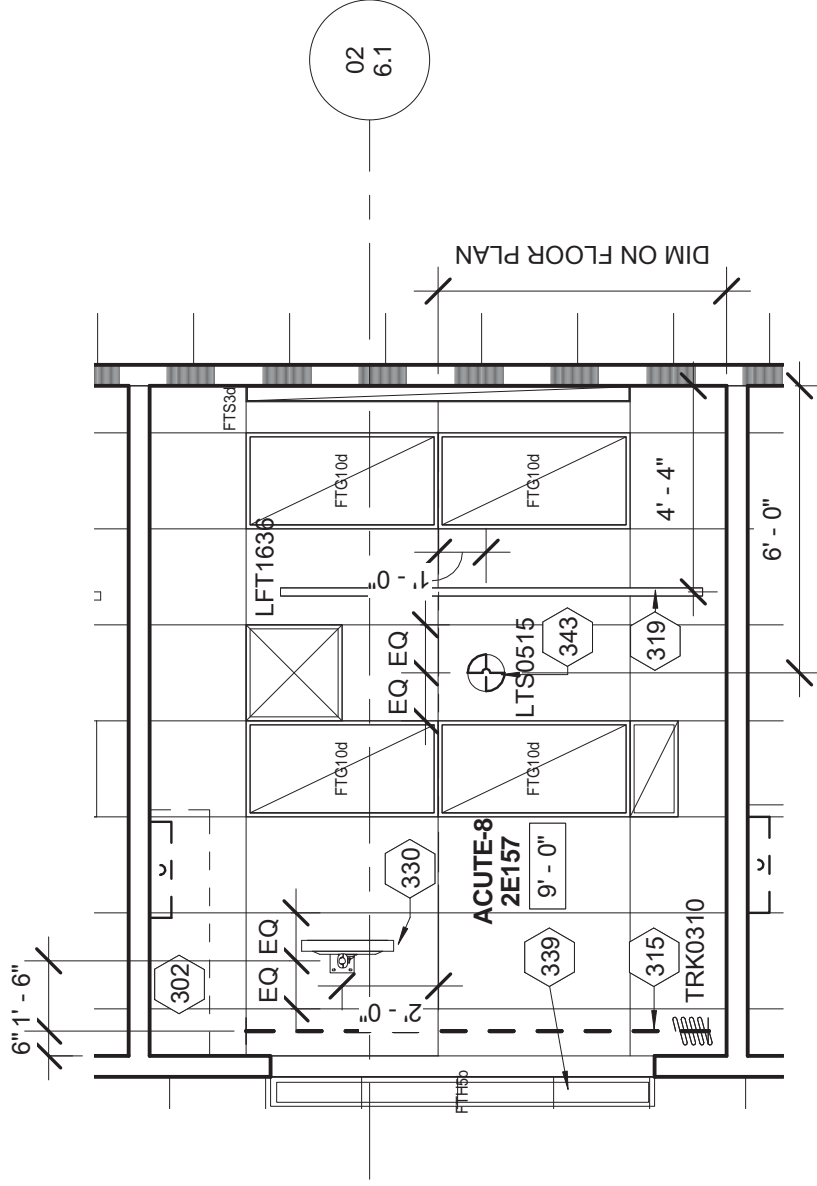


D6

ACUTE-8 2E157 RCP

SCALE: 1/4" = 1'-0"



SCALE: 1/4" = 1'-0"

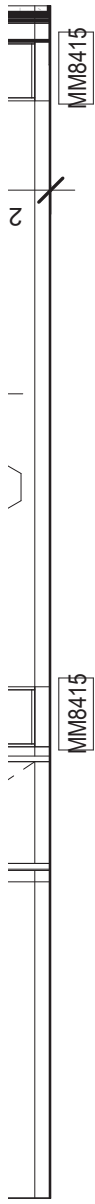

E3

SEMI-PVT PATIENT RM 5D149-W

SCALE: 1/4" = 1'-0"

E2


SEMI-PVT PATIENT RM 5D149-N

SCALE: 1/4" = 1'-0"

MM8415

MM8415

MOVABLE PARTITION
ENCLOSURE

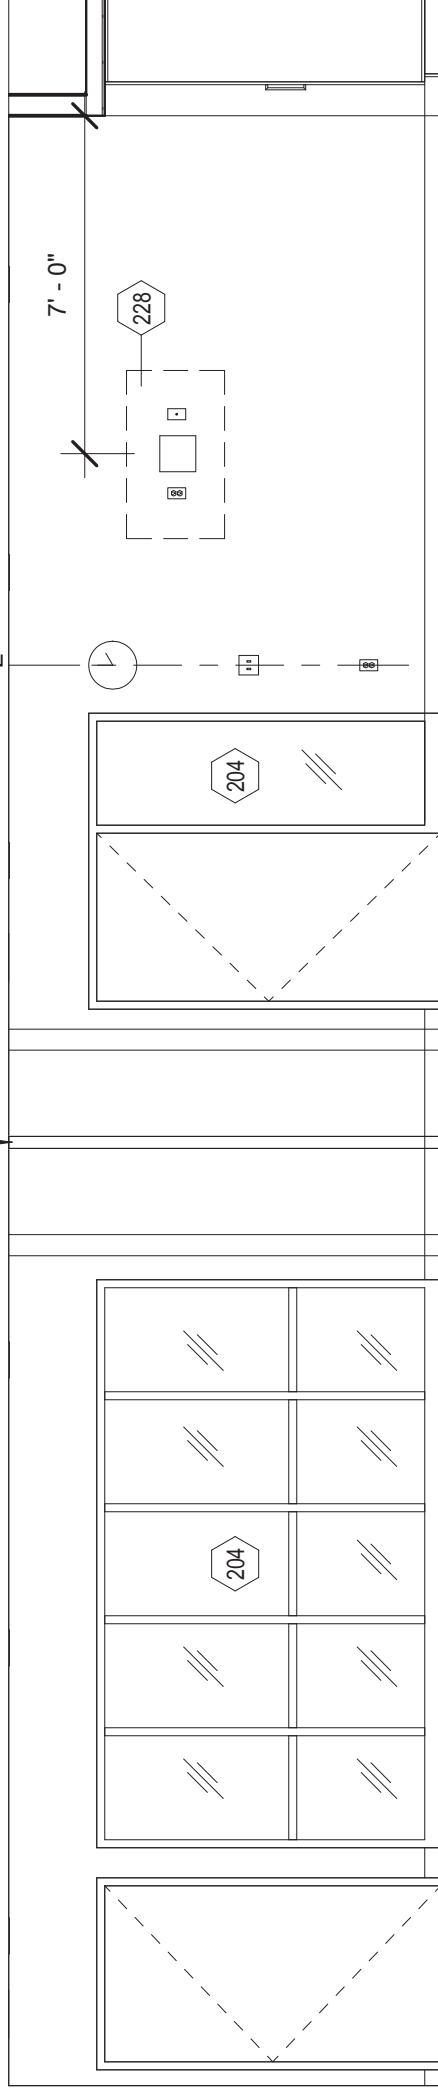

F3

DAY ROOM 5D122 / DINING 5D120B-N

SCALE: 1/4" = 1'-0"

DRAWING TITLE


BLDG 2 FIFTH FLOOR ENLARGED VIEWS

PROJECT TITLE

SLVHCS REPLACEMENT MED
CENTER PROJECT

E6 DAY ROOM 5D122 / DINING 5D120B-E

SCALE: 1/4" = 1'-0"

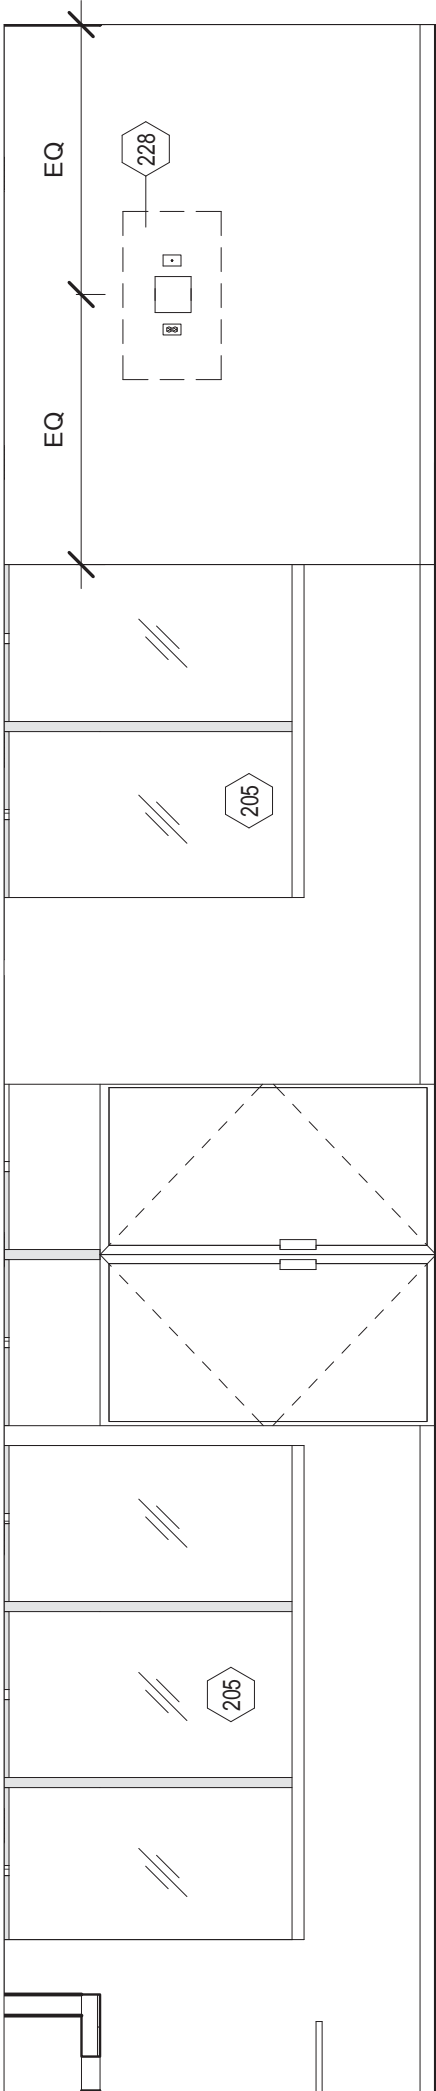


F6 DAY ROOM 5D122 / DINING 5D120B-S

SCALE: 1/4" = 1'-0"

CONSULTANTS:


- DESMAN ASSOCIATES / PARKING
- CODE CONSULTANTS, INC. / CODE CONSULTANT
- THE SEXTANT GROUP / AV & ACOUSTICAL
- HAMMER DESIGN ASSOCIATES / FOOD SERVICE
- PYBURN & ODOM / ABATEMENT
- TATA & HOWARD / TANK CONSULTANT
- I.S.C. GROUP, INC. / IRRIGATION

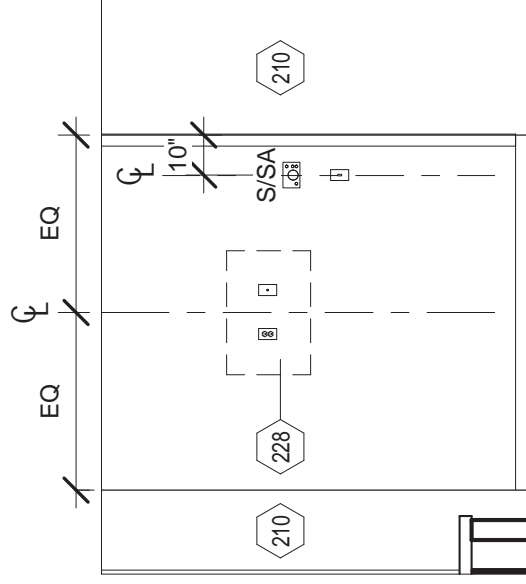

B4

INFUSION TRTMT 7J112B E

SCALE: 1/4" = 1'-0"

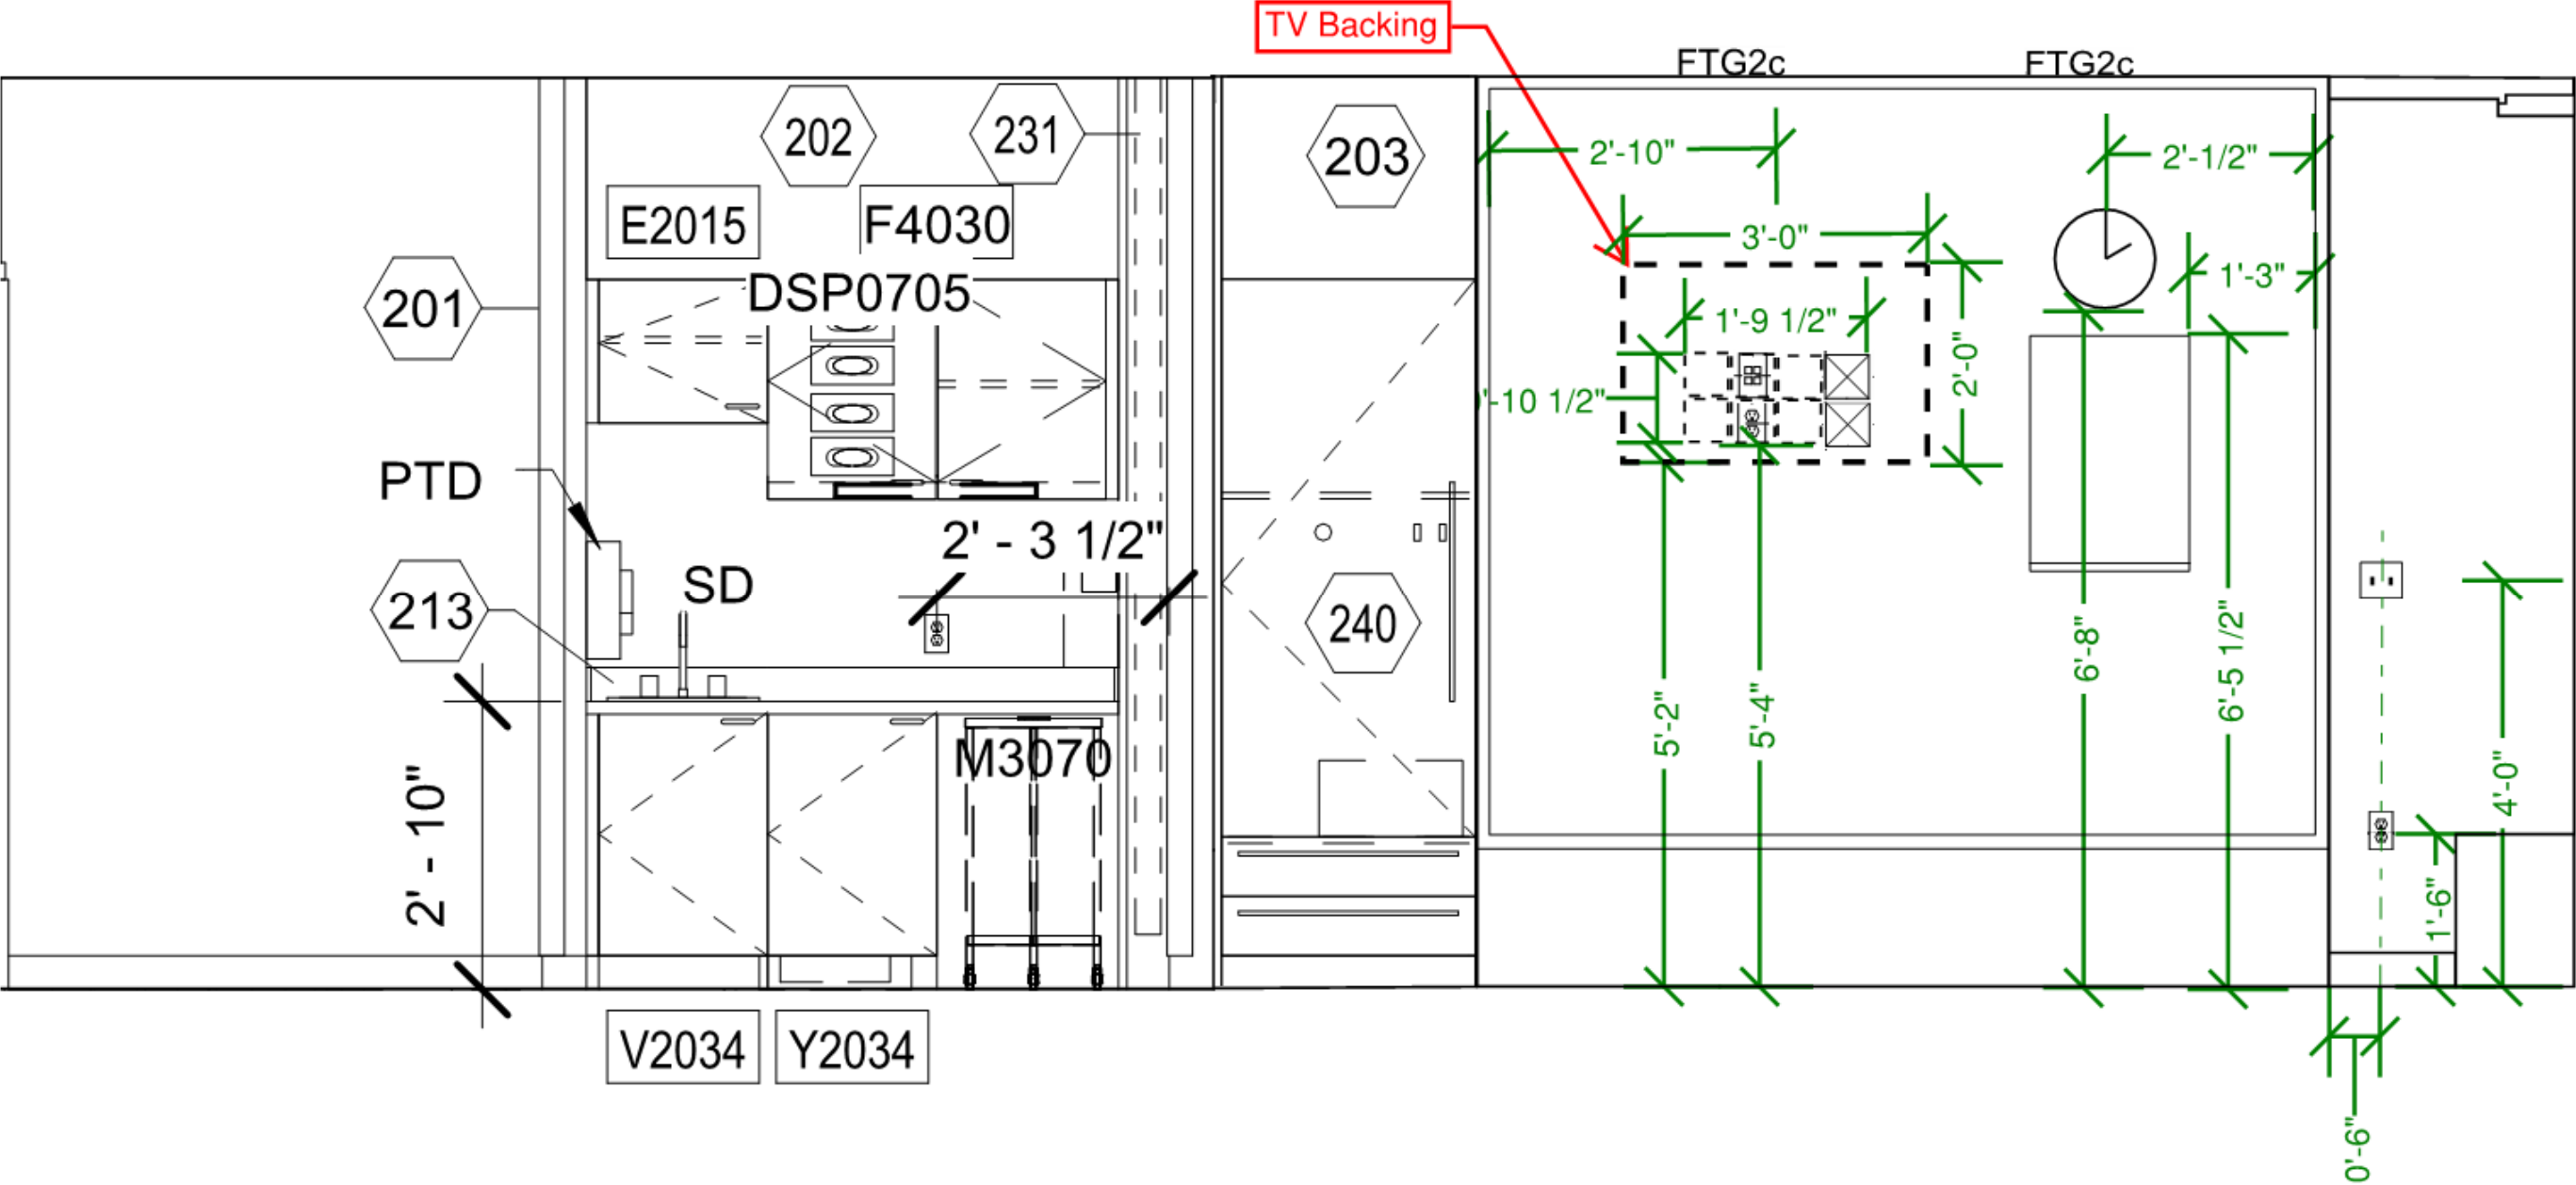

SLVHCS REPLACEMENT MED CENTER
NEW ORLEANS, VA
RFI SKETCH

DRAWN BY BNW
DATE 2014 08 27

REVISIONS:

CHMP
Revised
Footwall Layout
Sketch