


LIGHTING FIXTURE SCHEDULE						
TYPE	MANUFACTURER	CATALOG NUMBER	VOLTS	LAMPS	DESCRIPTION	NOTES
A	L.C. DOANE	RXF-2-6-32-RS-VAR-A-W-12-2C	277	6-F28T8 4100K	2X4 FLANGED RECESSED OPERATING ROOM FIXTURE	
B	MERCURY LTG	CRFI2X4-DA-HA-332-OCT-PS-UNI	277	3-F28T8 4100K	2X4 FLANGED RECESSED CLEANROOM FIXTURE	
C2	MERCURY LTG	35E-232-OCT-9A.125-ELBS-UNI	277	2-F28T8 4100K	2X4 RECESSED LENSED FIXTURE W/ 2 LAMPS	
C3	MERCURY LTG	35E-332-OCT-9A.125-ELBS-UNI	277	3-F28T8 4100K	2X4 RECESSED LENSED FIXTURE W/ 3 LAMPS	
C4	MERCURY LTG	35E-432-OCT-9A.125-ELBS-UNI-2B	277	4-F28T8 4100K	2X4 RECESSED LENSED FIXTURE W/ 4 LAMPS	
D	XELEUM	XASW02-M50KUNE	277	LED INCLUDED	STAIRWELL FIXTURE W/ EMERGENCY	
F	VISIONAIRE	ARS-1-T3-48LC-5-55K-UNV-WM-XX-EBPL	277	LED INCLUDED	WALL MOUNTED EXTERIOR FIXTURE W/ LED EMERG. BATTERY PACK	
G	MERCURY LTG	MM-232-OCT-ELB-UNI	277	2-F28T8 4100K	4' INDUSTRIAL STRIP, 2 LAMPS, WITH WIRE GUARD AND CHAIN HANGERS	
H	L.C. DOANE	CLS-32-2-C-W-VAR-EL-15-PH	277	2-F28T8 4100K	4', 2 LAMP, HAZARDOUS LOCATION	
J	WAC LIGHTING	WR-6RTL30H-CT-WR-6R1LD-T-SC/WT	277	LED INCLUDED	6" LED DOWNLIGHT	
K	WAC LIGHTING	WS-7334F-BN	277	LED INCLUDED	WALL MOUNTED, 3' LED VANITY LIGHT	
L	WAC LIGHTING	WS-7322F-BN	277	LED INCLUDED	WALL MOUNTED, 2' LED VANITY LIGHT	
1	DUAL LITE	LEDxEMRWW	277	LED INCLUDED	EXIT SIGN, MOUNTING, FACES AND ARROWS PER PLANS. NO SUBSTITUTION	

LIGHTING FIXTURE SCHEDULE GENERAL NOTES:
 1. MANUFACTURER AND MODEL NUMBERS ARE PROVIDED AS BASIS OF DESIGN ONLY AND ARE NOT TO LIMIT SELECTION. CONTRACTOR SHALL PROVIDE SCHEDULED EQUIPMENT OR EQUIPMENT OF EQUAL QUALITY.
 2. PROVIDE FLANGE KIT AS REQUIRED

REVISION 1	07/07/2015
Revisions:	Date

CONSULTANTS:
ENGINEERING:
 CROMWELL ARCHITECTS ENGINEERS
 101 SOUTH SPRING STREET
 LITTLE ROCK, AR 72201
 501.372.2900

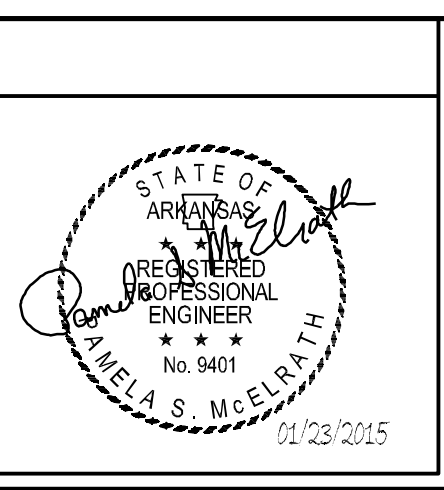

ARCHITECT/ENGINEERS:

 BES DESIGN/BUILD, LLC
 766 Middle St, Fairhope, AL 36532
 Phone: 251.990.5778
 Fax: 251.990.3716

Drawing Title
ELECTRICAL LIGHT FIXTURE SCHEDULES
 Approved: Project Director

Project Title
CONSTRUCT NEW OR SUITES
 Location
JOHN L. McCLELLAN MEMORIAL VETERANS HOSPITAL; LITTLE ROCK, ARKANSAS
 Project Number
 598-12-207
 Building Number
 1
 Drawing Number
EL601
 Date
 01/23/15
 Drawn
 SRB
 Checked
 PSM
 Dwg. of

CENTRAL ARKANSAS VETERANS AFFAIRS HEALTHCARE SYSTEM