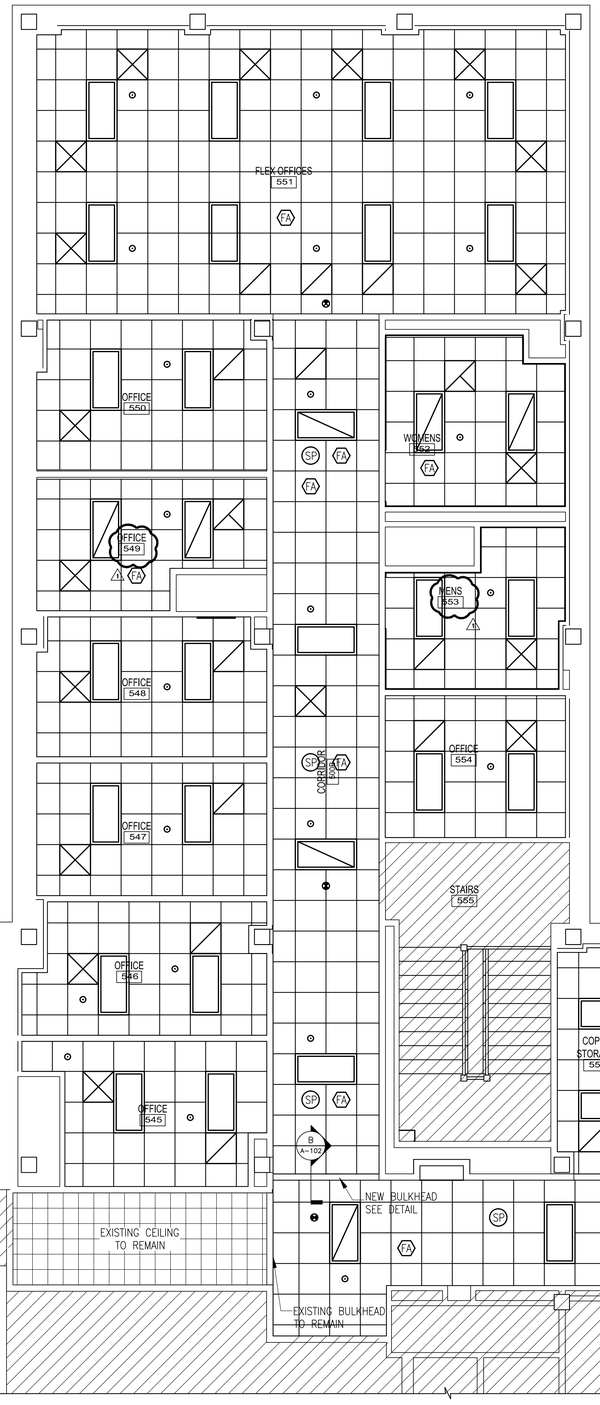

A PARTIAL REFLECTIVE CEILING PLAN

SCALE: 1/4" = 1'-0"

0 2' 4' 8'

SCALE: 1/4" = 1'-0"

TRUE N

PLAN N

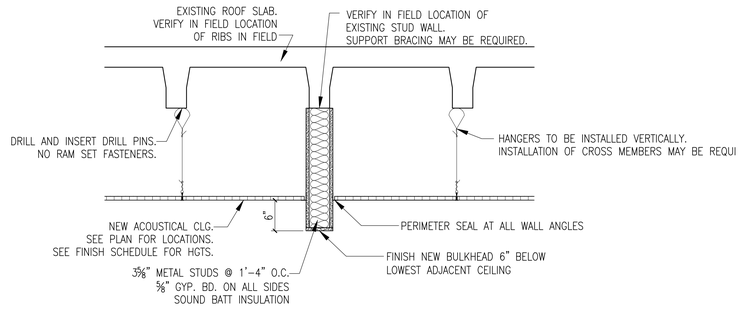

B BULKHEAD DETAIL

SCALE: 1" = 1'-0"

0 6" 1' 2'

SCALE: 1" = 1'-0"

LEGEND

- NO WORK AREAS
- BID DEDUCT AREA
- NEW A.C.T. CEILING GRID. SEE FINISH SCHEDULE FOR CEILING HEIGHTS AND NOTES.
- EXISTING CEILING TO REMAIN
- NEW SUPPLY DIFFUSER SEE MECHANICAL DRAWINGS
- NEW RETURN DIFFUSER SEE MECHANICAL DRAWINGS
- NEW EXHAUST DIFFUSER SEE MECHANICAL DRAWINGS
- NEW LAY-IN LIGHT FIXTURE SEE MECHANICAL DRAWINGS
- NEW EMERGENCY FIXTURE SEE MECHANICAL DRAWINGS
- NEW FIRE SPRINKLER HEAD SEE MECHANICAL DRAWINGS
- NEW CEILING SPEAKER SEE MECHANICAL DRAWINGS
- NEW CEILING FIRE ALARM/DETECTION SEE MECHANICAL DRAWINGS
- NEW CEILING MOUNTED EXIT SIGN SEE MECHANICAL DRAWINGS

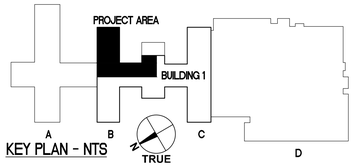

KEY PLAN - NTS

-	-
-	-
-	-
-	-
-	-
-	-
-	-
-	-
⚠1 REVISION RA - OFFICE 449/ MENS 553	06/09/15
Revisions	Date

100% FINAL CONSTRUCTION DOCUMENTS

EDWARD H. HENDRICKS REGISTERED ARCHITECT NORTH CAROLINA HICKORY, N.C.

ARCHITECT/ENGINEERS:

Atriax GROUP
www.atriaxgroup.com

Atriax, pllc
102 3rd Avenue, NE
PO Box 1629, Hickory, NC 28603
T: 828.315.9962
F: 828.315.9964

NC Engineering License No.: P-0214
NC Architectural License No.: 51254

Dewberry

Dewberry Engineers Inc.
605 Eastowne Drive, Chapel Hill, NC 27514
T: 919.433.0075
F: 919.435.0079

NC Engineering License No.: F-0929

Drawing Title: PARTIAL REFLECTIVE CEILING PLAN
–
–

Approved: Project Director
–
–
–

Project Title: RENOVATE B-WING 5TH FLR FOR MENTAL HEALTH

Location: VAMC FAYETTEVILLE NC

Date: 22 JULY 2014 | Checked: EHH | Drawn: TLR

Project Number: 565-13-209

Building Number: 1

Drawing Number: A-102 RA

Dwg. 5 of 36

Office of Construction and Facilities Management

Department of Veterans Affairs

VA FORM 08-6231

one eighth inch = one foot three quarters inch = one foot one quarter inch = one foot three eighths inch = one foot one half inch = one foot one and one half inches = one foot one inch = one foot three inches = one foot
C:\VA Fayetteville VA-E IDIQ June 2013\Task Orders\Renovate B-Wing 5th Floor for Mental Health\00 Construction Period Services\08 CoA 102_RA REFLECTIVE CEILING PLAN.dwg 6-10-15 11:50:55 AM CAD