



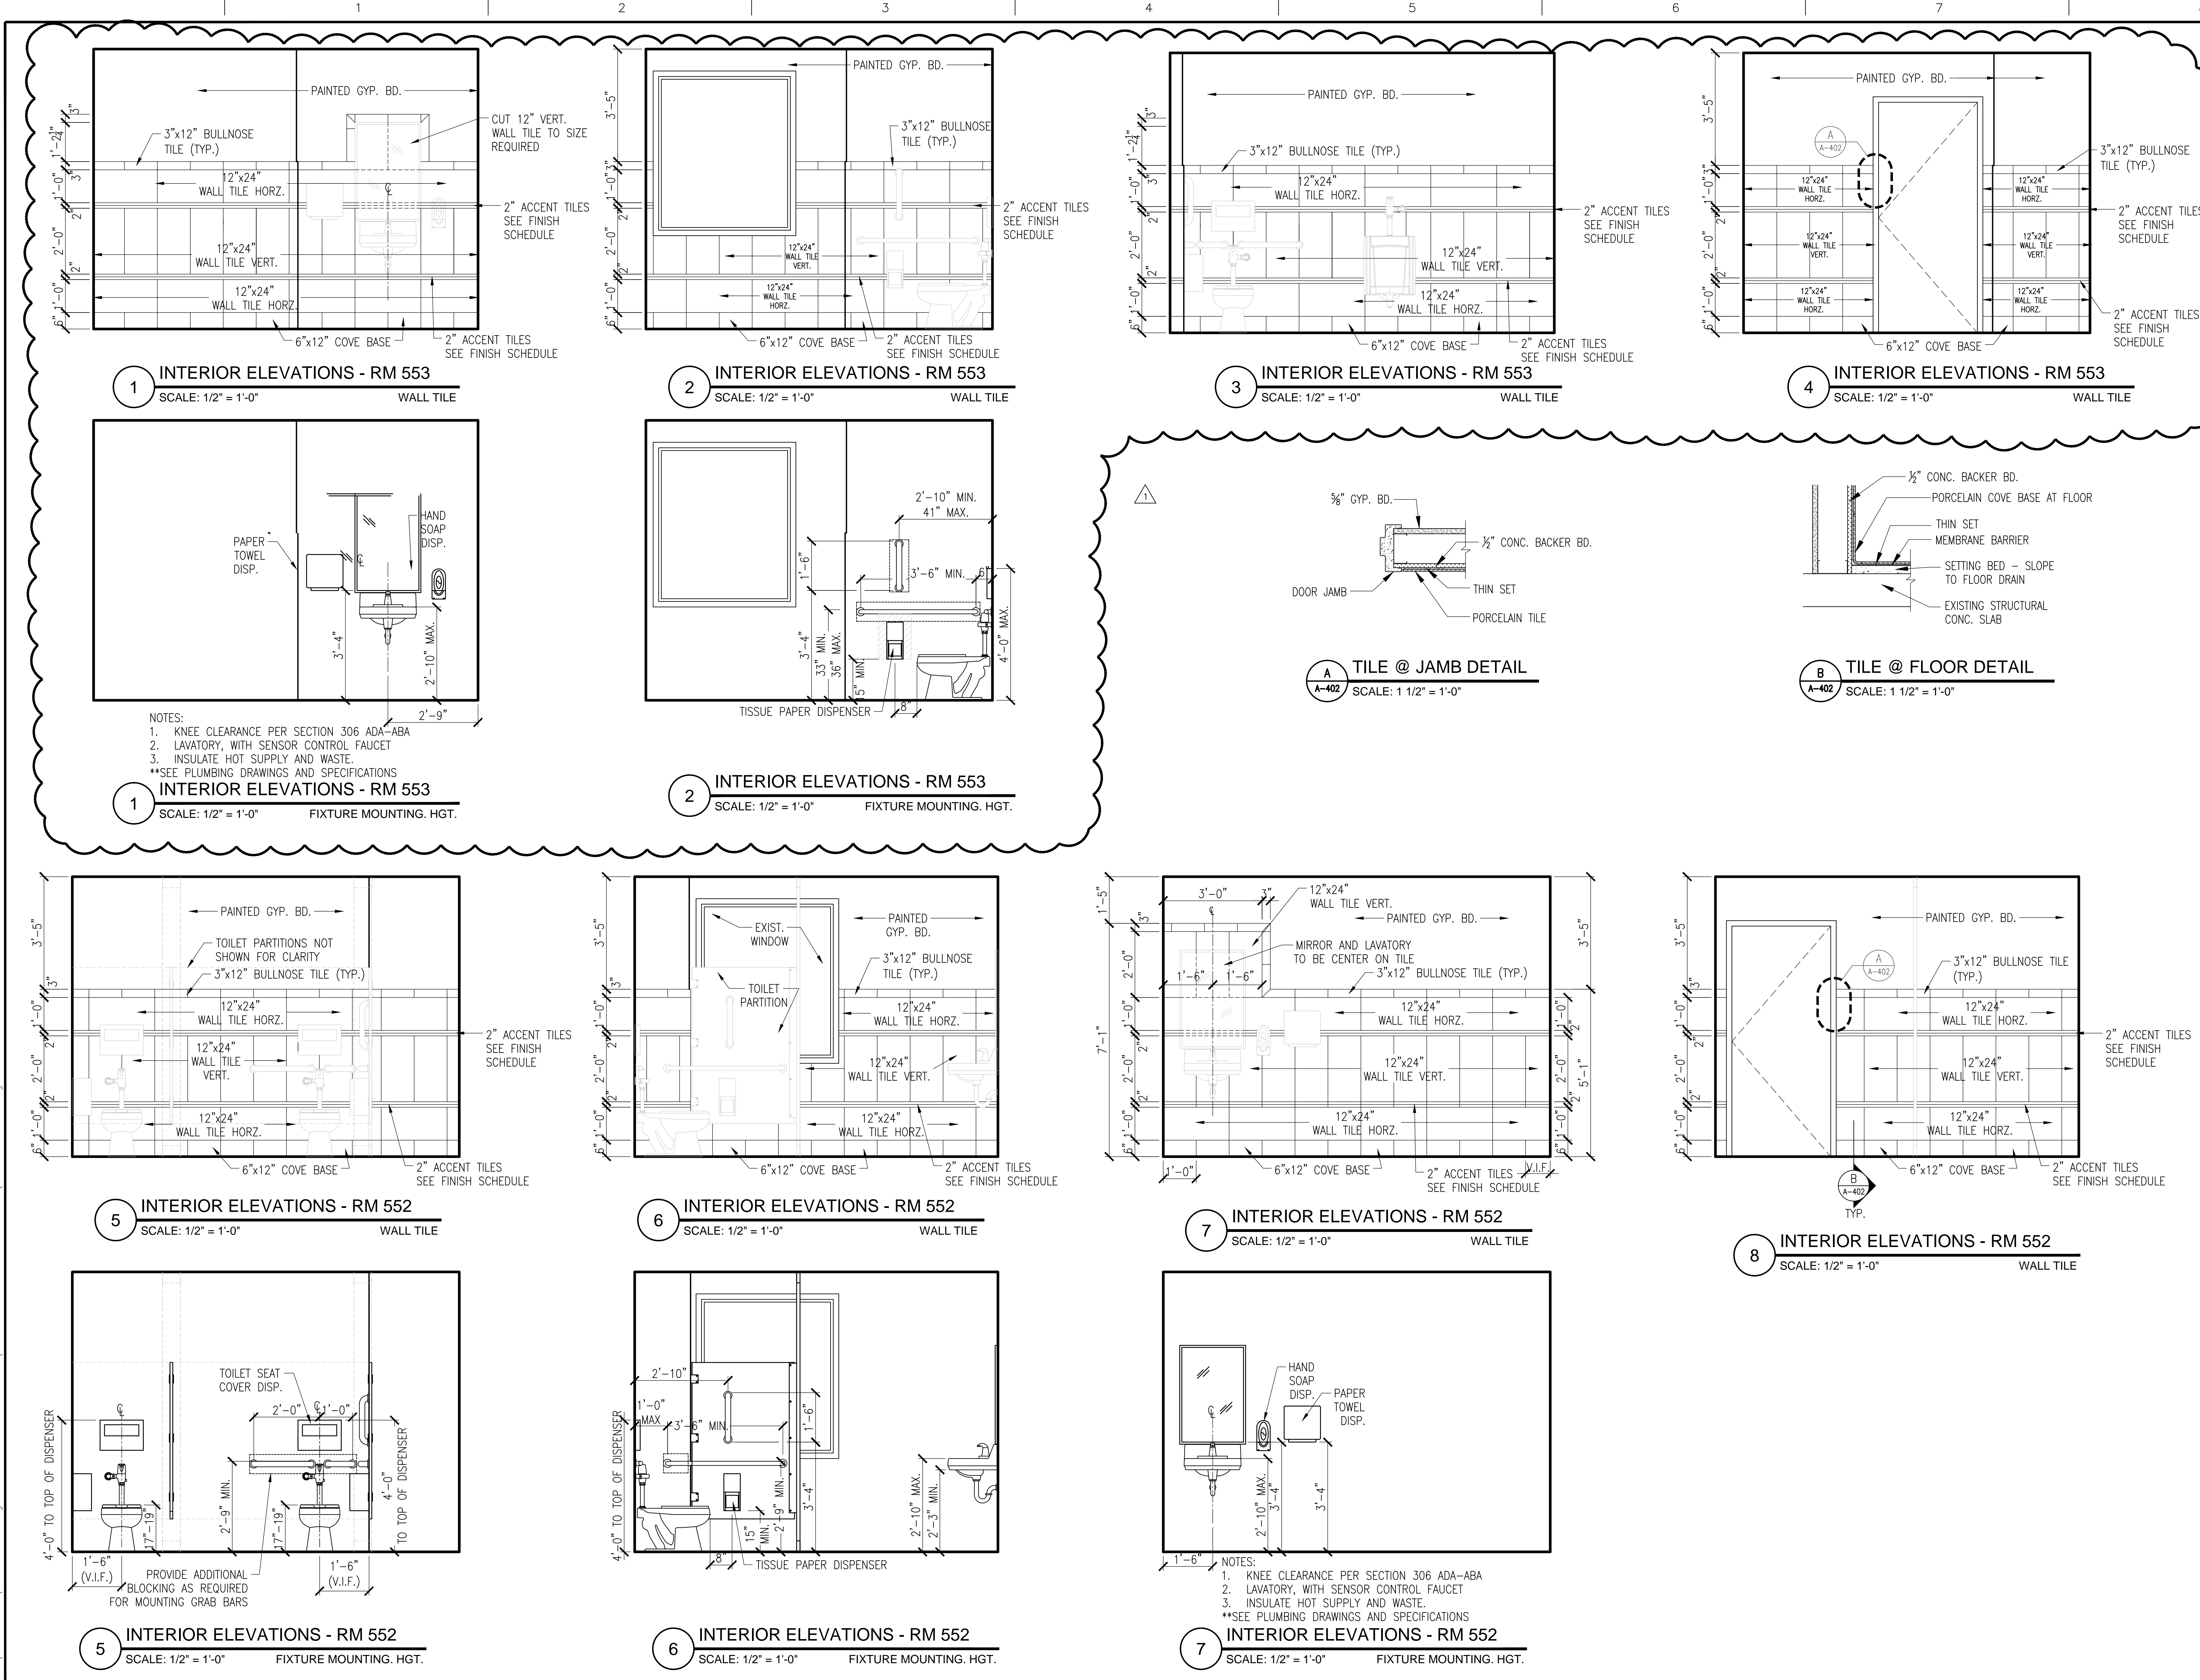


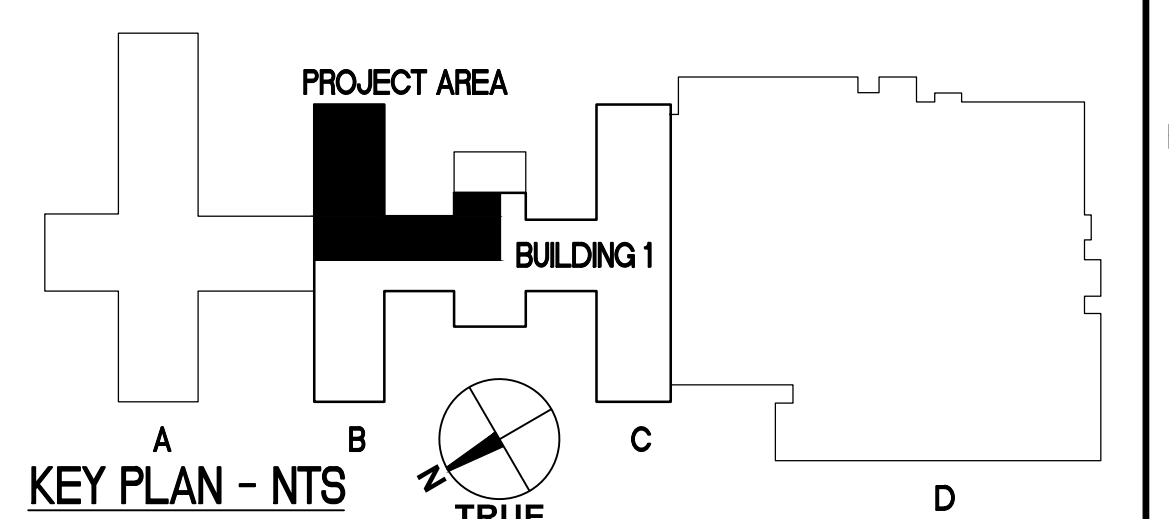

- ### KEYNOTE LEGEND
- A WALL MOUNTED MIRROR (24" x 36")
 - B LAVATORY (ACCESSIBLE). SEE PLUMBING DRAWINGS
 - C HORIZONTAL GRAB BAR(S) (36" LONG MIN.: MAY BE SPLIT IF REQ.)
 - D HORIZONTAL GRAB BAR (42" LONG MIN.)
 - E NOT USED
 - F FLOOR MOUNTED TOILET WITH FLUSH VALVE. SEE PLUMBING DRAWINGS.
 - G WALL MOUNTED URINAL WITH FLUSH VALVE. SEE PLUMBING DRAWINGS.
 - H ADA/ABA WHEELCHAIR REQUIRED TURNING AREA
 - J ADA/ABA REQUIRED CLEAR FLOOR SPACE
 - K NEW ADA/ABA COMPLIANT TOILET PARTITIONS
 - L NEW FLOOR DRAIN

- ### GENERAL NOTES
- ADDITIONAL TOILET ACCESSORIES: (PAPER & SOAP DISPENSER, ETC.) TO BE VA PROVIDED AND VA INSTALLED. NOT PART OF THIS CONTRACT. SEE ELEVATIONS FOR MOUNTING HEIGHTS ON A-402.
 - SEE FINISH SCHEDULE FOR ADDITIONAL NOTES FOR WALL TILE.

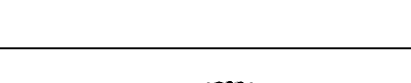

						ARCHITECT/ENGINEERS:		Drawing Title TOILET ELEVATIONS		Project Title RENOVATE B-WING 5TH FLR FOR MENTAL HEALTH		Project Number 565-13-209		Office of Construction and Facilities Management					
						 Atriax, pllc 102 3rd Avenue, NE PO Box 1629, Hickory, NC 28603 T: 828.315.9962 F: 828.315.9964 www.atriaxgroup.com NC Engineering License No.: P-0214 NC Architectural License No.: 51254		 Dewberry Engineers Inc. 605 Eastowne Drive, Chapel Hill, NC 27514 T: 919.433.0075 F: 919.435.0079 NC Engineering License No.: F-0929		Building Number 1		Drawing Number A-402 RA Dwg. 9 of 36							
100% FINAL CONSTRUCTION DOCUMENTS								Approved Project Director		Location VAMC FAYETTEVILLE NC		Date 22 JULY 2014		Checked EHH		Drawn TLR		Department of Veterans Affairs	
REVISION RA - OFFICE 449 / MENS 553 Revisions		06/09/15 Date																	