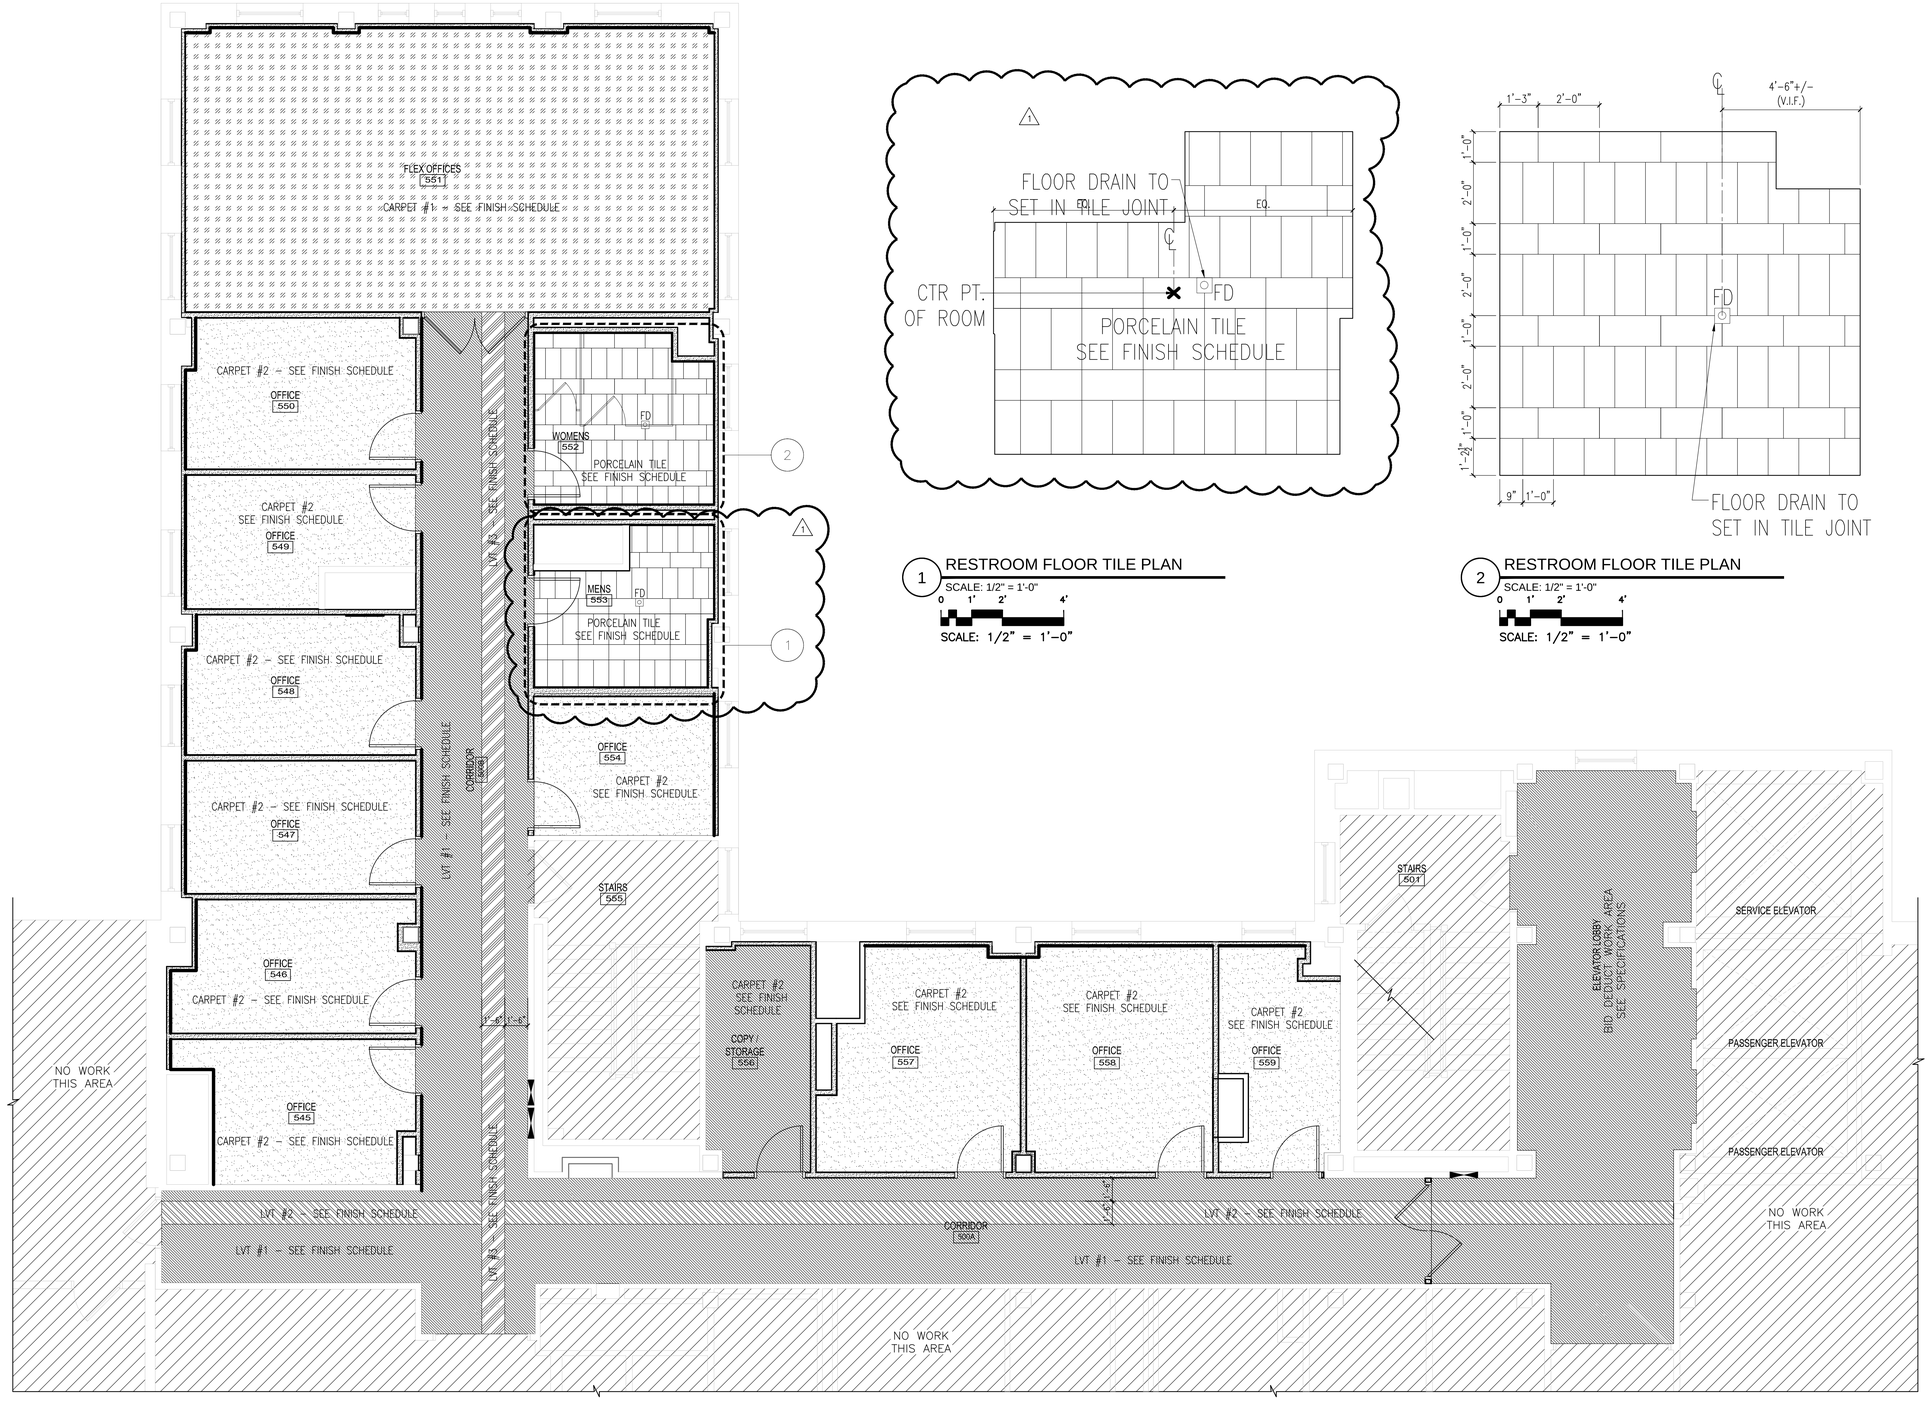

A PARTIAL FLOOR PLAN
SCALE: 1/4" = 1'-0"
0 2' 4' 8'
SCALE: 1/4" = 1'-0"
TRUE
N
PLAN

1 RESTROOM FLOOR TILE PLAN
SCALE: 1/2" = 1'-0"
0 1' 2' 4'
SCALE: 1/2" = 1'-0"

2 RESTROOM FLOOR TILE PLAN
SCALE: 1/2" = 1'-0"
0 1' 2' 4'
SCALE: 1/2" = 1'-0"

LEGEND

- NO WORK AREAS
- ACCENT WALL
- CARPET #1
- CARPET #2
- LUXURY VINYL TILE #1
- LUXURY VINYL TILE #2
- LUXURY VINYL TILE #3
- PORCELAIN TILE

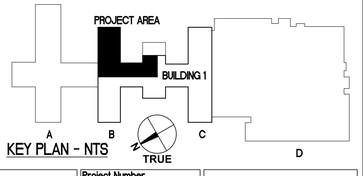

KEY PLAN - NTS

Revisions	Date
-	-
-	-
-	-
-	-
-	-
-	-
-	-
-	-
1 REVISION RA - OFFICE 449 / MENS 553	06/09/15

100% FINAL CONSTRUCTION DOCUMENTS

EDWARD H. HENSON REGISTERED ARCHITECT NORTH CAROLINA 8431 HICKORY, N.C.

ARCHITECT/ENGINEERS:

Atriax GROUP
www.atriaxgroup.com

Atriax, pllc
102 3rd Avenue, NE
PO Box 1629, Hickory, NC 28603
T: 828.315.9962
F: 828.315.9964

NC Engineering License No.: P-0214
NC Architectural License No.: 51254

Dewberry
Dewberry Engineers Inc.
605 Eastowne Drive, Chapel Hill, NC 27514
T: 919.433.0075
F: 919.435.0079

NC Engineering License No.: F-0929

Drawing Title
INTERIOR FLOOR FINISH PLAN
-
-

Approved: Project Director
-
-
-

Project Title
RENOVATE B-WING 5TH FLR FOR MENTAL HEALTH

Location
VAMC FAYETTEVILLE NC

Date	Checked	Drawn
22 JULY 2014	EHH	MTL

Project Number
565-13-209

Building Number
1

Drawing Number
I-101 RA
Dwg. 13 of 36

Office of Construction and Facilities Management

Department of Veterans Affairs

P:\VA\Fayetteville\A-E IDIQ June 2013\Task Orders\Renovate B-Wing 5th Floor for Mental Health\00 Construction Period Services\08 Col 101 RA FLOOR FINISH PLAN.dwg 6-10-15 11:58:45 AM CAD

VA FORM 08-6231