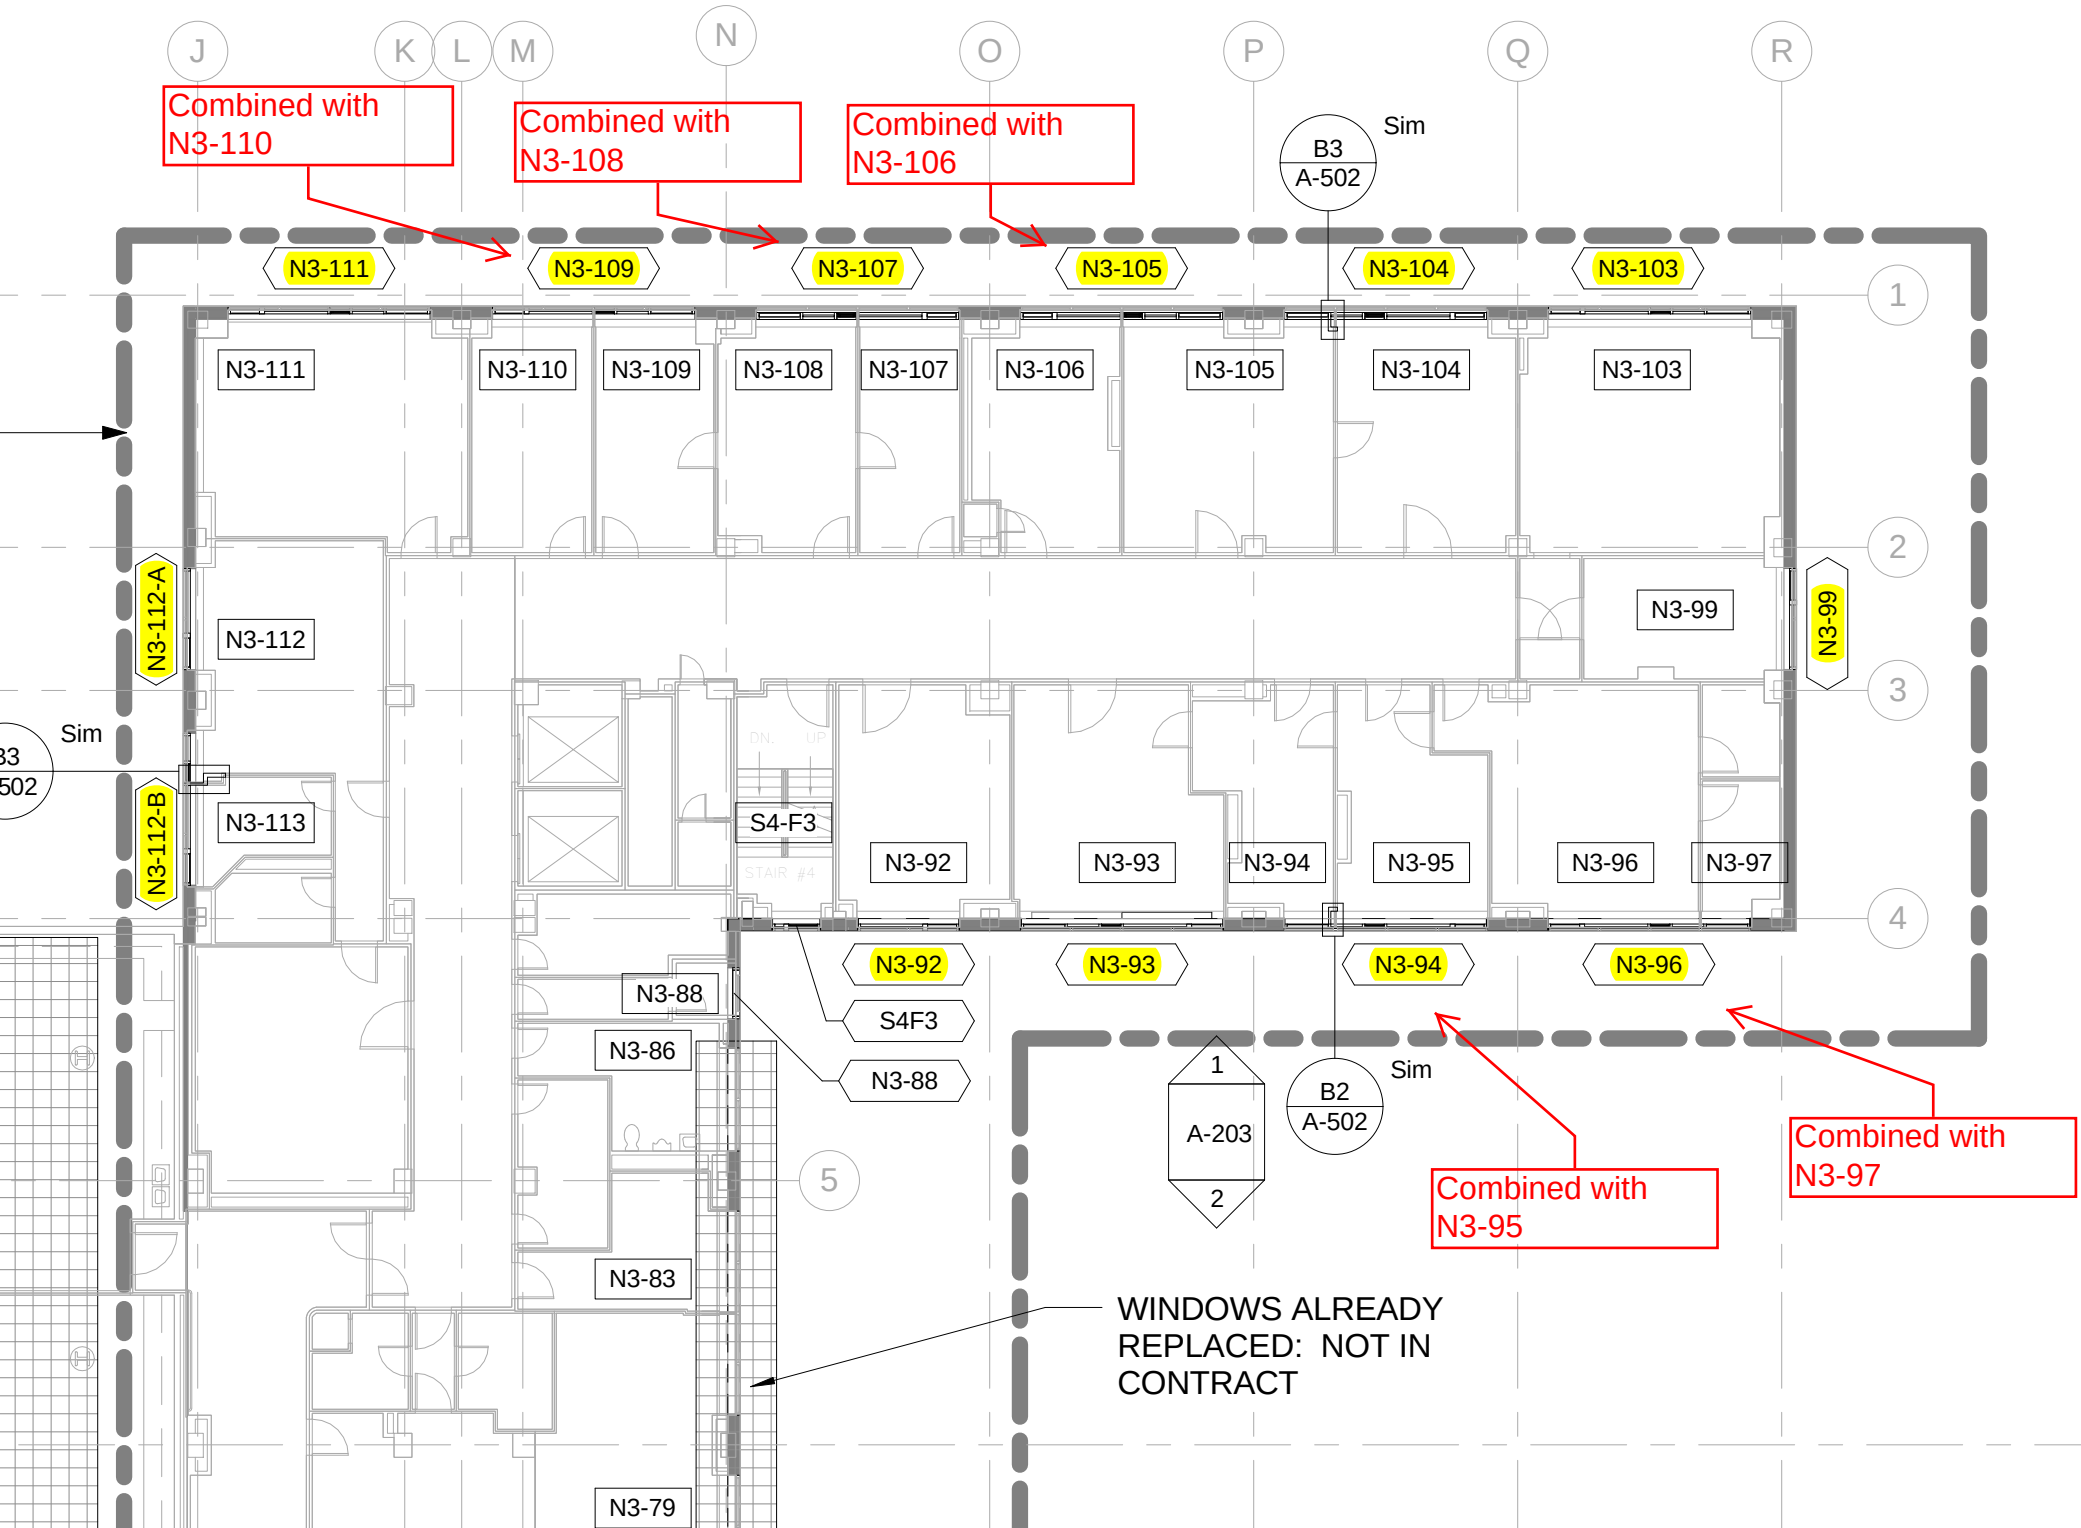
J
K
L
M
N
O
P
Q
R
1
2
3
4
5
Combined with N3-110
Combined with N3-108
Combined with N3-106
B3
A-502
Sim
N3-111
N3-109
N3-107
N3-105
N3-104
N3-103
N3-110
N3-108
N3-106
N3-112-A
N3-112
N3-99
N3-113
S4-F3
N3-92
N3-93
N3-94
N3-95
N3-96
N3-97
S4F3
N3-88
N3-86
N3-83
N3-79
B2
A-502
A-203
Combined with N3-95
Combined with N3-97
WINDOWS ALREADY REPLACED: NOT IN CONTRACT