

**CEP Level 1**


REVISED 06/25/2015

**F5** LEVEL 1 AREA N1 PLAN  
SCALE: 1/8" = 1'-0"

**ATTACHMENT 2-  
FLOORPLANS - PAGE 1 OF 4  
FIRST FLOOR PLAN: CEP**

**SHADE TYPE A:**  
APPROXIMATE SIZE & QUANTITY  
33"W X 21"H (1)  
61"W X 21"H (1)  
72"W X 21"H (1)  
\*NOTE: ALL SIZES AND QUANTITIES ARE APPROXIMATE FOR BIDDING PURPOSES ONLY. FINAL SIZES AND QUANTITIES SHALL BE FIELD VERIFIED PRIOR TO ORDER PLACEMENT.

**SHADE LOCATION**

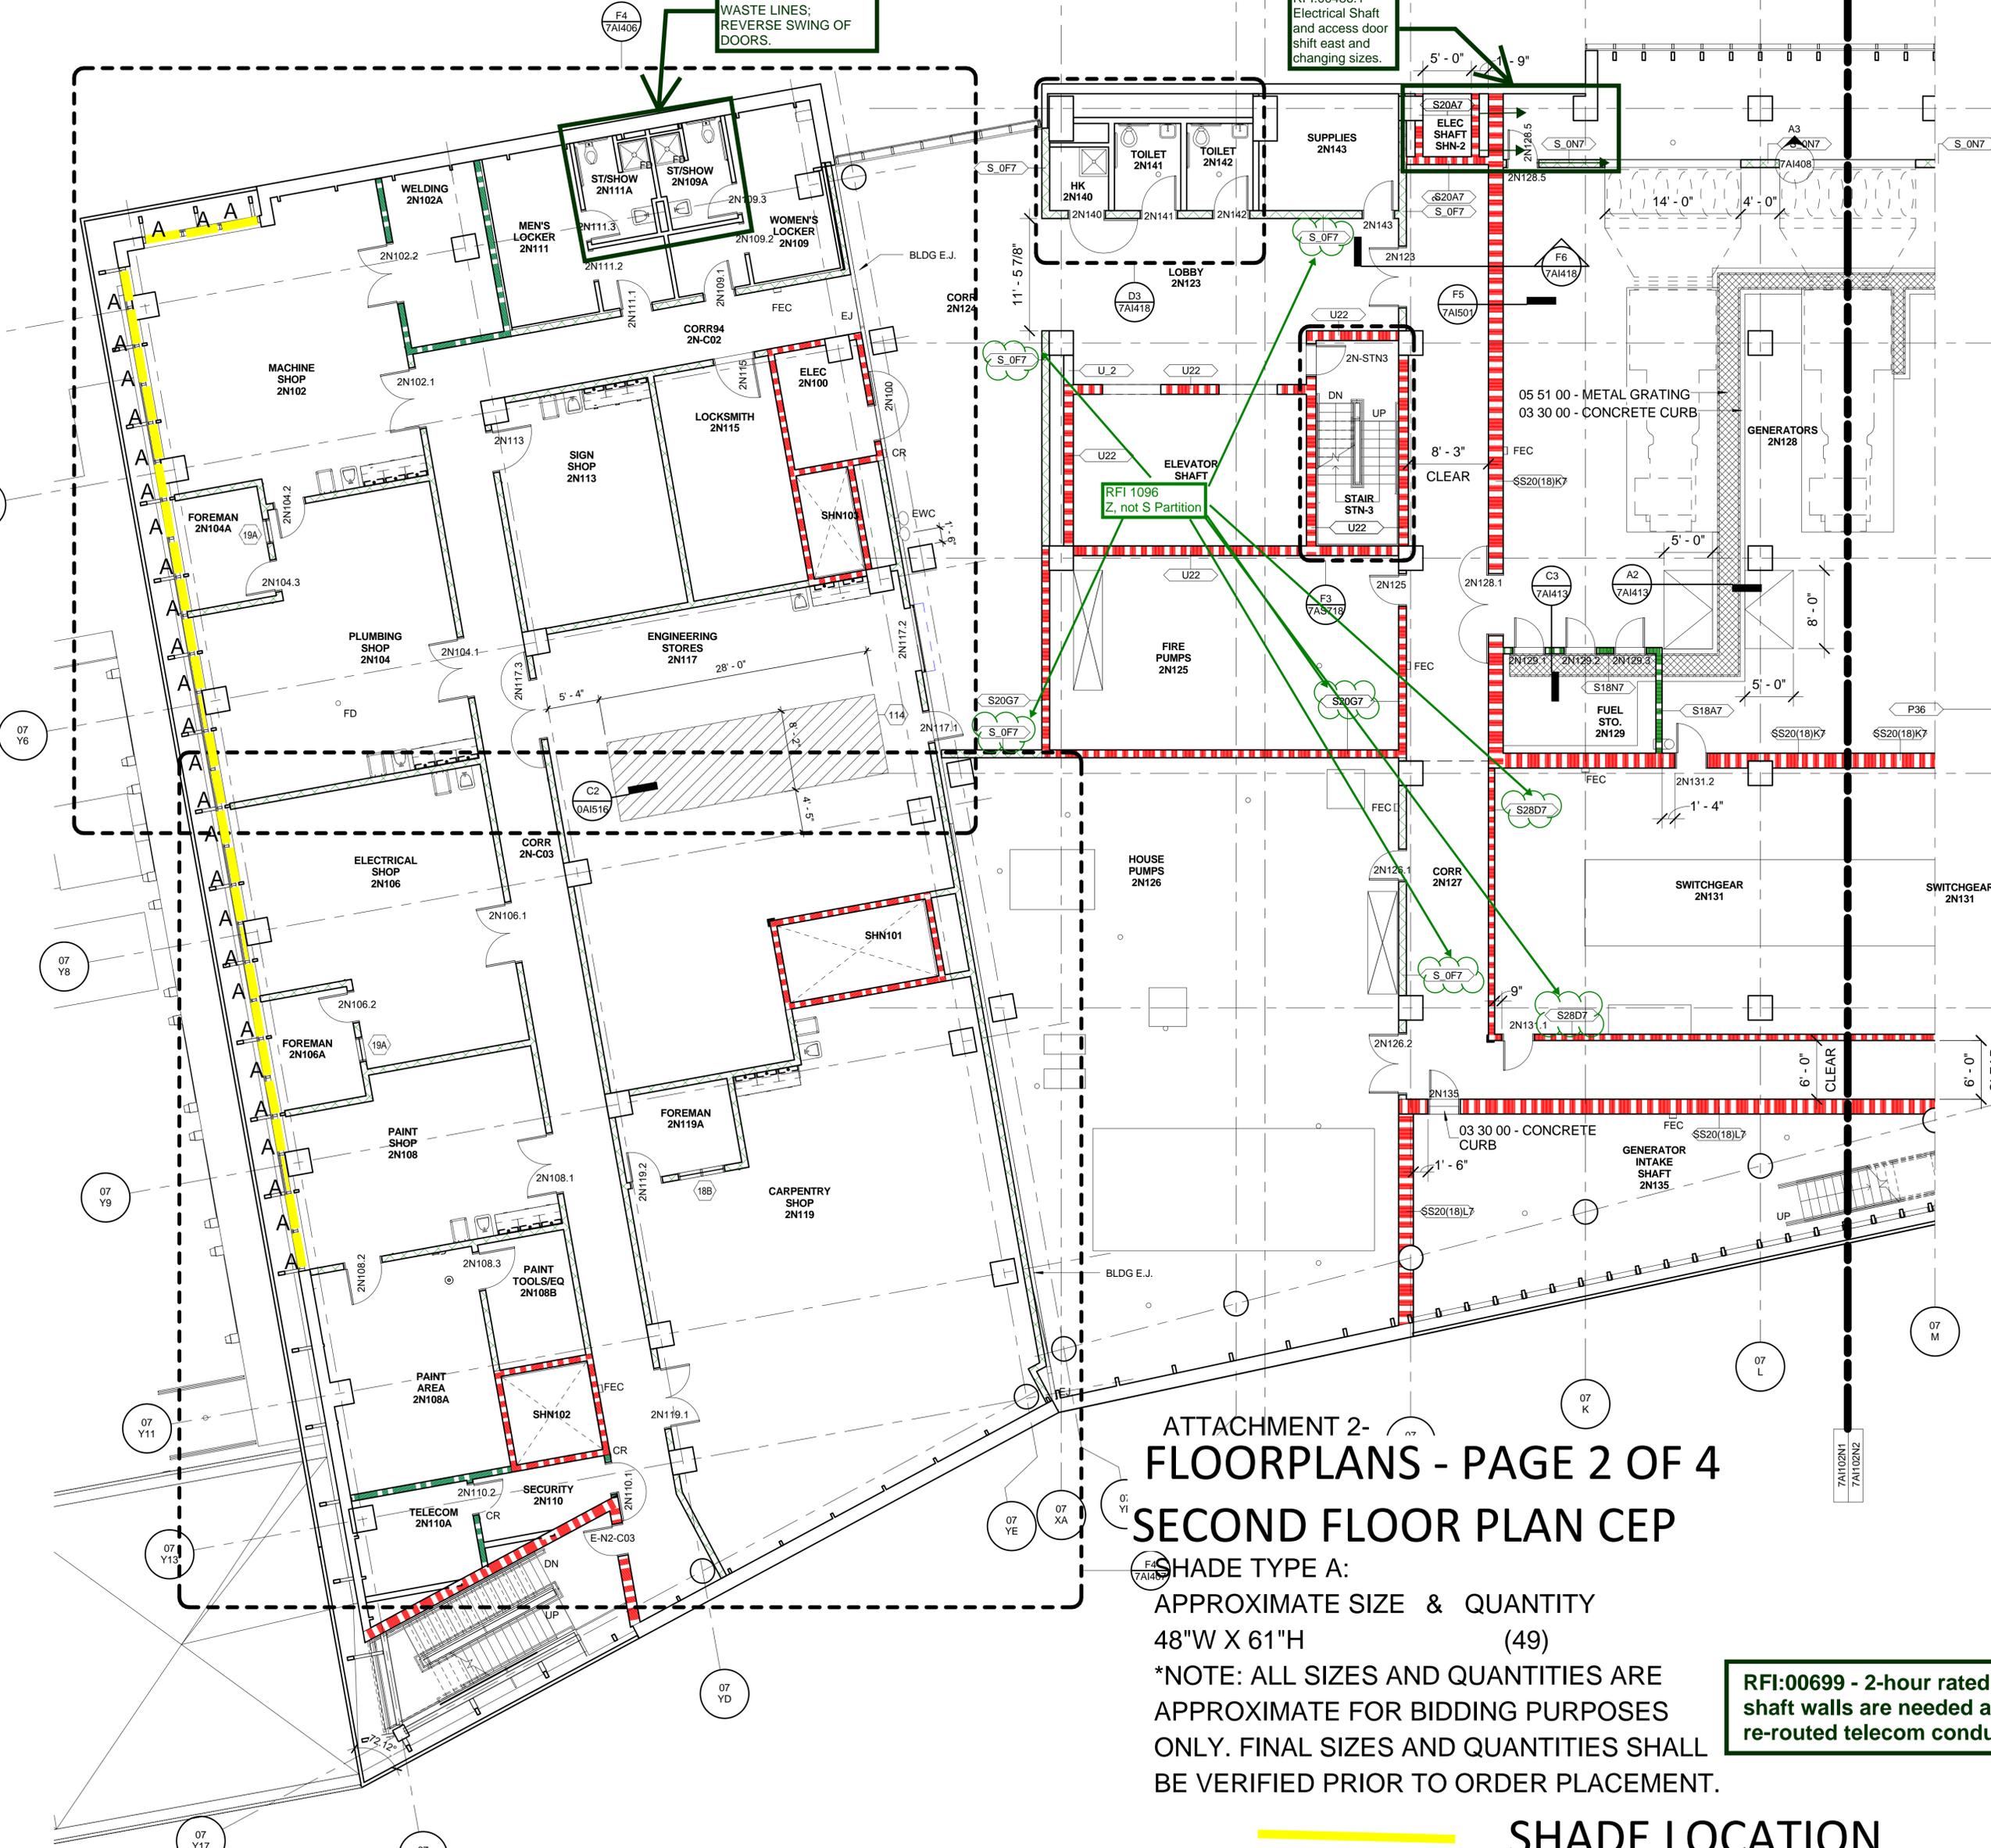

WASTE LINES:  
REVERSE SWING OF  
DOORS.


Electrical Shaft  
and access door  
shift east and  
changing sizes.

ATTACHMENT 2-  
FLOORPLANS - PAGE 2 OF 4  
SECOND FLOOR PLAN CEP

SHADE TYPE A:  
APPROXIMATE SIZE & QUANTITY  
48"W X 61"H (49)  
\*NOTE: ALL SIZES AND QUANTITIES ARE  
APPROXIMATE FOR BIDDING PURPOSES  
ONLY. FINAL SIZES AND QUANTITIES SHALL  
BE VERIFIED PRIOR TO ORDER PLACEMENT.

RFI:00699 - 2-hour rated  
shaft walls are needed a  
re-routed telecom condu

SHADE LOCATION

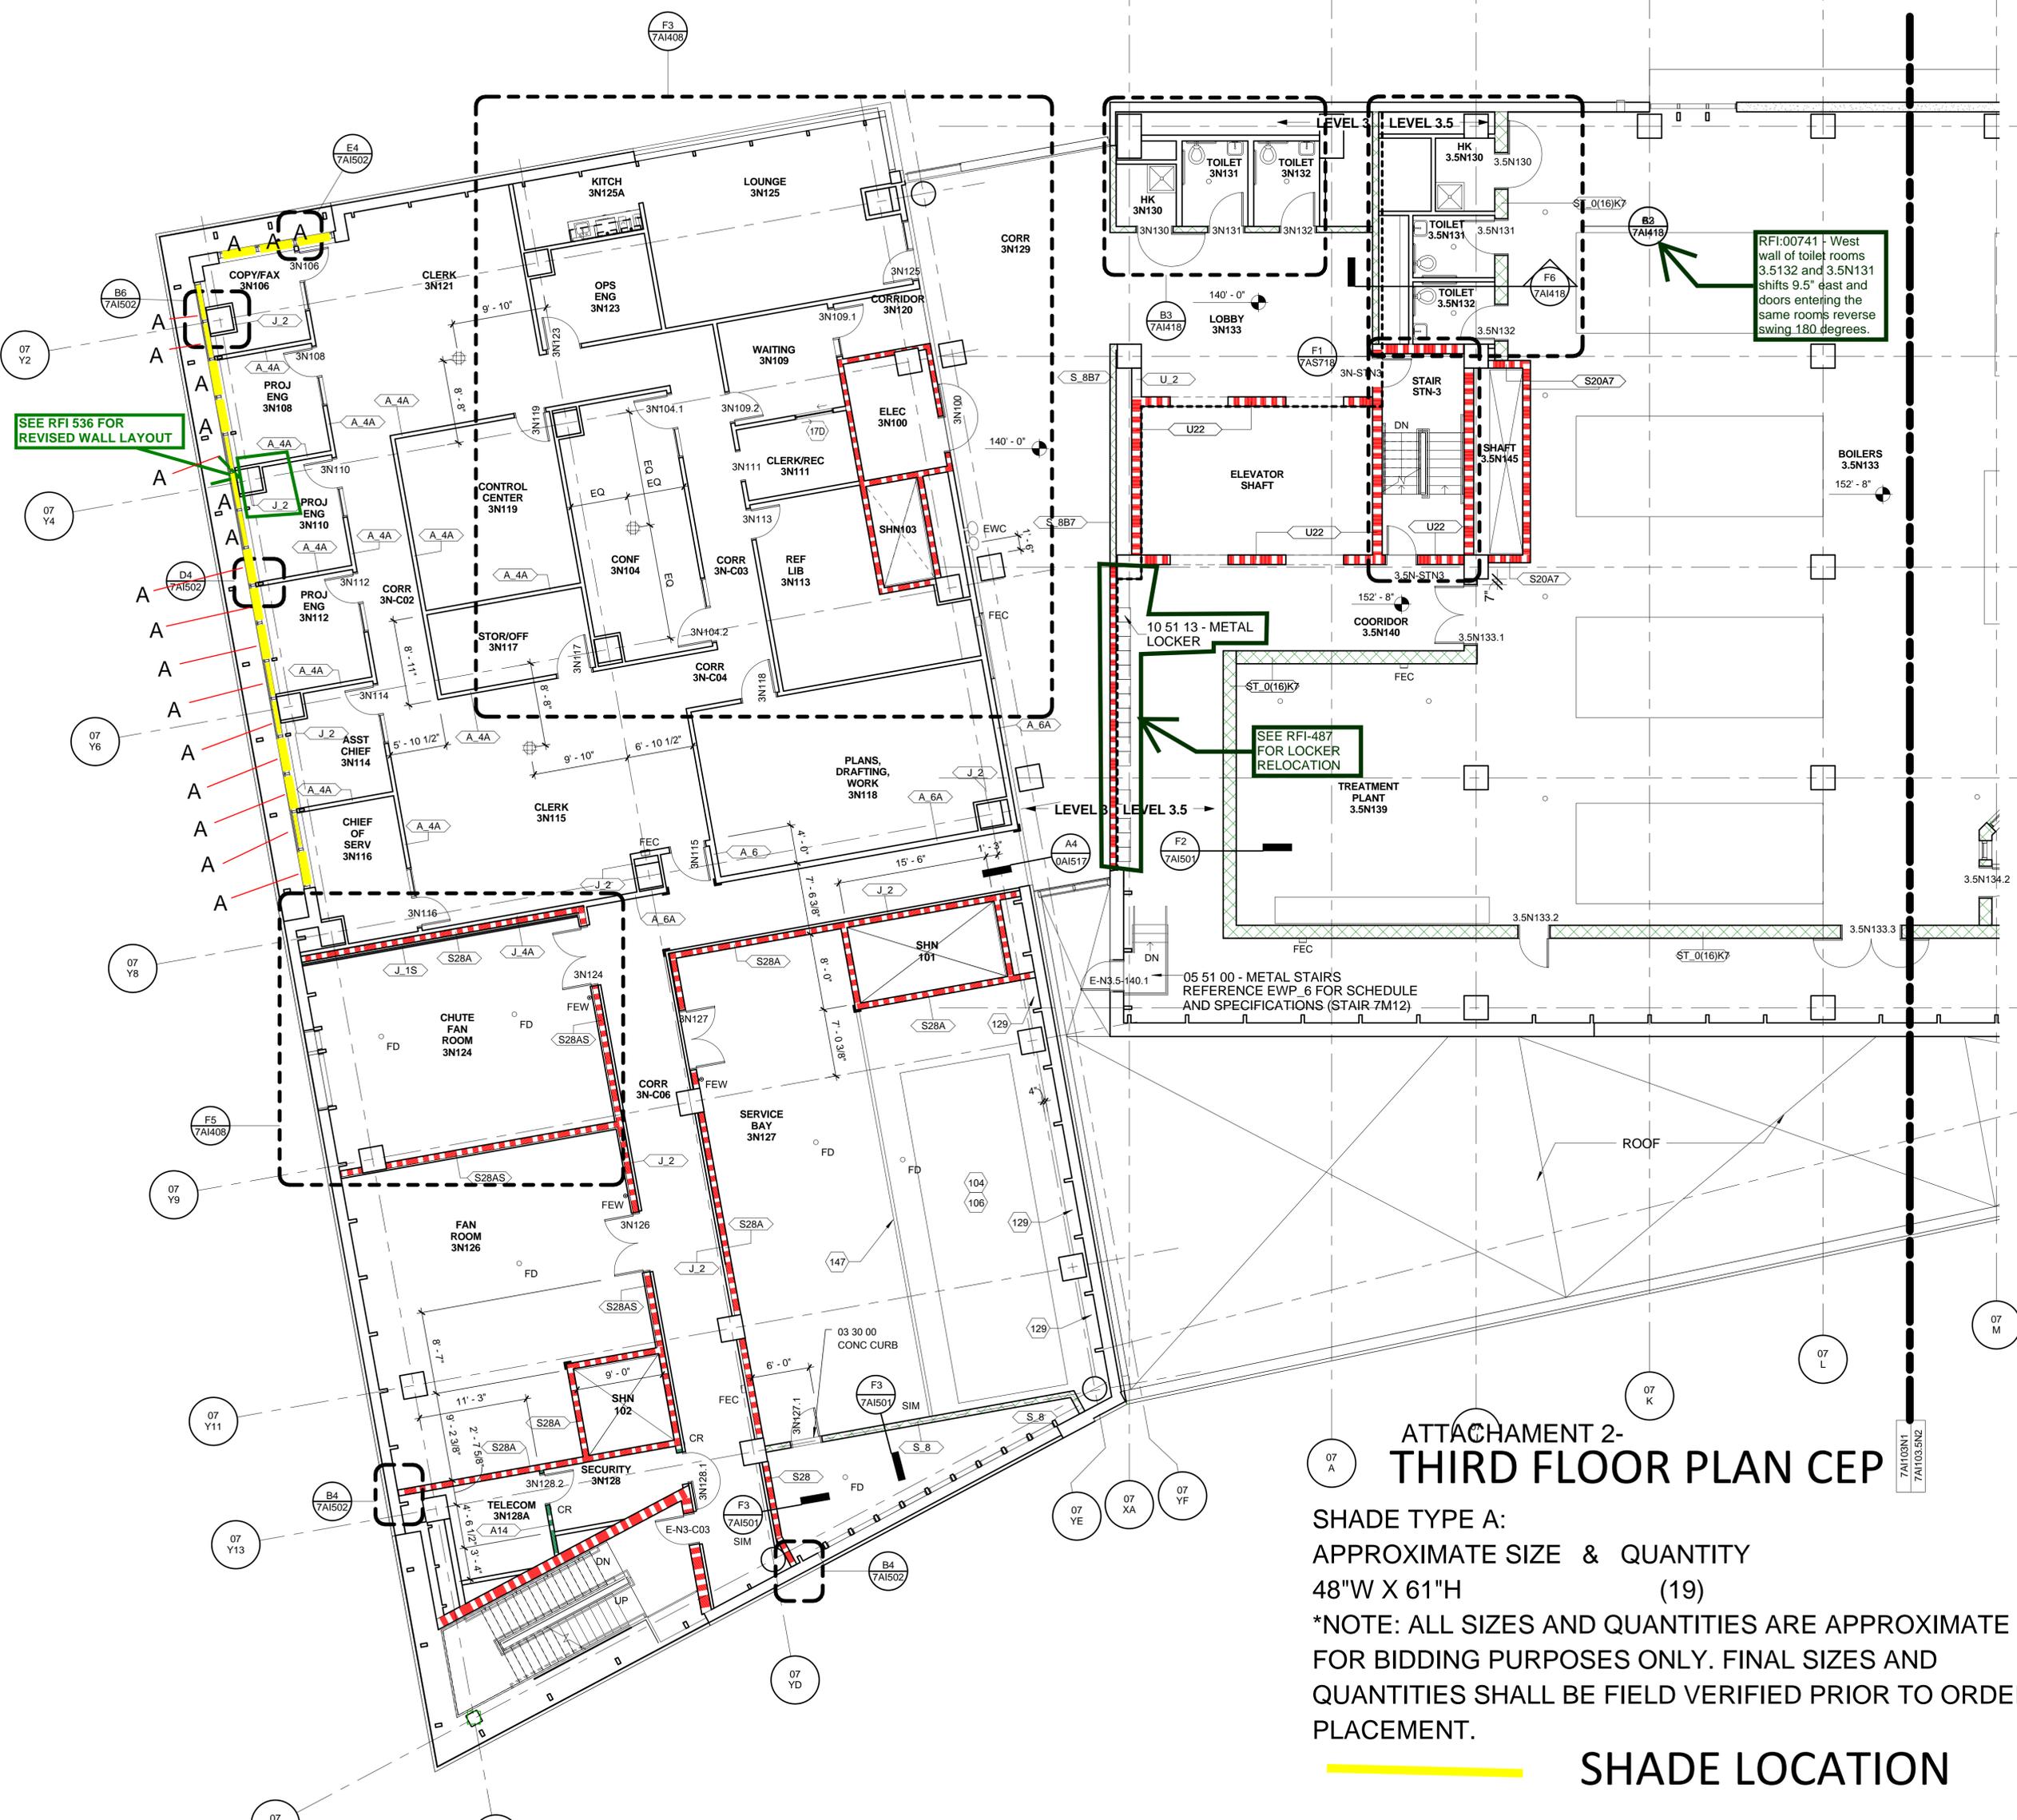


## ATTACHMENT 2- THIRD FLOOR PLAN CEP

SHADE TYPE A:  
APPROXIMATE SIZE & QUANTITY  
48"W X 61"H (19)

\*NOTE: ALL SIZES AND QUANTITIES ARE APPROXIMATE FOR BIDDING PURPOSES ONLY. FINAL SIZES AND QUANTITIES SHALL BE FIELD VERIFIED PRIOR TO ORDER PLACEMENT.

**SHADE LOCATION**

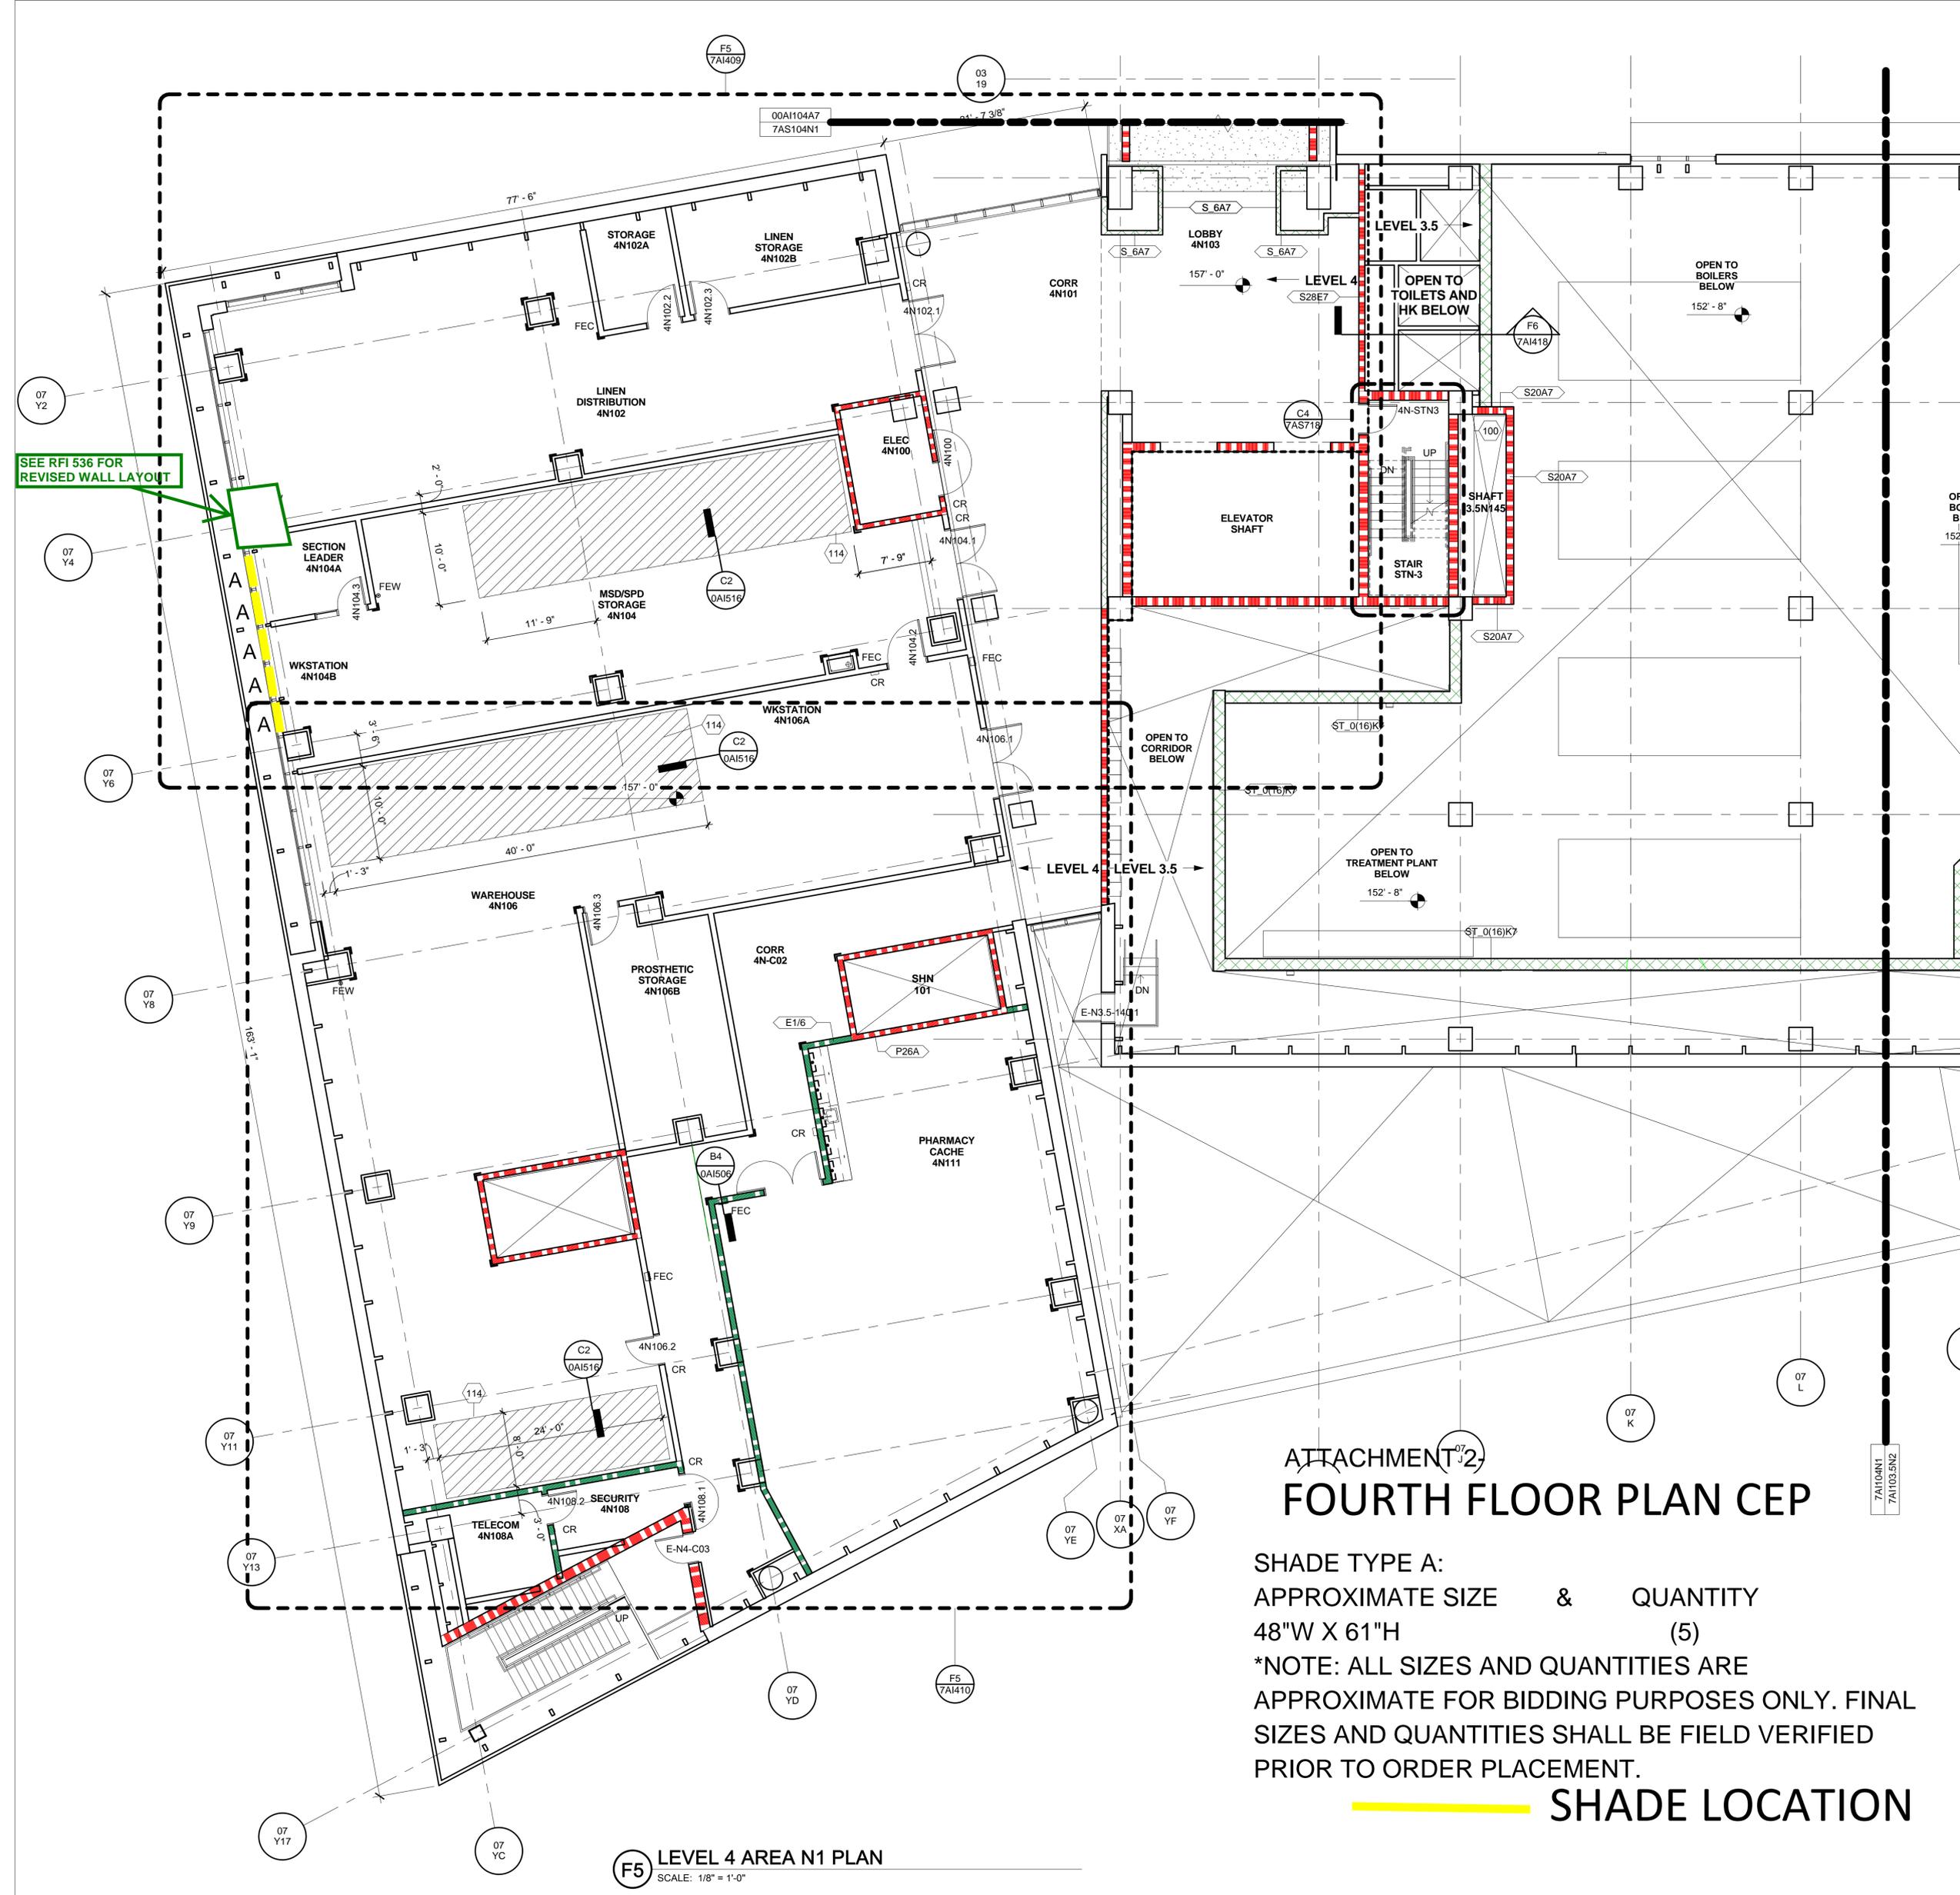

SEE RFI 536 FOR REVISED WALL LAYOUT

ATTACHMENT 2  
**FOURTH FLOOR PLAN CEP**

SHADE TYPE A:  
 APPROXIMATE SIZE & QUANTITY  
 48"W X 61"H (5)

\*NOTE: ALL SIZES AND QUANTITIES ARE APPROXIMATE FOR BIDDING PURPOSES ONLY. FINAL SIZES AND QUANTITIES SHALL BE FIELD VERIFIED PRIOR TO ORDER PLACEMENT.

**SHADE LOCATION**