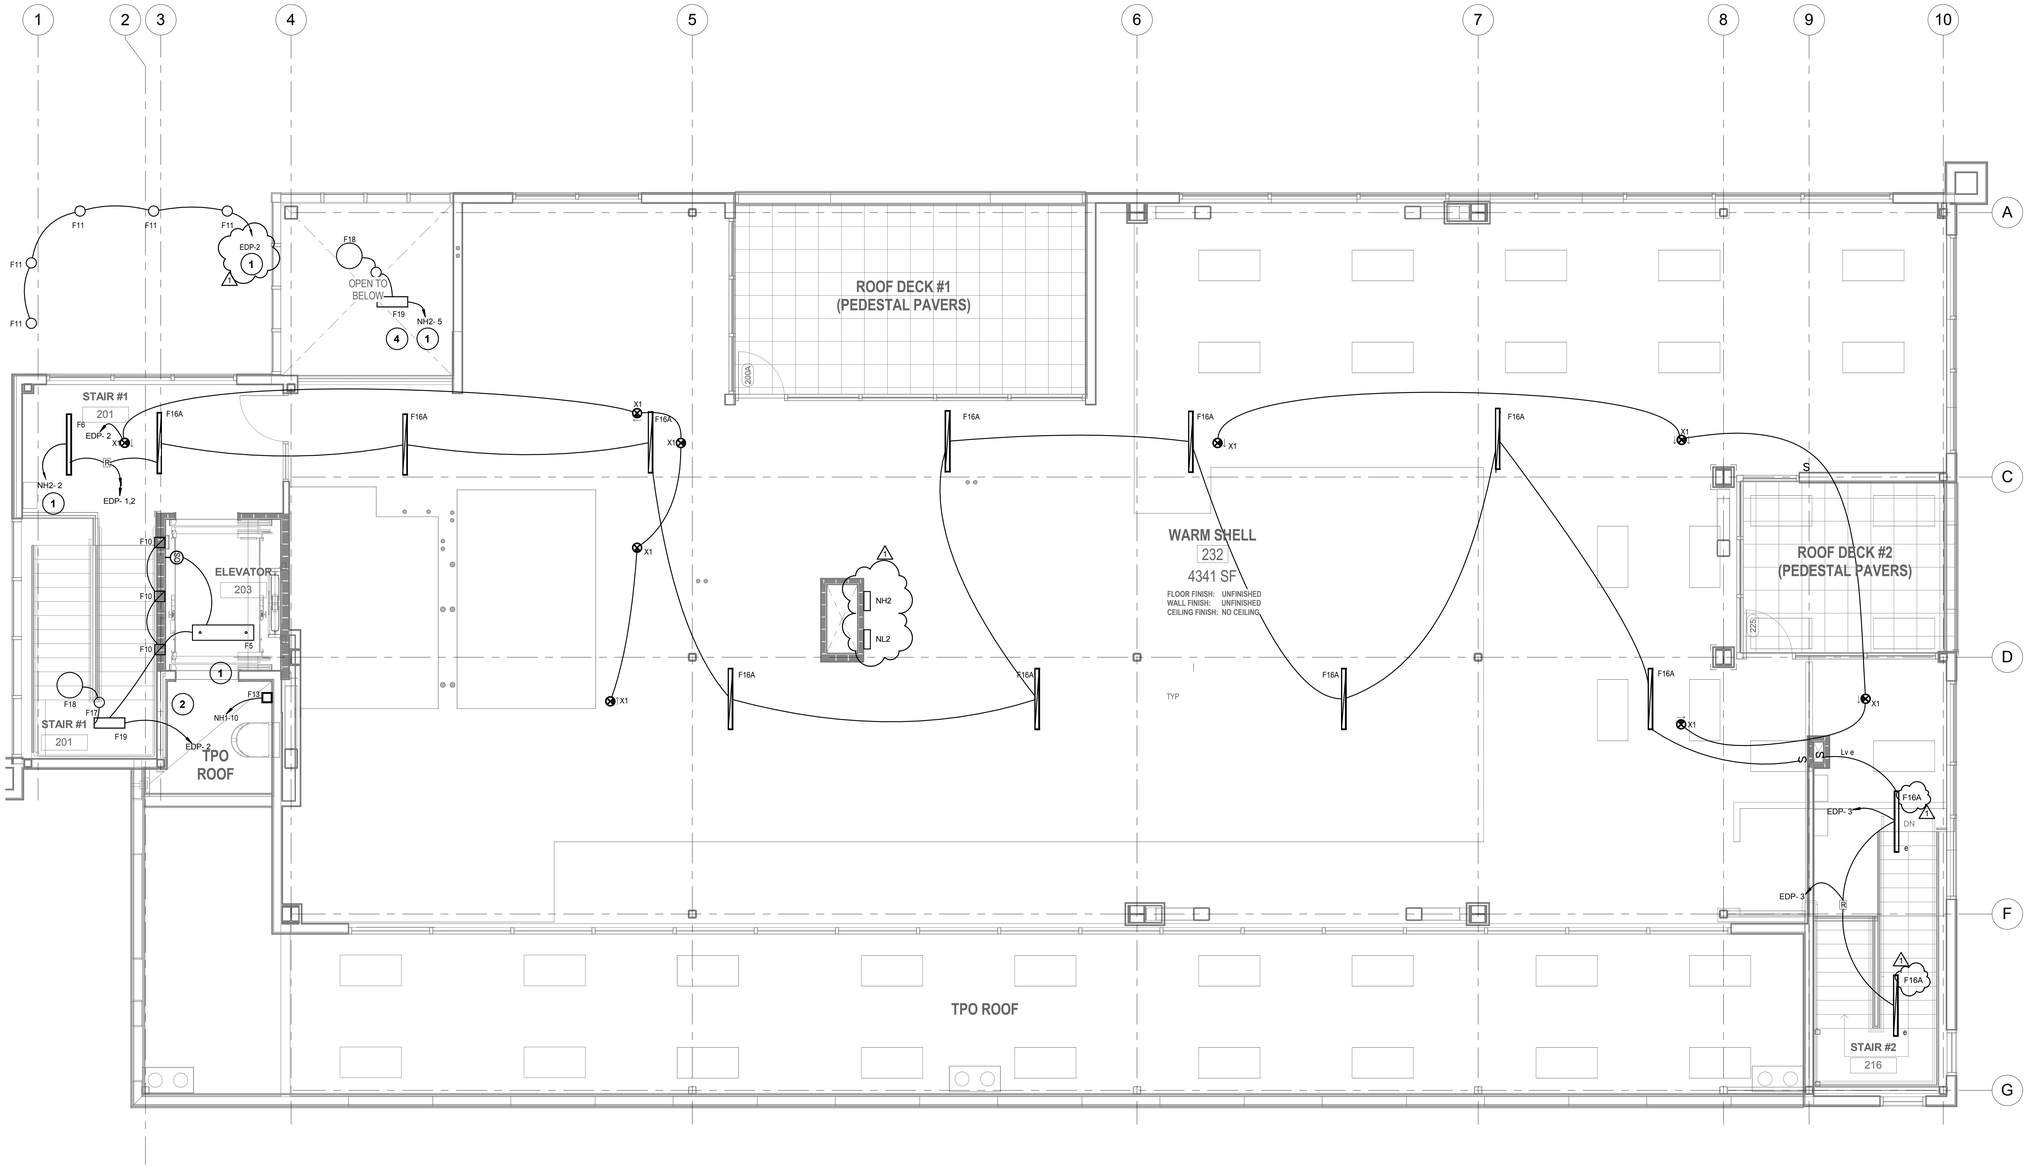

1 LIGHTING PLAN - SECOND FLOOR - DEDUCT ALT. #14
1/4" = 1'-0"

GENERAL SHEET NOTES

A. REFER TO THE ARCHITECTURAL DRAWINGS REFLECTED CEILING PLAN FOR EXACT LUMINAIRE LOCATIONS.

B. ALL CONTROL SWITCHES AND SWITCHING ARE LOW VOLTAGE WIRING. REFER TO SHEET E6.02 FOR LIGHTING CONTROL SWITCHING DIAGRAMS.

C. REFER TO LIGHTING CONTROL RELAY PANEL SCHEDULE FOR ADDITIONAL INFORMATION ON LOW VOLTAGE CONTROL SWITCHING AND LIGHTING RELAY INTERFACE. SEE SHEET E6.02

D. CONTRACTOR SHALL INSTALL LOW VOLTAGE CONTROL DIMMER SWITCH AT DIRTT FURNITURE SYSTEM (FFE). COORDINATE INSTALATION. PROVIDE COMPLETE CLEAN AND OPERABLE SYSTEM.

KEY NOTES

1. ROUTE HOMERUN VIA LIGHTING CONTROL RELAY PANEL 'LCP'
2. ROUTE HOMERUN VIA TRANSFORMER. PROVIDE 277V TO 120V STEP DOWN CONTROL TRANSFORMER i.e. 200VA TRANSFORMER IN AN ENCLOSURE TO BE MOUNTED ADJACENT 277V PANEL.

100% CONSTRUCTION DOCUMENT SUBMISSION
APRIL 20, 2015

DELTA 1	ADDENDUM #1	7/31/2015
Revisions:		Date

CONSULTANTS:

MAZZETTI
220 Montgomery Street, Suite 650
San Francisco, CA 94104
TEL: 415.632.3266
www.mazzetti.com
PROJECT NUMBER: 130-055

ARCHITECT

POLYTECH ASSOCIATES INC

POLYTECH ASSOCIATES INC.
235 Pine Street, 17th Floor
San Francisco, CA 94104
TEL (415) 397-3117
FAX (415) 397-1517

Drawing Title	DEDUCTIVE ALTERNATE #14 - LIGHTING PLAN SECOND FLOOR
Approved: Project Director	
Project Title	NEUROCOG TBI RESEARCH BUILDING / BUILDING R4 DEMOLITION / NEW PARKING LOT
Location	150 MUIR ROAD, MARTINEZ, CA 94553
Date	04/09/15
Checked	Author
Drawn	Checker
Project Number	612-125
Building Number	
Drawing Number	EL102C

Office of Construction and Facilities Management
Department of Veterans Affairs