


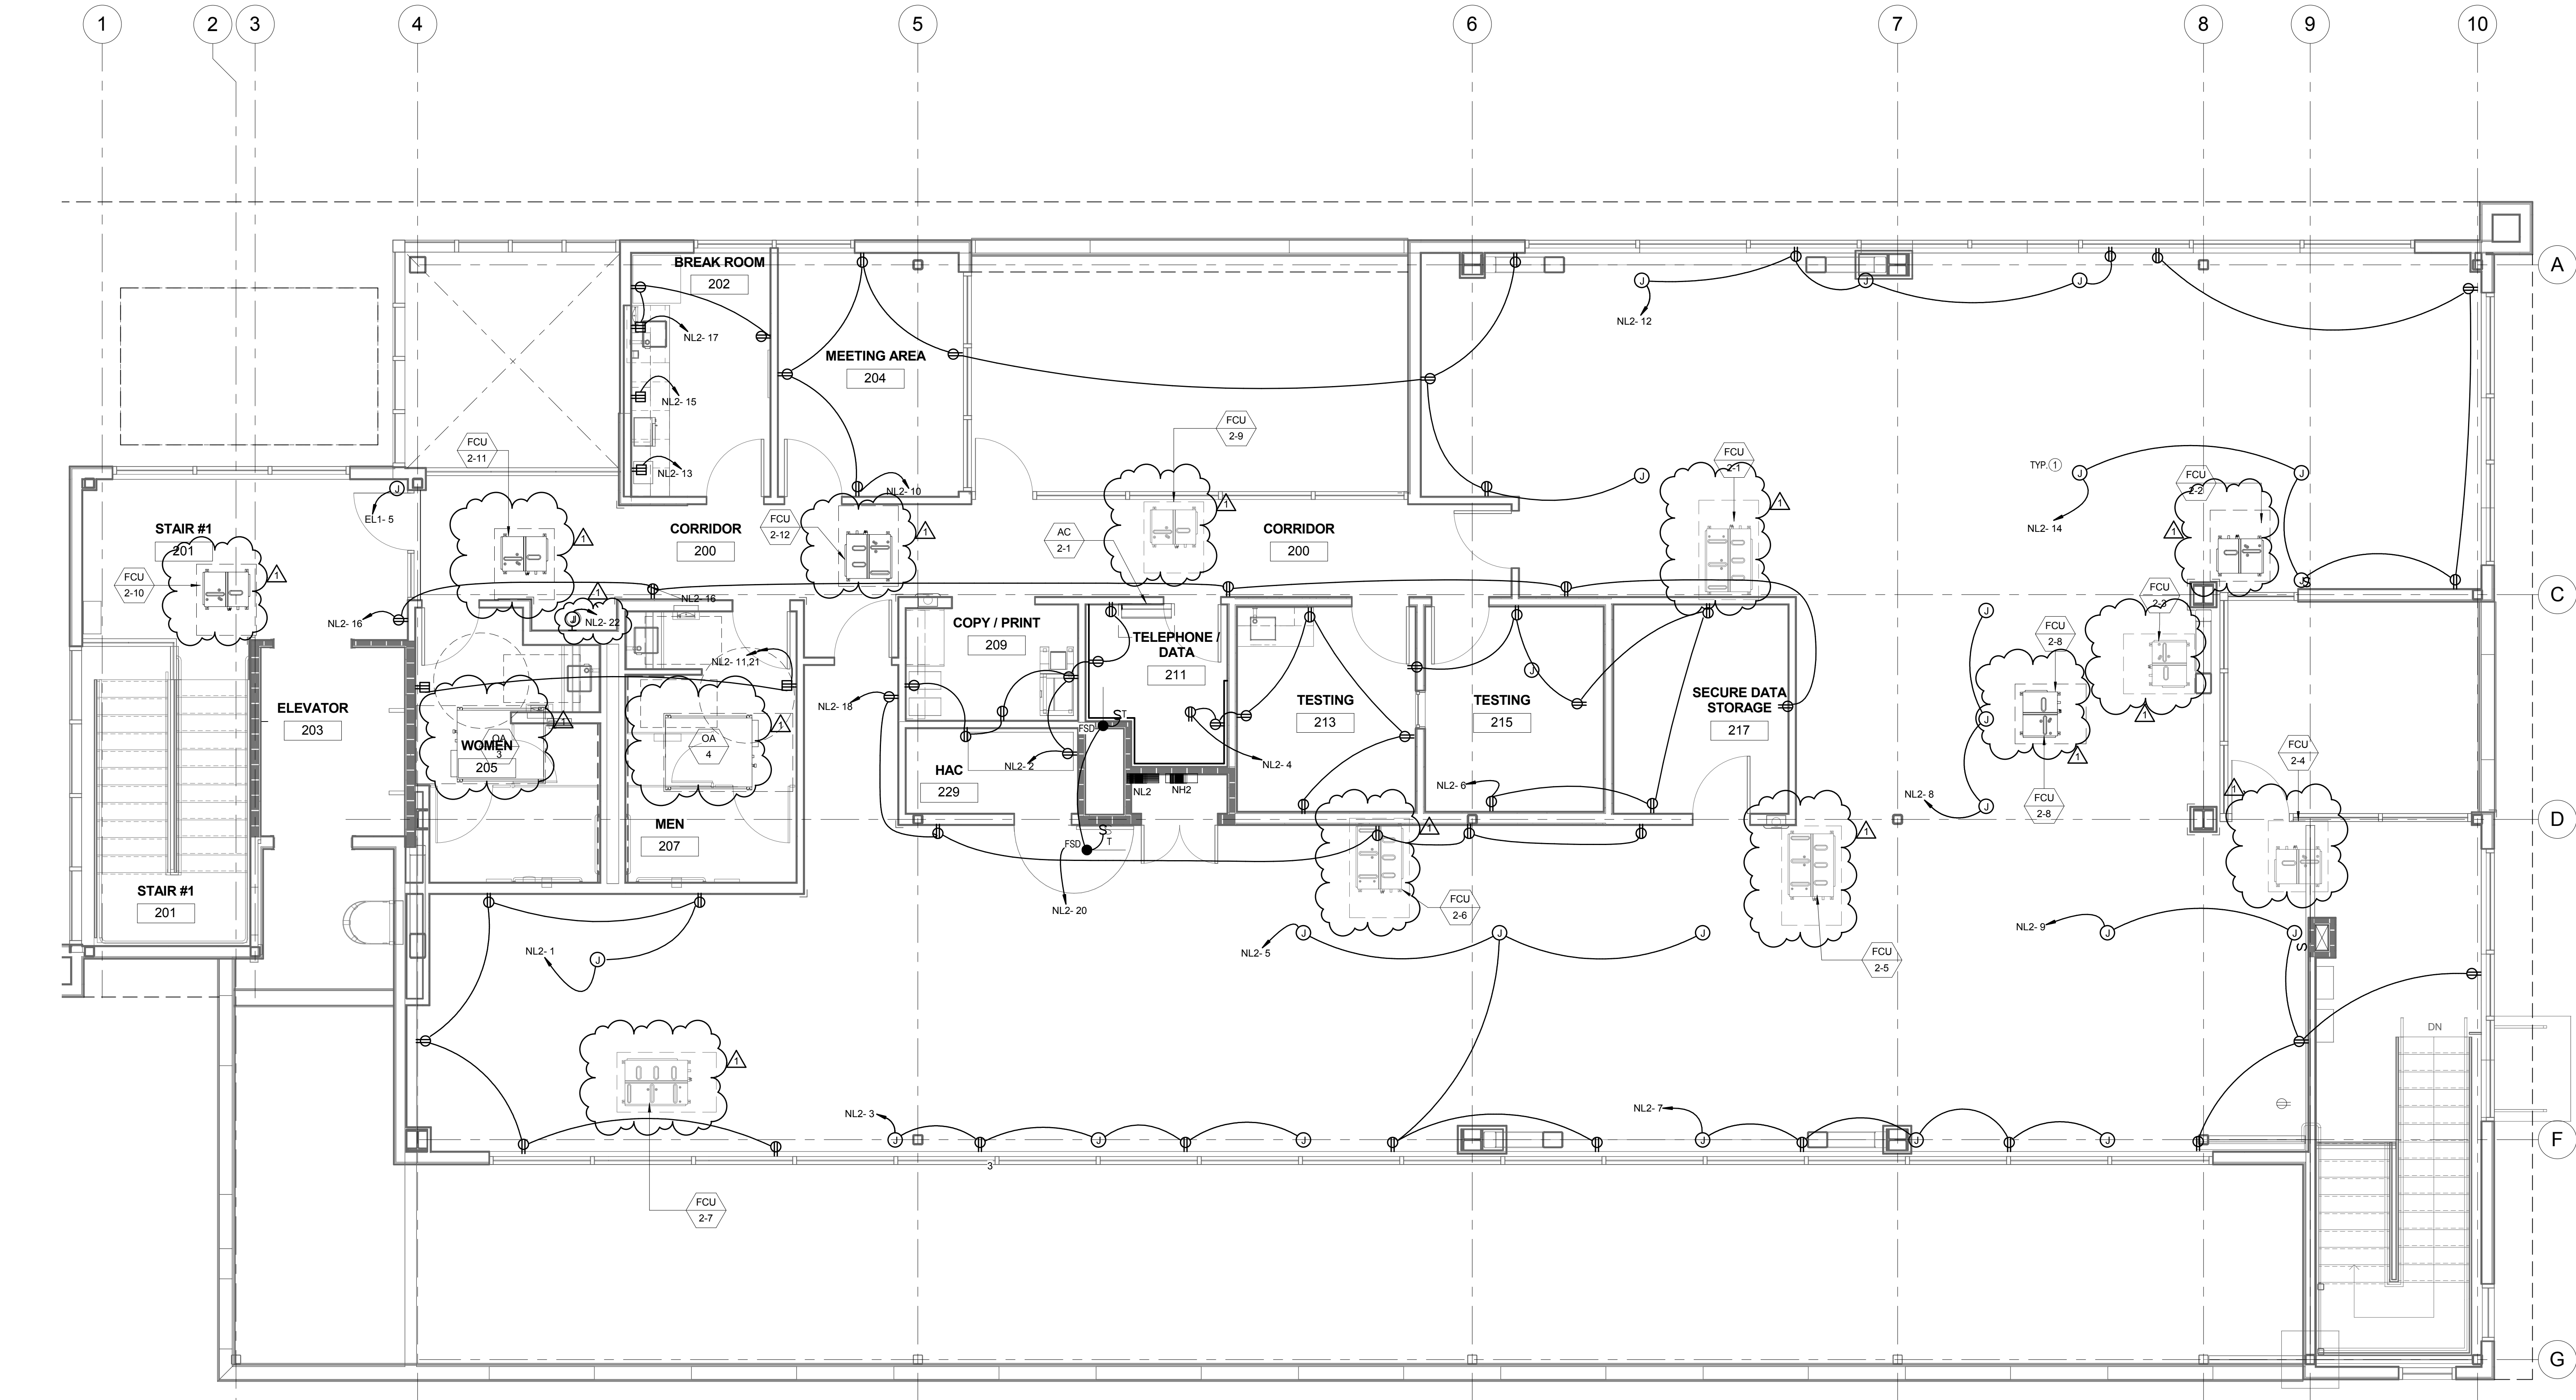

1 POWER PLAN - SECOND FLOOR  
1/4" = 1'-0"

GENERAL SHEET NOTES

A. COORDINATE CIRCUIT CONNECTIONS TO OUTLETS PROVIDED UNDER THE DIRTT SYSTEM. THERE SHALL BE 6-8 DUPLEX OUTLETS PER CIRCUIT.

KEY NOTES

1 JUNCTION BOX ACCESS FEED TO DIRTT FURNITURE SYSTEM (FFE).

100% CONSTRUCTION DOCUMENT SUBMISSION  
APRIL 20, 2015

<div>DELTA 1</div> <div>ADDENDUM #1</div> <div>7/31/2015</div> <div>Revisions:</div> <div>Date</div>	<div>CONSULTANTS:</div> <div><div>MAZZETTI</div><div>220 Montgomery Street, Suite 650 San Francisco, CA 94104 TEL: 415.632.3966 www.mazzetti.com</div><div>PROJECT NUMBER: 130-055</div></div>	<div><div>REGISTERED PROFESSIONAL ENGINEER ELECTRICAL STATE OF CALIFORNIA No. 51876 Exp. 12/31/15</div></div>	<div>ARCHITECT</div> <div><div>POLYTECH ASSOCIATES INC.</div><div>235 Pine Street, 17th Floor San Francisco, CA 94104 TEL (415) 397-3117 FAX (415) 397-1517</div></div>	<div>Drawing Title</div> <div>POWER PLAN - SECOND FLOOR</div> <div>Approved: Project Director</div>	<div>Project Title</div> <div>NEUROCOG TBI RESEARCH BUILDING / BUILDING R4 DEMOLITION / NEW PARKING LOT</div> <div>Location</div> <div>150 MIJR ROAD, MARTINEZ, CA 94553</div> <div>Date</div> <div>3/18/15</div> <div>Checked</div> <div>Author</div> <div>Drawn</div> <div>Checker</div>	<div>Project Number</div> <div>612-125</div> <div>Building Number</div> <div></div> <div>Drawing Number</div> <div>EP102</div>	<div>Office of Construction and Facilities Management</div> <div><div>Department of Veterans Affairs</div></div>
--	--	---	---	---	--	--	--