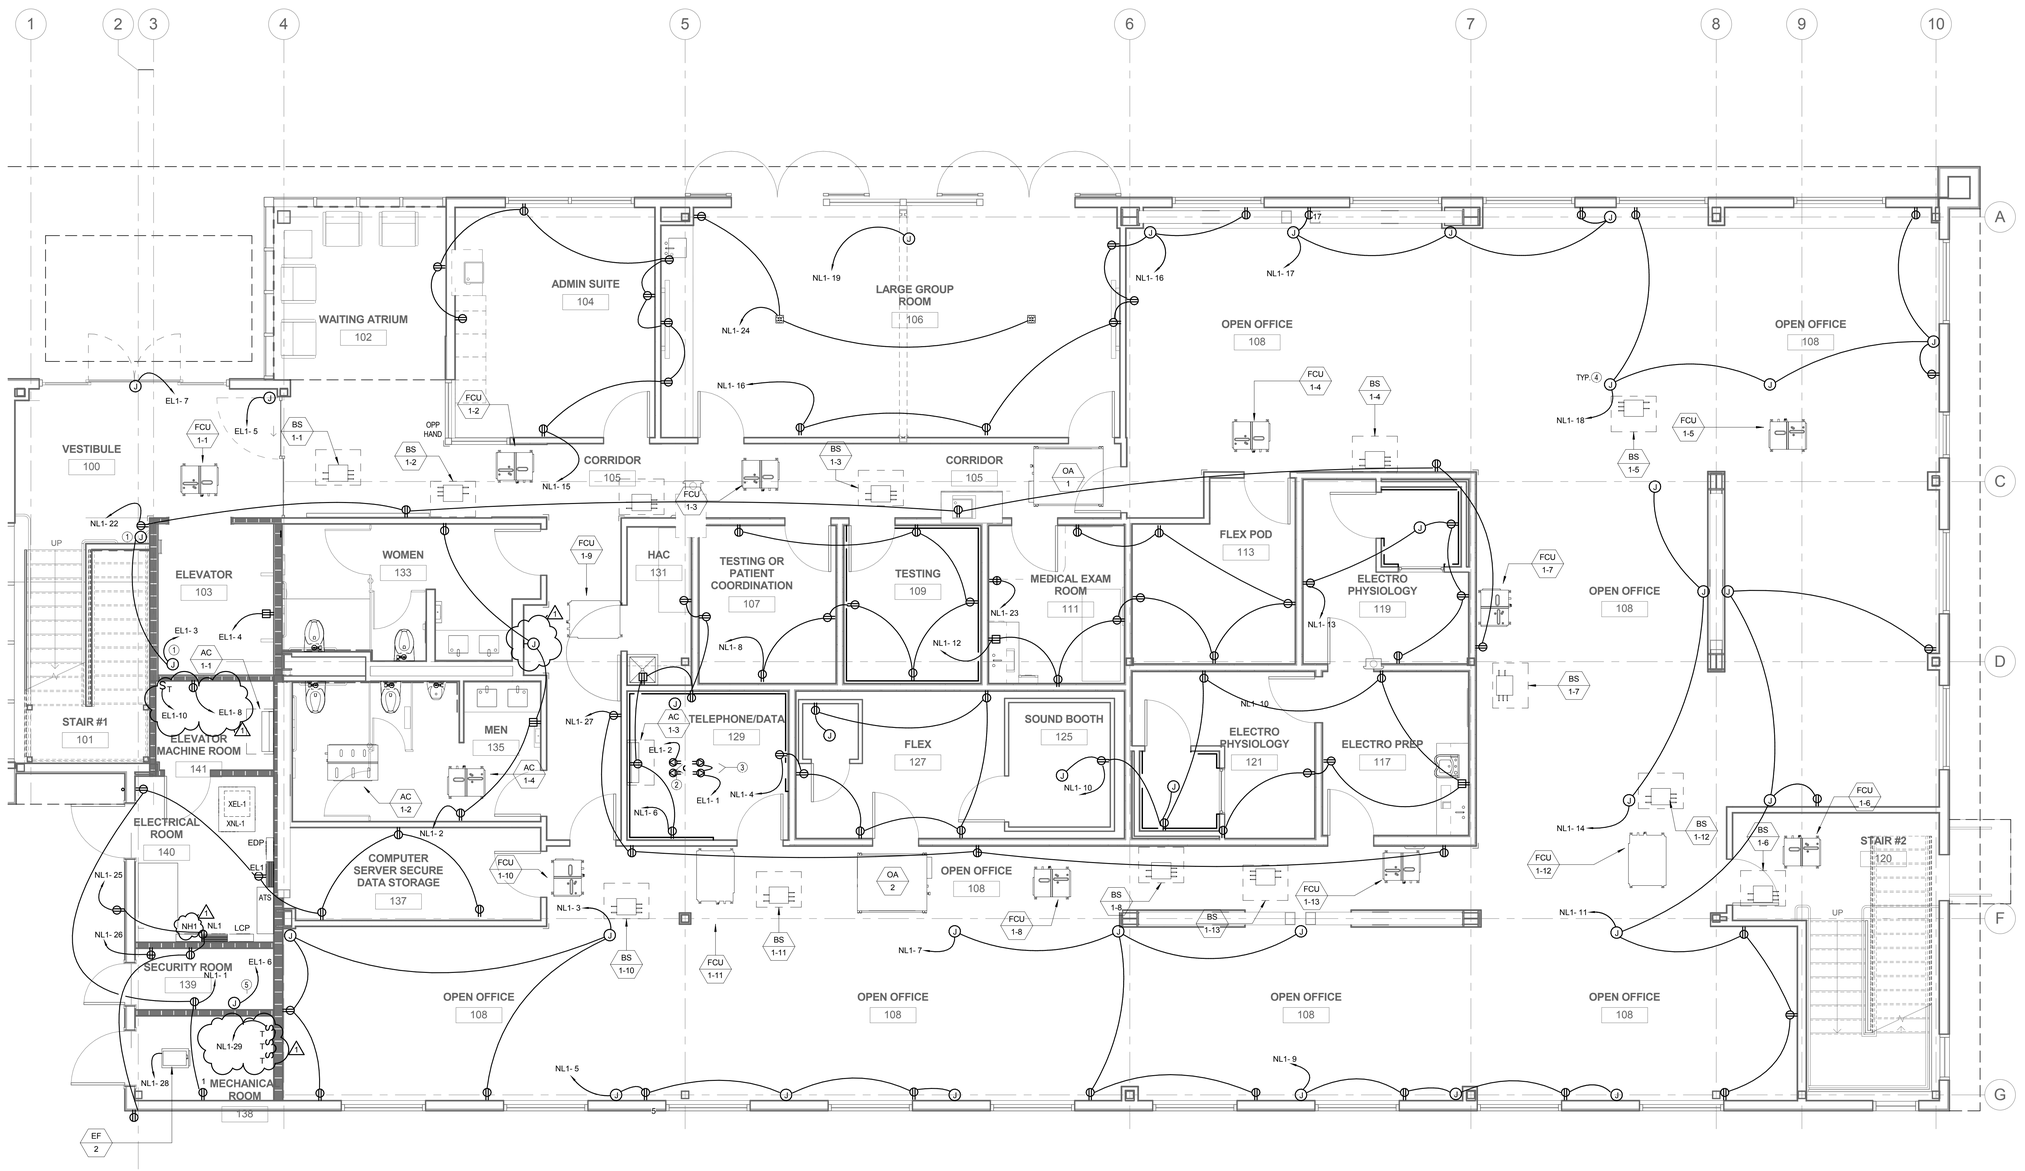

1 POWER PLAN - FIRST FLOOR
1/4" = 1'-0"

GENERAL SHEET NOTES

A. COORDINATE CIRCUIT CONNECTIONS TO OUTLETS PROVIDED UNDER THE DIRTT SYSTEM. THERE SHALL BE 6-8 DUPLEX OUTLETS PER CIRCUIT.

KEY NOTES

1. SUMP PUMP AND PUMP CONTROLER. SEE SHEET PP301 DETAIL # 1.
2. 30 AMP TWIST-LOCK NEMA L15-30 OUTLET
3. 20 AMP TWIST-LOCK NEMA L15-20 OUTLET
4. JUNCTION BOX ACCESS FEED TO DIRTT FURNITURE SYSTEM (FFE).
5. FIRE ALARM CONTROL PANEL.

100% CONSTRUCTION DOCUMENT SUBMISSION
APRIL 20, 2015

DELTA 1	ADDENDUM #1	7/31/2015
Revisions:		Date

CONSULTANTS:

MAZZETTI
220 Montgomery Street, Suite 650
San Francisco, CA 94104
TEL: 415.632.3266
www.mazzetti.com
PROJECT NUMBER: 130-055

JESSE A. ERY — C18855 — 12/31/15 — ELECTRICAL — STATE OF CALIFORNIA

ARCHITECT

POLYTECH ASSOCIATES INC

POLYTECH ASSOCIATES INC.
235 Pine Street, 17th Floor
San Francisco, CA 94104
TEL (415) 397-3117
FAX (415) 397-1517

Drawing Title: POWER PLAN - FIRST FLOOR
Approved: Project Director
Project Title: NEUROCOG TBI RESEARCH BUILDING / BUILDING R4 DEMOLITION / NEW PARKING LOT
Location: 150 MUIR ROAD, MARTINEZ, CA 94553
Date: 3/18/15
Checked: Author
Drawn: Checker
Project Number: 612-125
Building Number:
Drawing Number: EP101

Office of Construction and Facilities Management
Department of Veterans Affairs