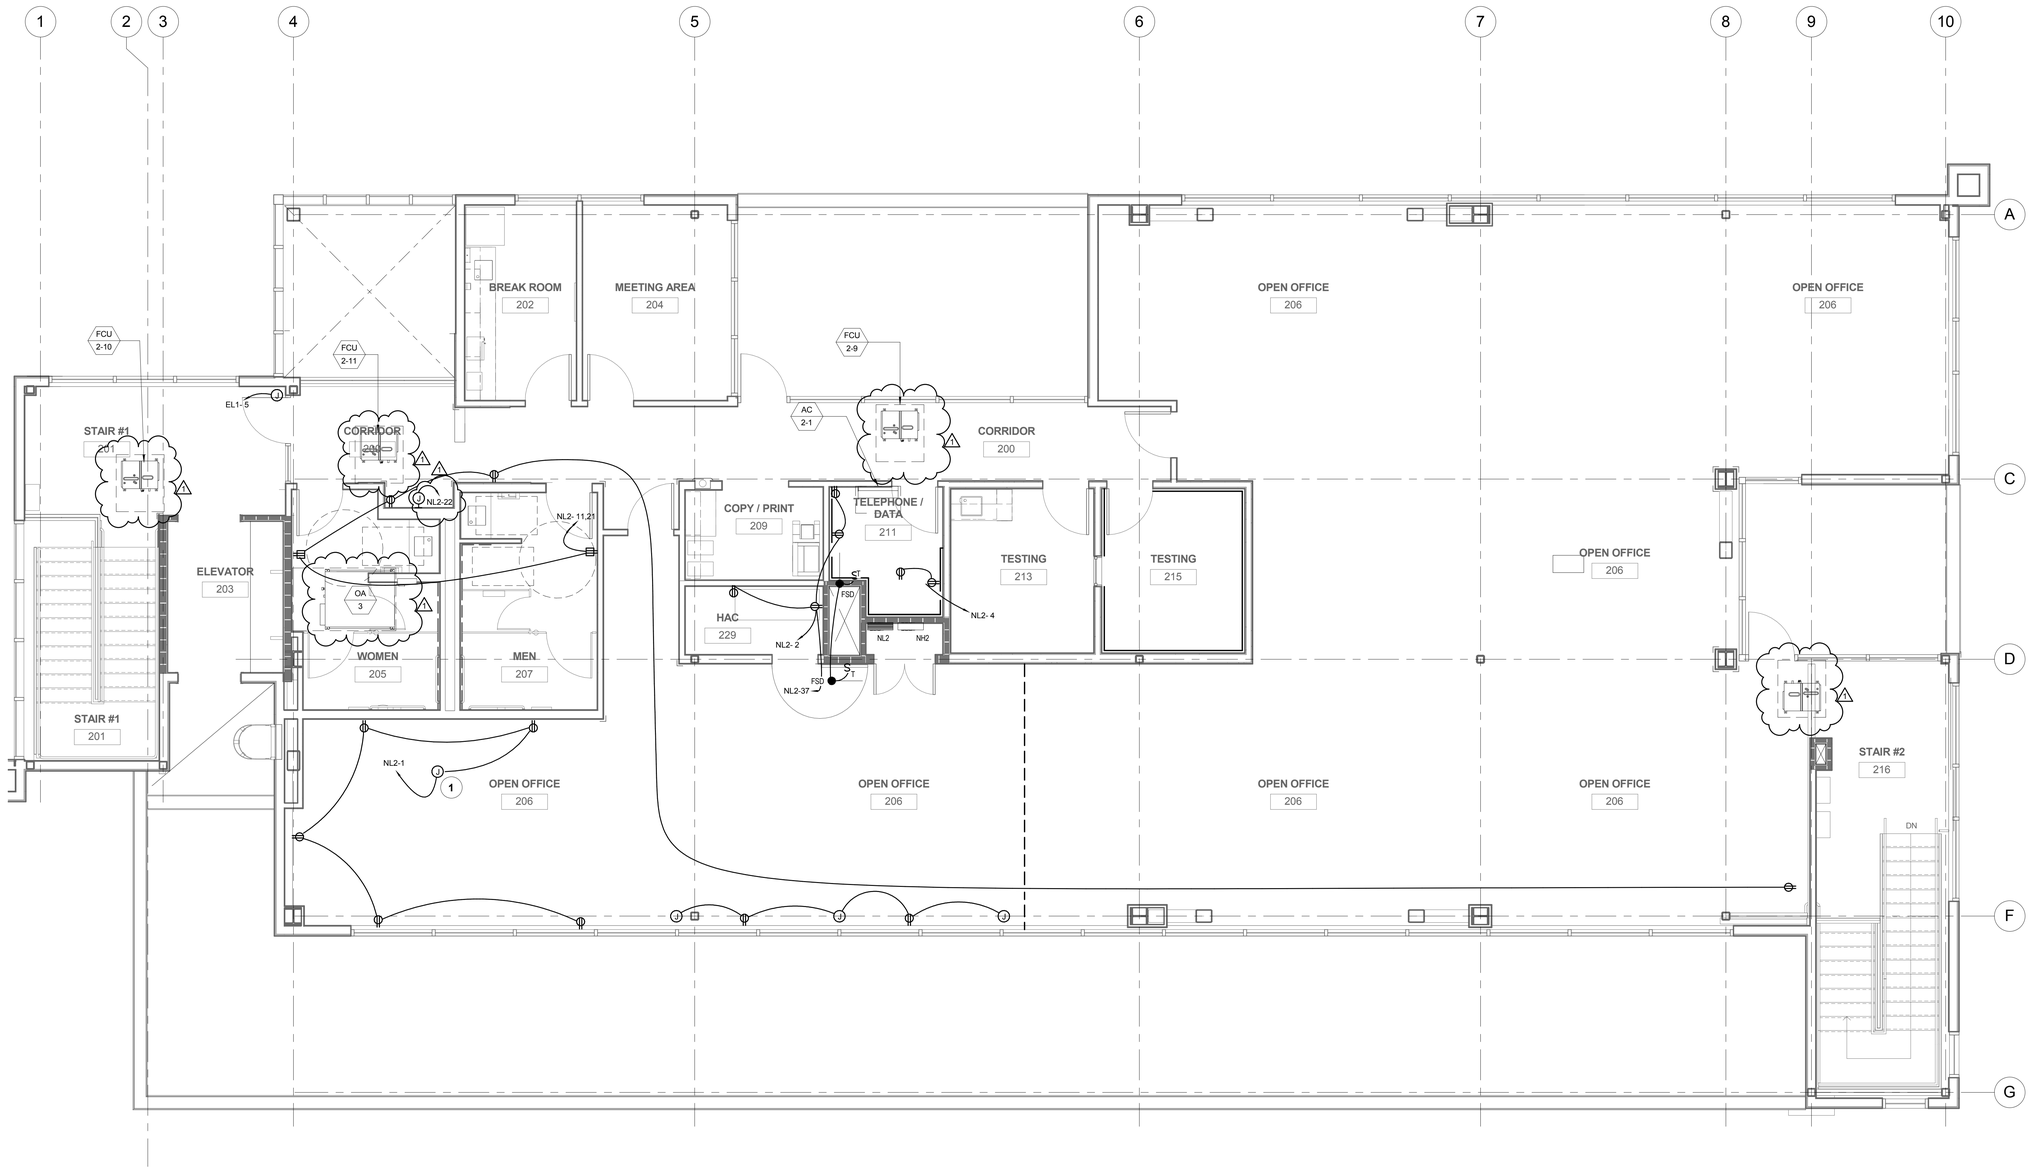

1 POWER PLAN - SECOND FLOOR - DEDUCT ALT. #13A
1/4" = 1'-0"

GENERAL SHEET NOTES

A. COORDINATE CIRCUIT CONNECTIONS TO OUTLETS PROVIDED UNDER THE DIRTT SYSTEM. THERE SHALL BE 6-8 DUPLEX OUTLETS PER CIRCUIT.

KEY NOTES

1 JUNCTION BOX ACCESS FEED TO CIRTT FURNITURE SYSTEM (FFE).

100% CONSTRUCTION DOCUMENT SUBMISSION
APRIL 20, 2015

DELTA 1	ADDENDUM #1	7/31/2015
Revisions:		Date

CONSULTANTS:

MAZZETTI
220 Montgomery Street, Suite 650
San Francisco, CA 94104
TEL: 415.632.3266
www.mazzetti.com
PROJECT NUMBER: 130-055

REGISTERED PROFESSIONAL ENGINEER
JESSE AVERY
E18856
EXP. 12/31/15
ELECTRICAL
STATE OF CALIFORNIA

ARCHITECT

POLYTECH ASSOCIATES INC

POLYTECH ASSOCIATES INC.
235 Pine Street, 17th Floor
San Francisco, CA 94104
TEL (415) 397-3117
FAX (415) 397-1517

Drawing Title
DEDUCTIVE ALTERNATE #13A - POWER PLAN SECOND FLOOR

Approved: Project Director

Project Title
NEUROCOG TBI RESEARCH BUILDING / BUILDING R4 DEMOLITION / NEW PARKING LOT

Location
150 MUIR ROAD, MARTINEZ, CA 94553

Date	Checked	Drawn
04/09/15	Author	Checker

Project Number
612-125

Building Number

Drawing Number
EP102B

Office of Construction and Facilities Management

Department of Veterans Affairs