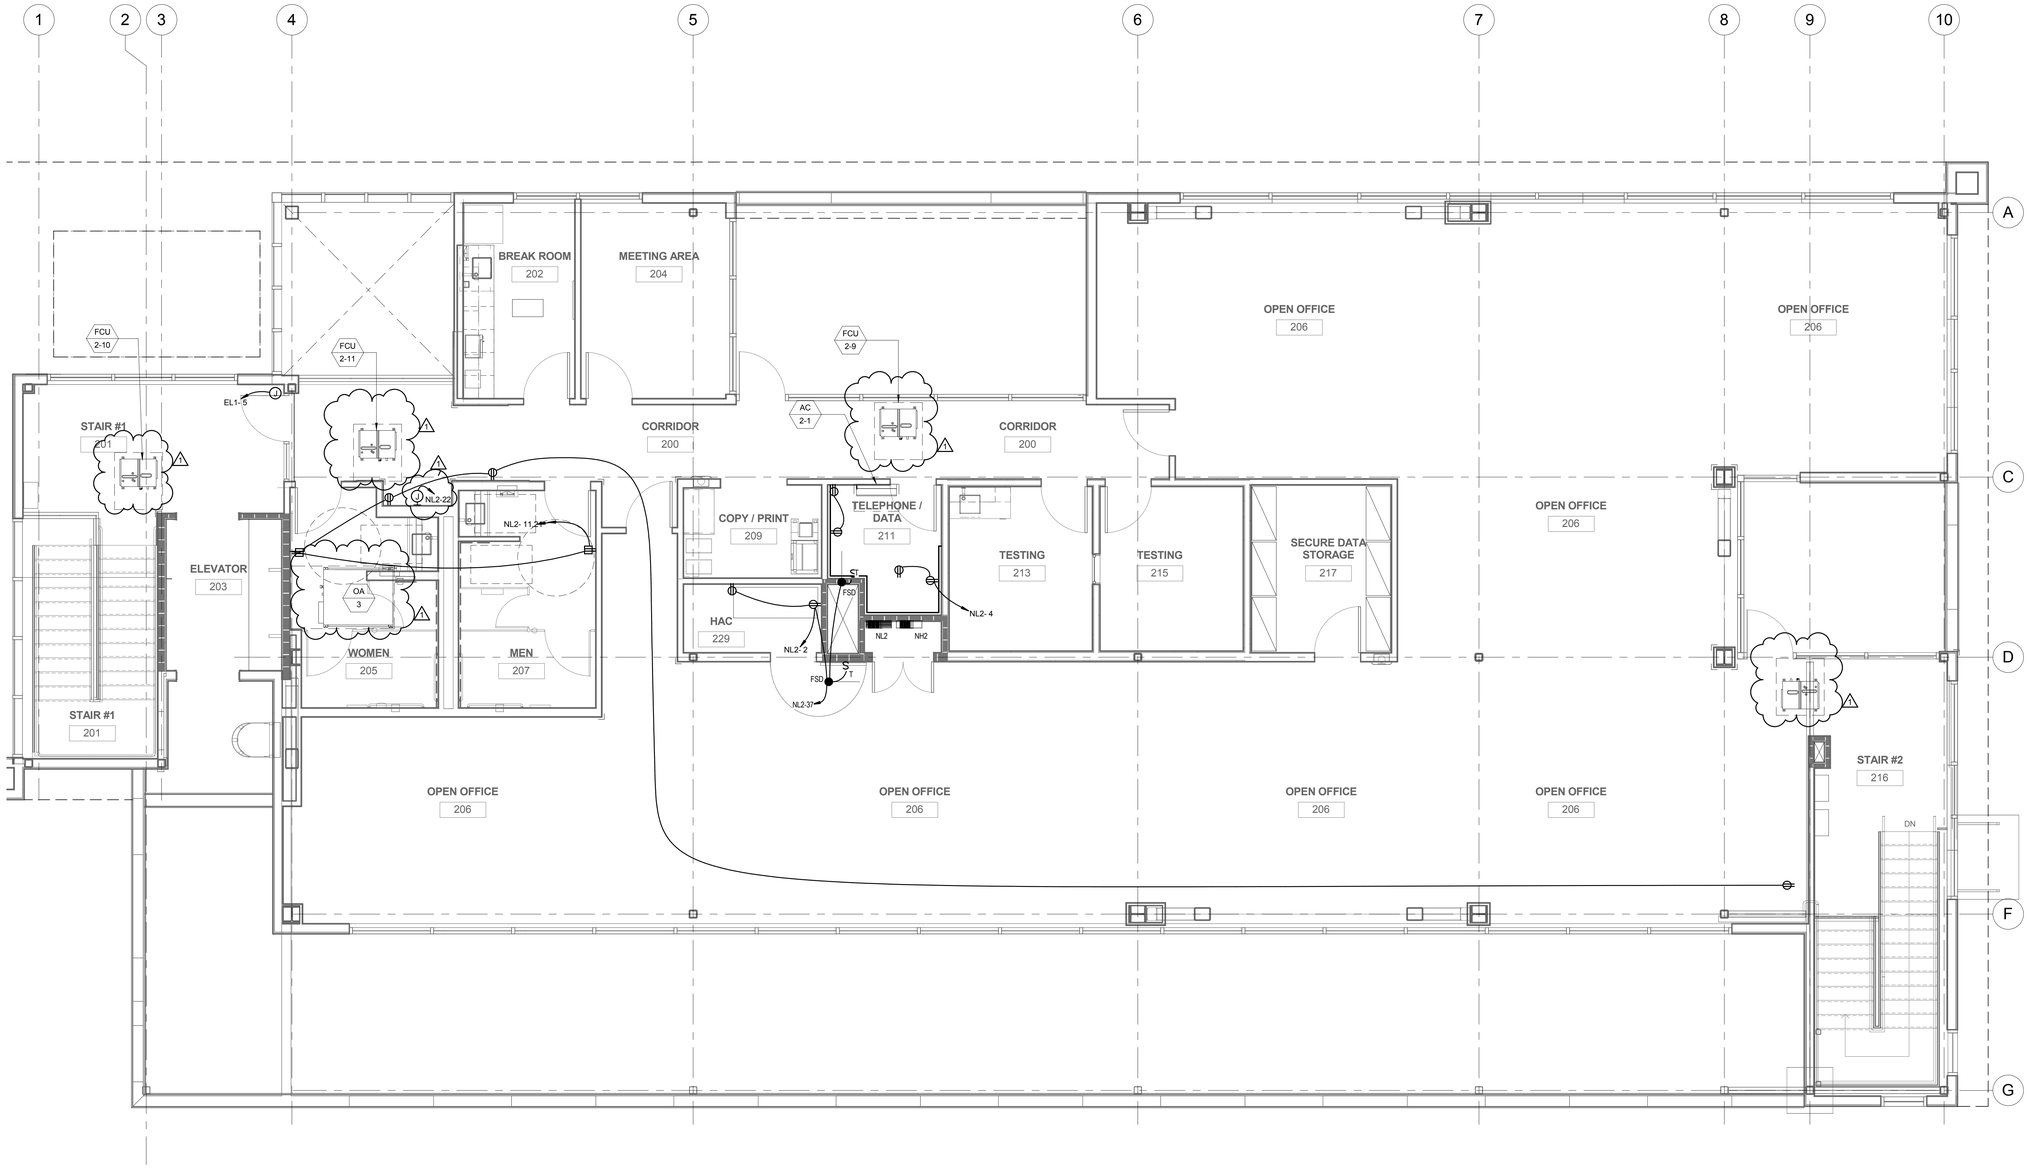

1 POWER PLAN - SECOND FLOOR - DEDUCT ALT. #13
1/4" = 1'-0"

GENERAL SHEET NOTES

KEY NOTES

100% CONSTRUCTION DOCUMENT SUBMISSION
APRIL 20, 2015

Revisions:	Date
DELTA 1 ADDENDUM #1	7/31/2015

CONSULTANTS:

MAZZETTI
220 Montgomery Street, Suite 650
San Francisco, CA 94104
TEL: 415.632.3266
www.mazzetti.com
PROJECT NUMBER: 130-055

LICENSED PROFESSIONAL ENGINEER JESSE ALEXANDER PAUL C 18456 ELECTRICAL STATE OF CALIFORNIA

ARCHITECT

POLYTECH ASSOCIATES INC.
235 Pine Street, 17th Floor
San Francisco, CA 94104
TEL (415) 397-3117
FAX (415) 397-1517

Drawing Title	DEDUCTIVE ALTERNATE #13 - POWER PLAN SECOND FLOOR
Approved: Project Director	
Project Title	NEUROCOG TBI RESEARCH BUILDING / BUILDING R4 DEMOLITION / NEW PARKING LOT
Location	150 MUIR ROAD, MARTINEZ, CA 94553
Date	3/18/15
Checked	Author
Drawn	Checker
Project Number	612-125
Building Number	
Drawing Number	EP102A

Office of Construction and Facilities Management
Department of Veterans Affairs