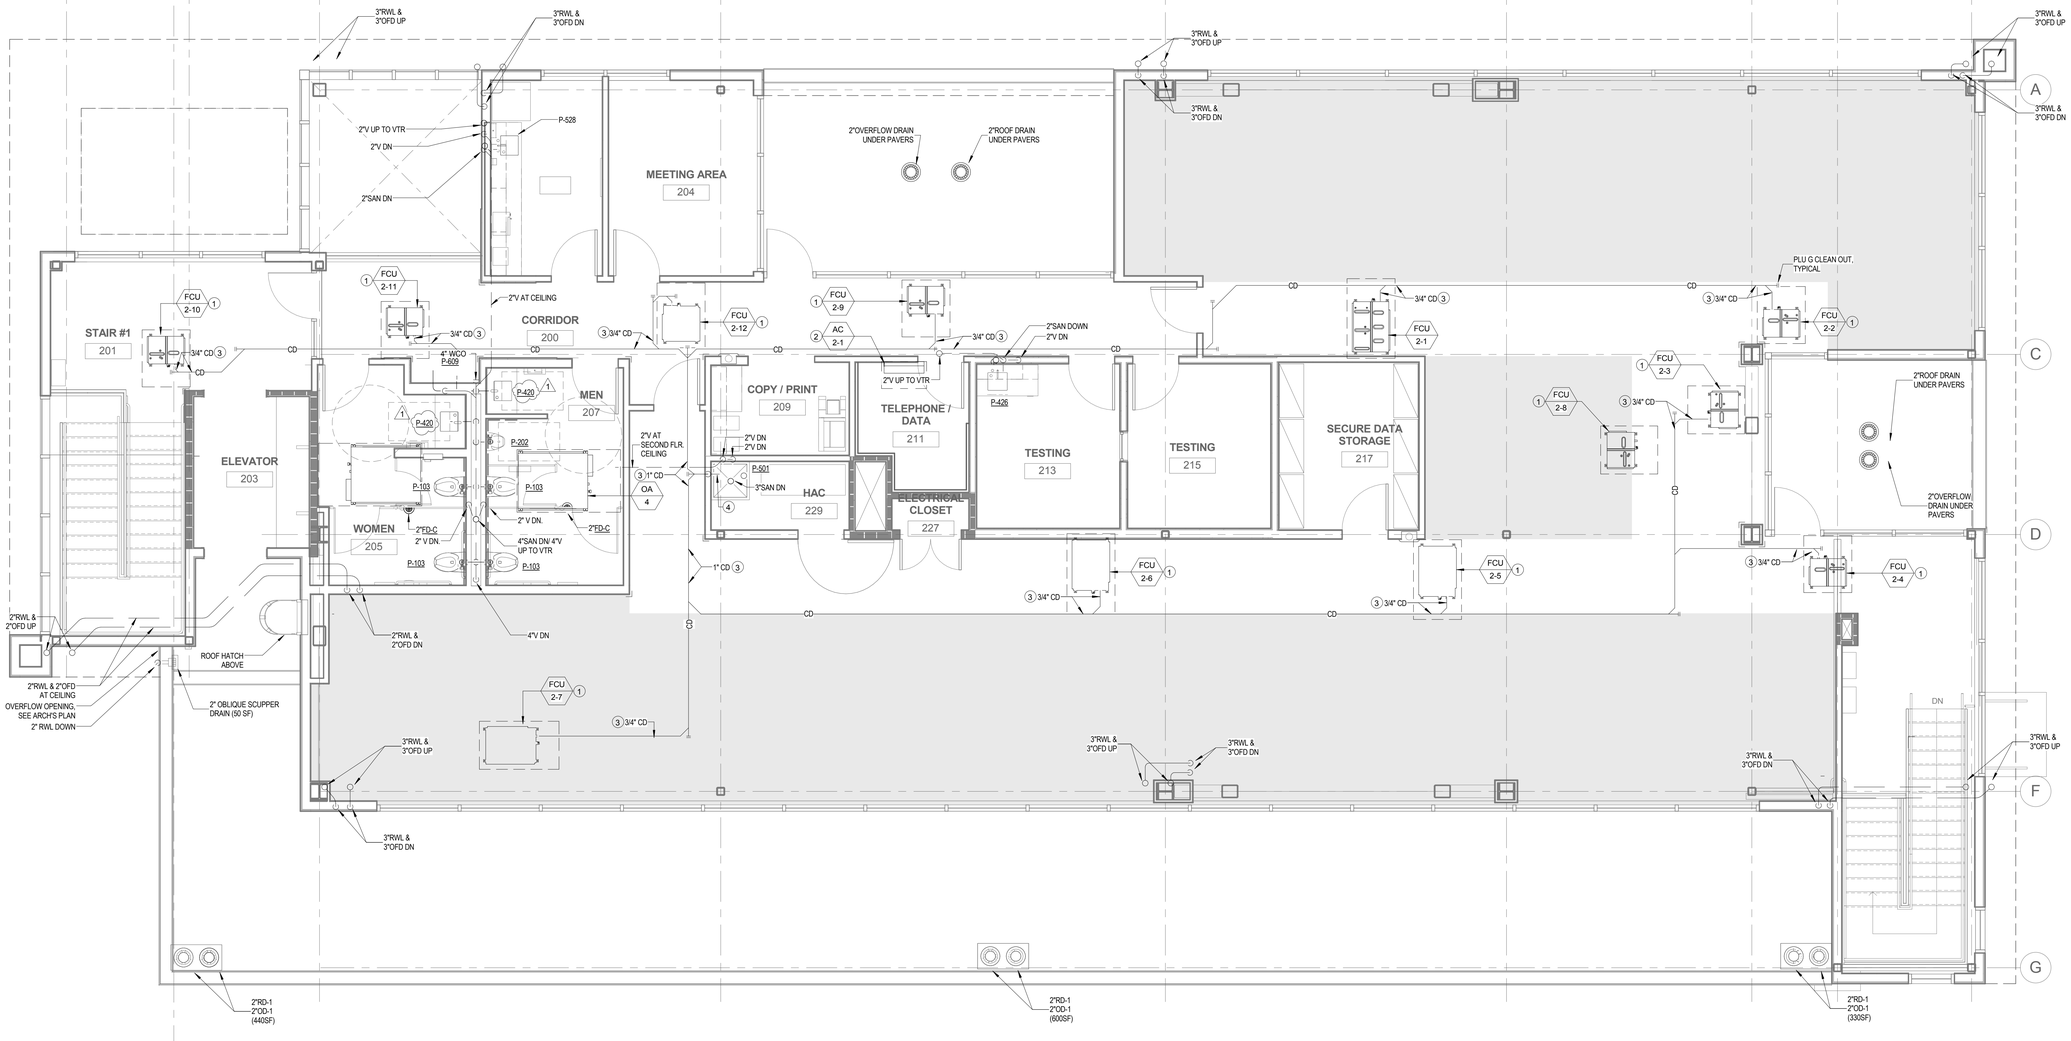

PLUMBING PLAN - SECOND FLOOR
WASTE
1/4" = 1'-0"

GENERAL SHEET NOTES

1. PROVIDE CONDENSATE DRAINAGE PIPING FROM FAN COIL UNITS (SEE MECHANICAL PLANS) TO TERMINATE AT SERVICE SINK (P-501).

KEY NOTES

1 FAN COIL UNIT, SEE MECHANICAL PLANS. INSTALL CONDENSATE DRAIN IN ACCORDANCE WITH MANUFACTURER & PUBLISHED INSTALLATION INSTRUCTIONS.

2 AC UNIT, SEE MECHANICAL PLANS. INSTALL CONDENSATE DRAIN IN ACCORDANCE WITH MANUFACTURER & PUBLISHED INSTALLATION INSTRUCTIONS.

3 CONDENSATE DRAIN (CD) PIPING SLOPE AT 1/8" PER FOOT. SIZE AS NOTED.

4 1" CD TO TERMINATE 6" ABOVE SERVICE SINK.

100% CONSTRUCTION DOCUMENT SUBMISSION
APRIL 20, 2015

DELTA 1	ADDENDUM #1	7/31/2015
Revisions:		Date

CONSULTANTS:

MAZZETTI
220 Montgomery Street, Suite 650
San Francisco, CA 94104
TEL: 415.632.3056
www.mazzetti.com
PROJECT NUMBER: 130-055

ARCHITECT

POLYTECH ASSOCIATES INC

POLYTECH ASSOCIATES INC.
235 Pine Street, 17th Floor
San Francisco, CA 94104
TEL (415) 397-3117
FAX (415) 397-1517

Drawing Title: PLUMBING WASTE, DRAIN AND VENT PIPING PLAN -SECOND FLOOR

Approved: Project Director

Project Title: NEUROCOG TBI RESEARCH BUILDING / BUILDING R4 DEMOLITION / NEW PARKING LOT

Location: 150 MUIR ROAD, MARTINEZ, CA 94553

Date: 10/20/14 | Checked: MT | Drawn: NS

Project Number: 612-125

Building Number:

Drawing Number: PL102

Office of Construction and Facilities Management

Department of Veterans Affairs