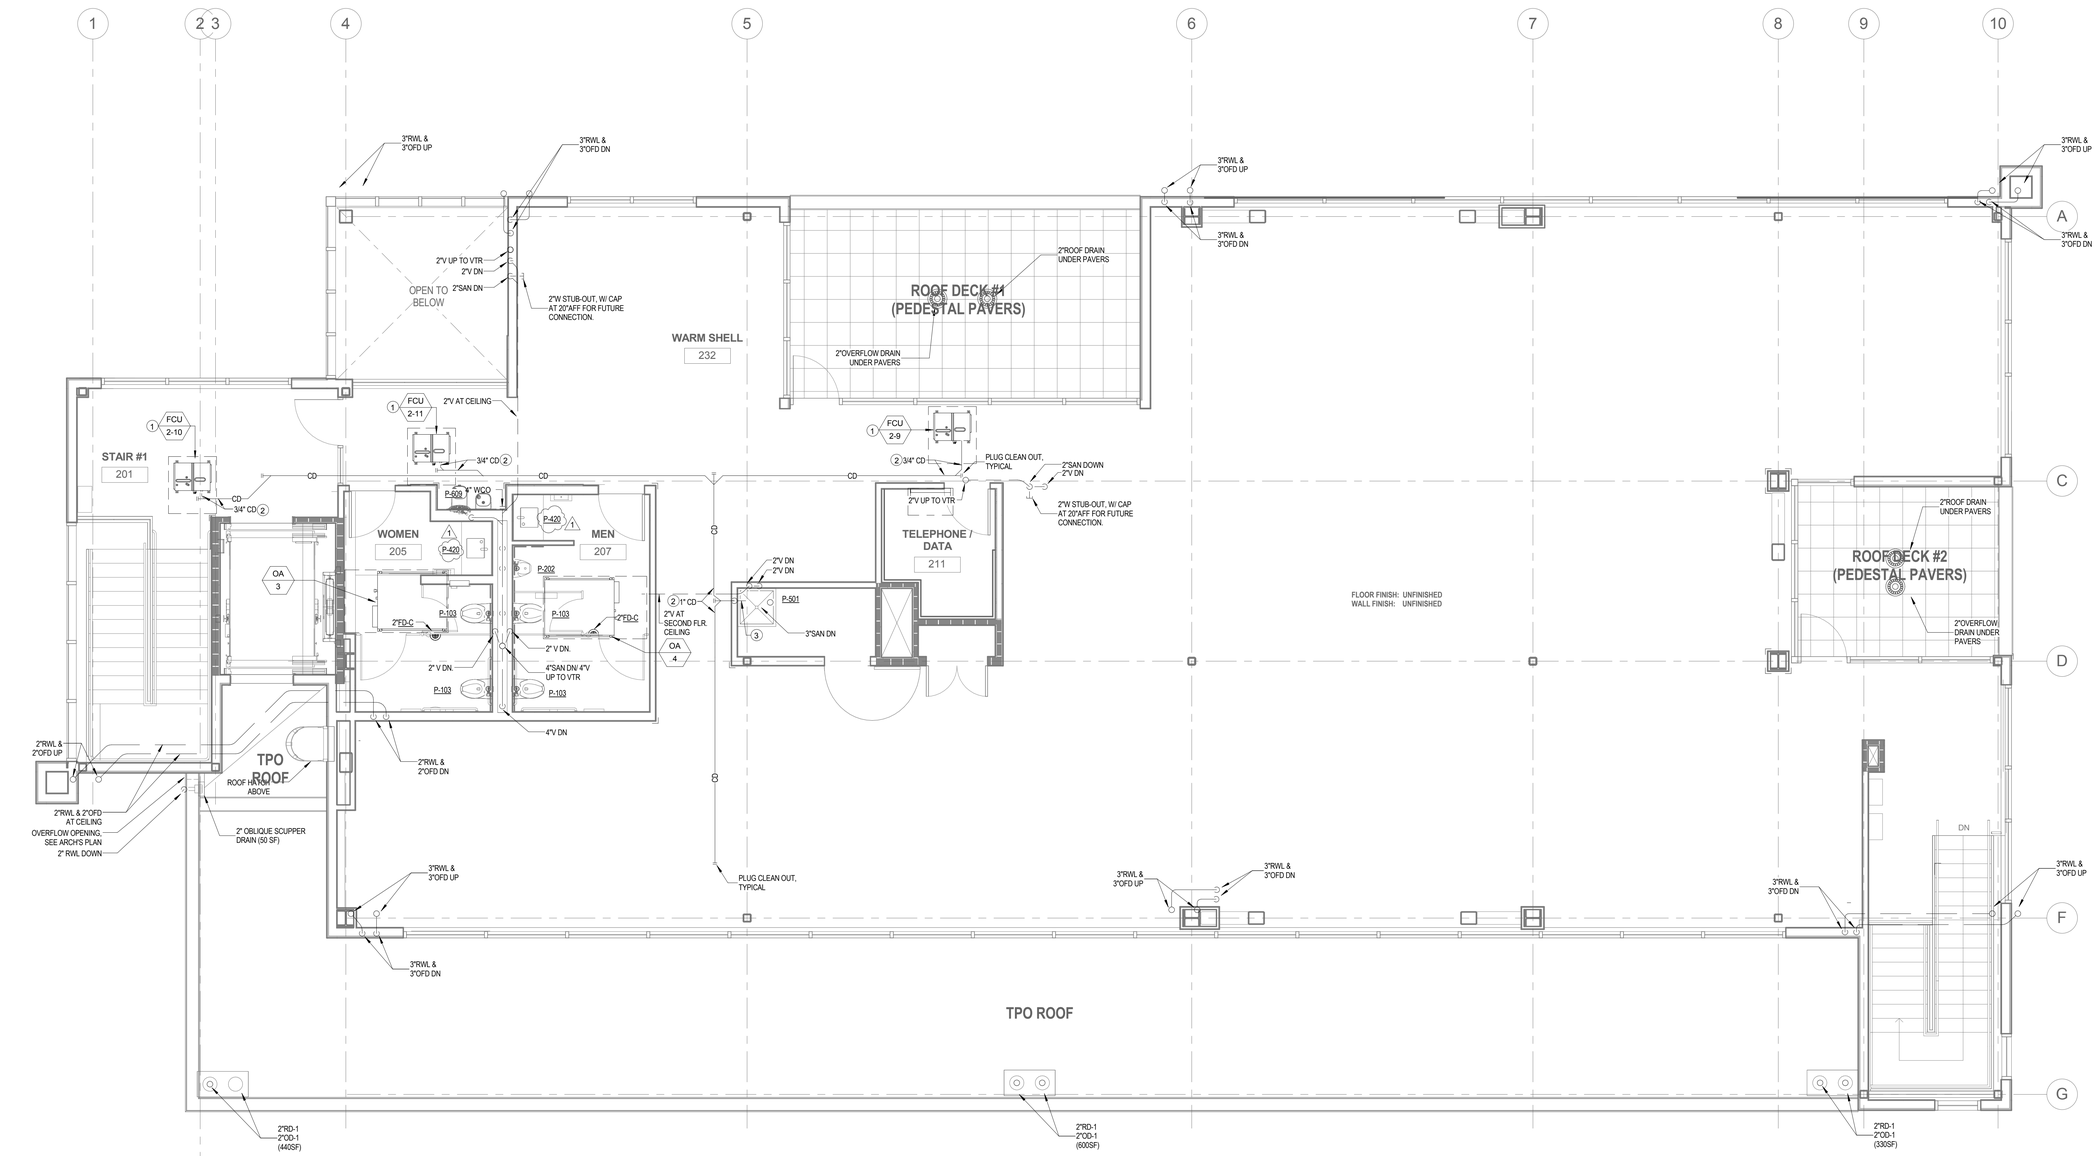

1 PLUMBING PLAN - SECOND FLOOR
WASTE-DEDUCT ALT. #13
1/4" = 1'-0"

GENERAL SHEET NOTES

KEY NOTES

1 FAN COIL UNIT, SEE MECHANICAL PLANS. INSTALL CONDENSATE DRAIN IN ACCORDANCE WITH MANUFACTURER & PUBLISHED INSTALLATION INSTRUCTIONS.
2 CONDENSATE DRAIN (CD) PIPING SLOPE AT 1/8" PER FOOT. SIZE AS NOTED.
3 1" CD TO TERMINATE 6" ABOVE SERVICE SINK.

100% CONSTRUCTION DOCUMENT SUBMISSION
APRIL 20, 2015

Revisions:	Date
DELTA 1 ADDENDUM #1	7/31/2015

CONSULTANTS:

MAZZETTI
220 Montgomery Street, Suite 650
San Francisco, CA 94104
TEL: 415.632.3266
www.mazzetti.com
PROJECT NUMBER: 130-055

ARCHITECT

POLYTECH ASSOCIATES INC.
235 Pine Street, 17th Floor
San Francisco, CA 94104
TEL (415) 397-3117
FAX (415) 397-1517

Drawing Title: DEDUCTIVE ALTERNATE #13 - PLUMBING WASTE, DRAIN AND VENT PIPING PLAN -SECOND FLOOR
Approved: Project Director
Project Title: NEUROCOG TBI RESEARCH BUILDING / BUILDING R4 DEMOLITION / NEW PARKING LOT
Location: 150 MUIR ROAD, MARTINEZ, CA 94553
Date: 03/13/15 | Checked: Author | Drawn: Checker
Project Number: 612-125
Building Number:
Drawing Number: PL102A

Office of Construction and Facilities Management
Department of Veterans Affairs