



1 Ground Floor Phasing Plan
SCALE: 1/16"=1'-0"

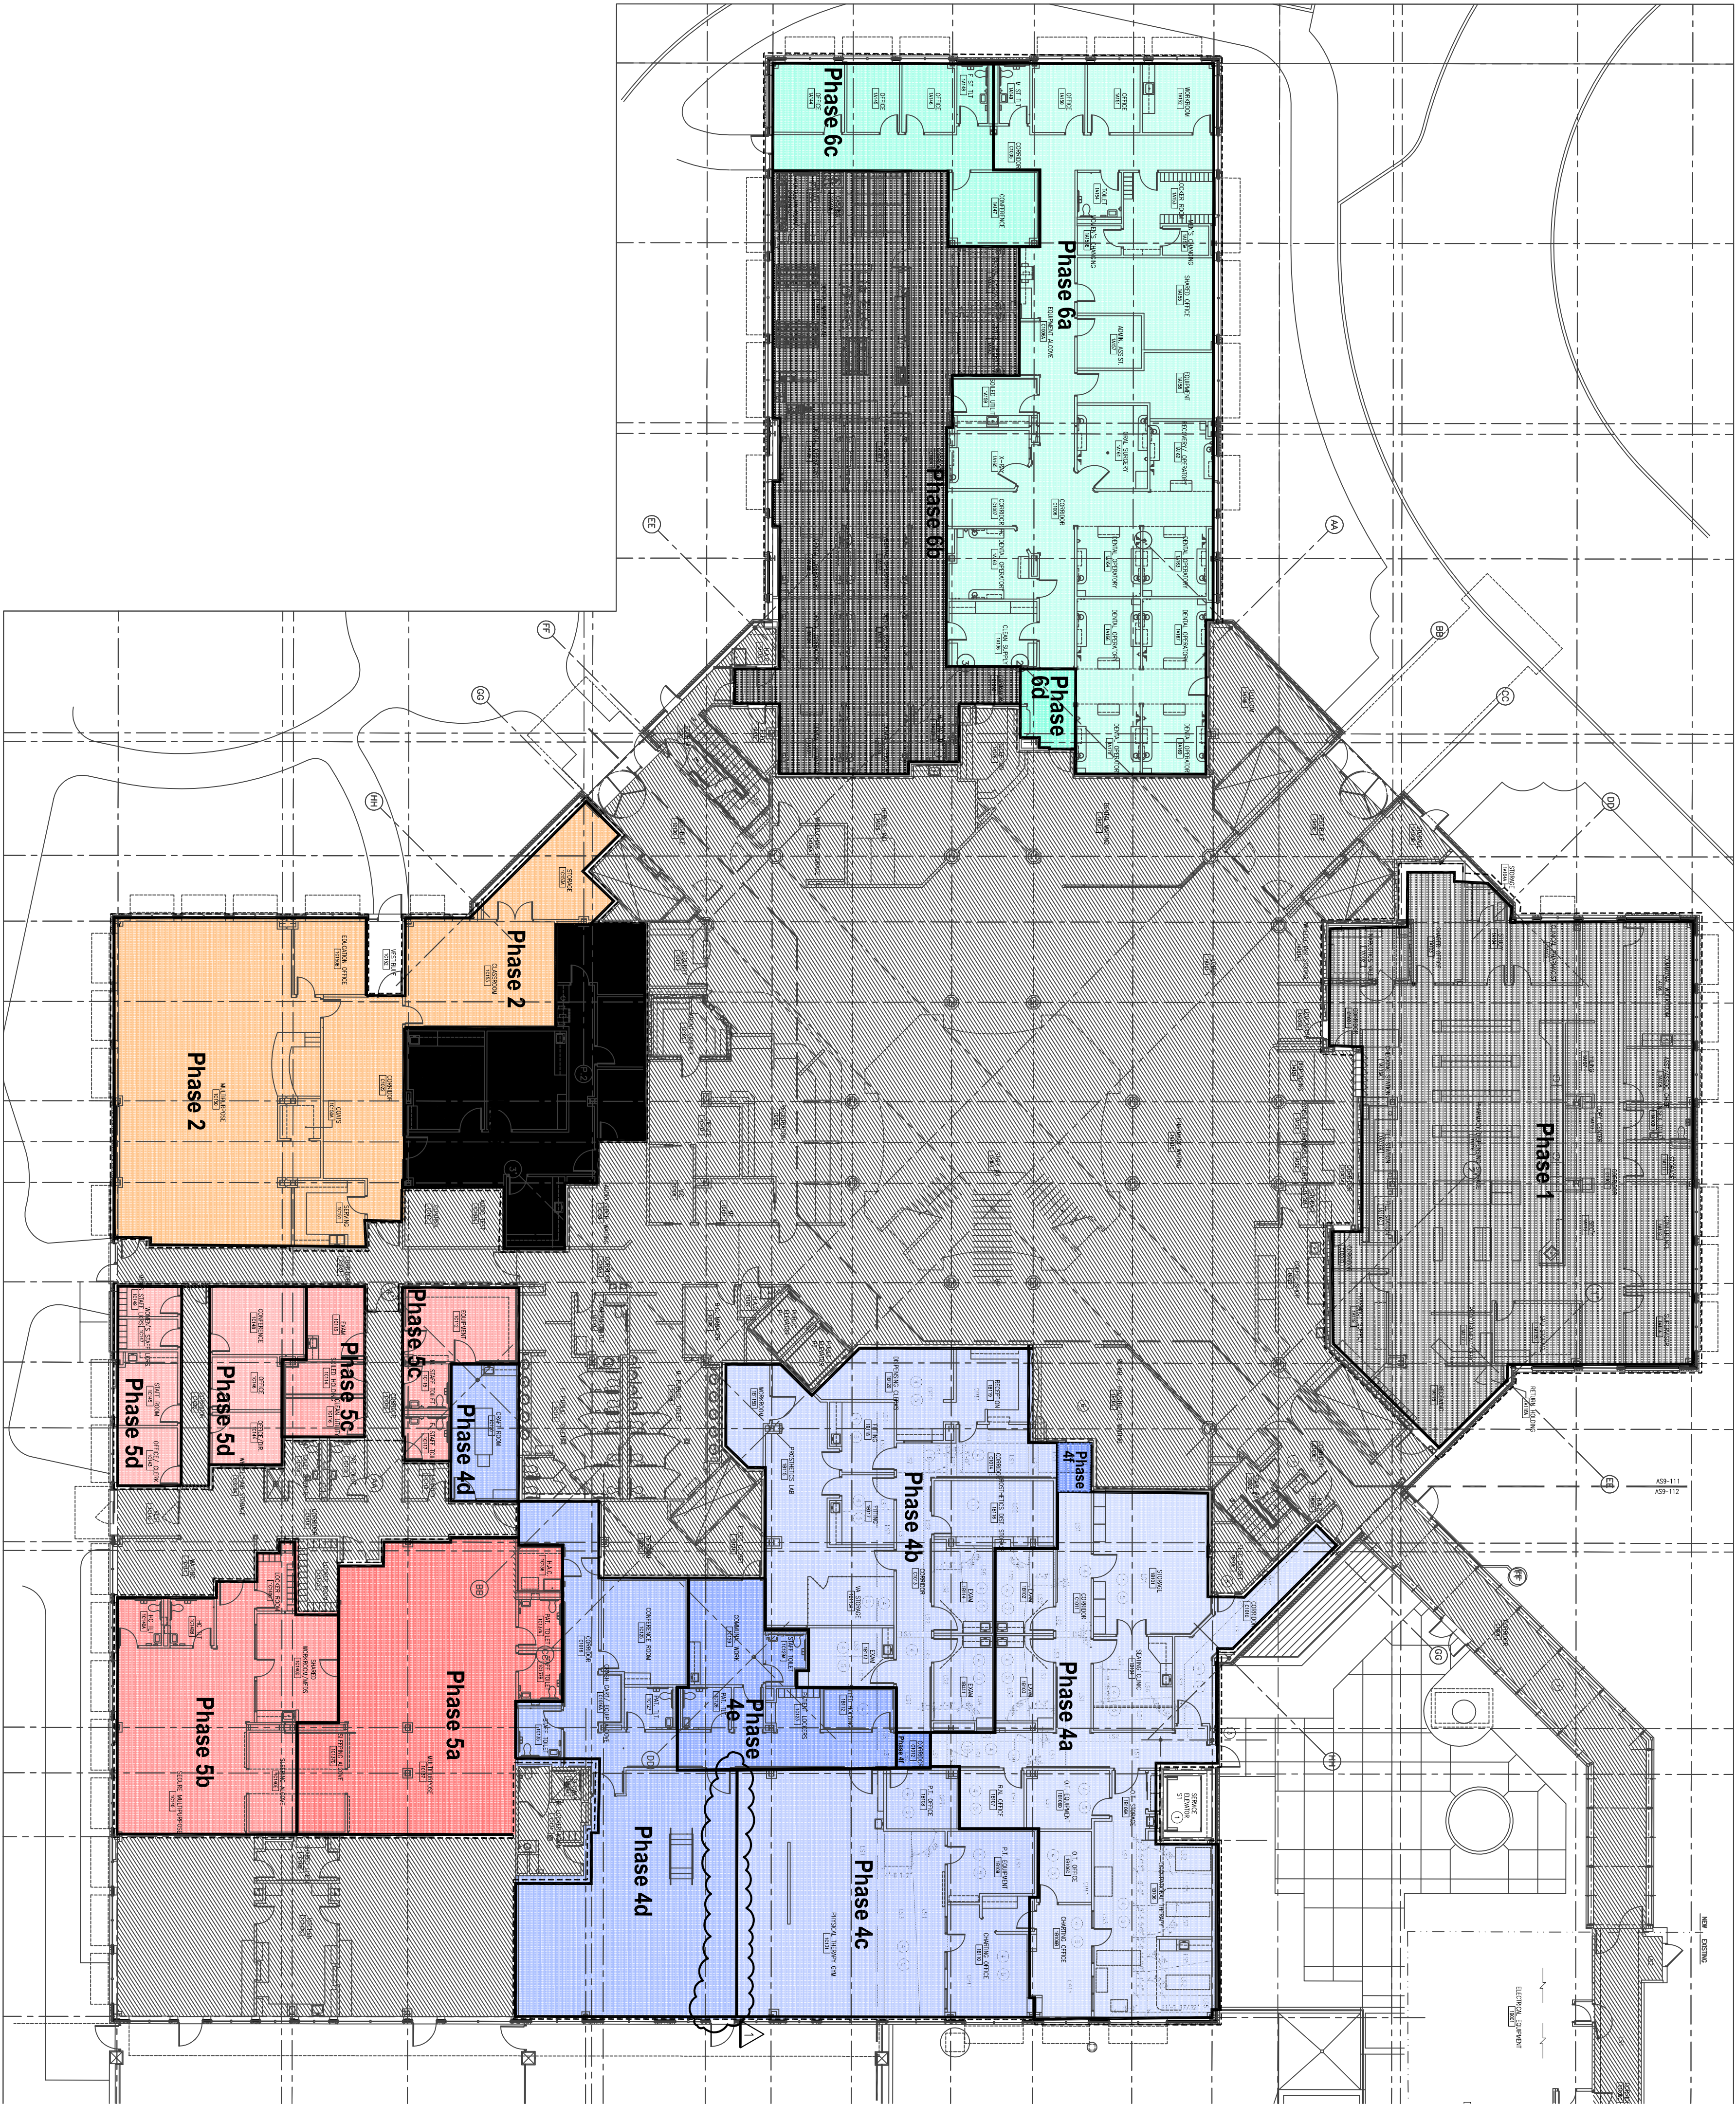

2 1st Floor Phasing Plan -
SCALE: 1/16"=1'-0"

- Phasing**
- PHASE 1 - OUTPATIENT PHARMACY
 - PHASE 2 - EDUCATION
 - PHASE 3 - AUDIOLOGY/SPEECH
 - PHASE 4 - OT/PT & PROSTHETICS
 - PHASE 5 - ADULT DENT CARE
 - PHASE 6 - DENTAL
 - PHASE 7 - GROUND FLOOR
- HATCHING DENOTES AREAS NOT IN CONTRACT

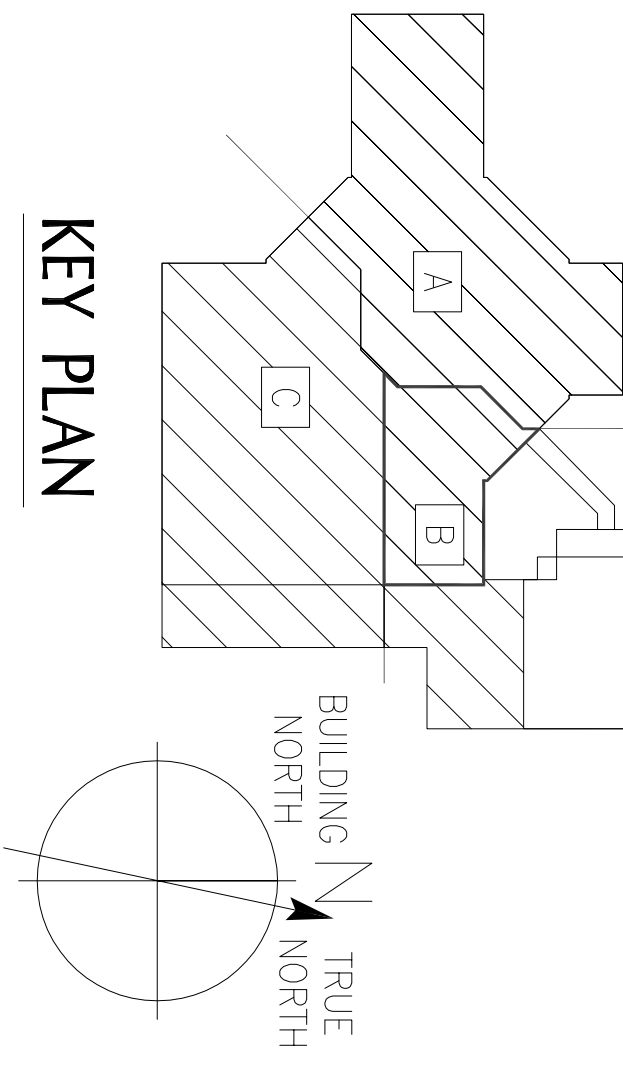

FOR CONSTRUCTION
FULLY SPRINKLERED

Revisions:		Project Title		Project Number	
1	AMENDMENT #1	Ground and 1st Floor Phasing Floor Plans		646500T	
		VAPHS AMBULATORY CARE CENTER FLOORING REPLACEMENT		71	
		VAPHS HJ HEINZ III DIVISION		Drawing Number	
		Date: 07-10-15		Dwg. of x	
		Checked: Drawn:		GSO-001	
		Office of Facilities Management		Department of Veterans Affairs	