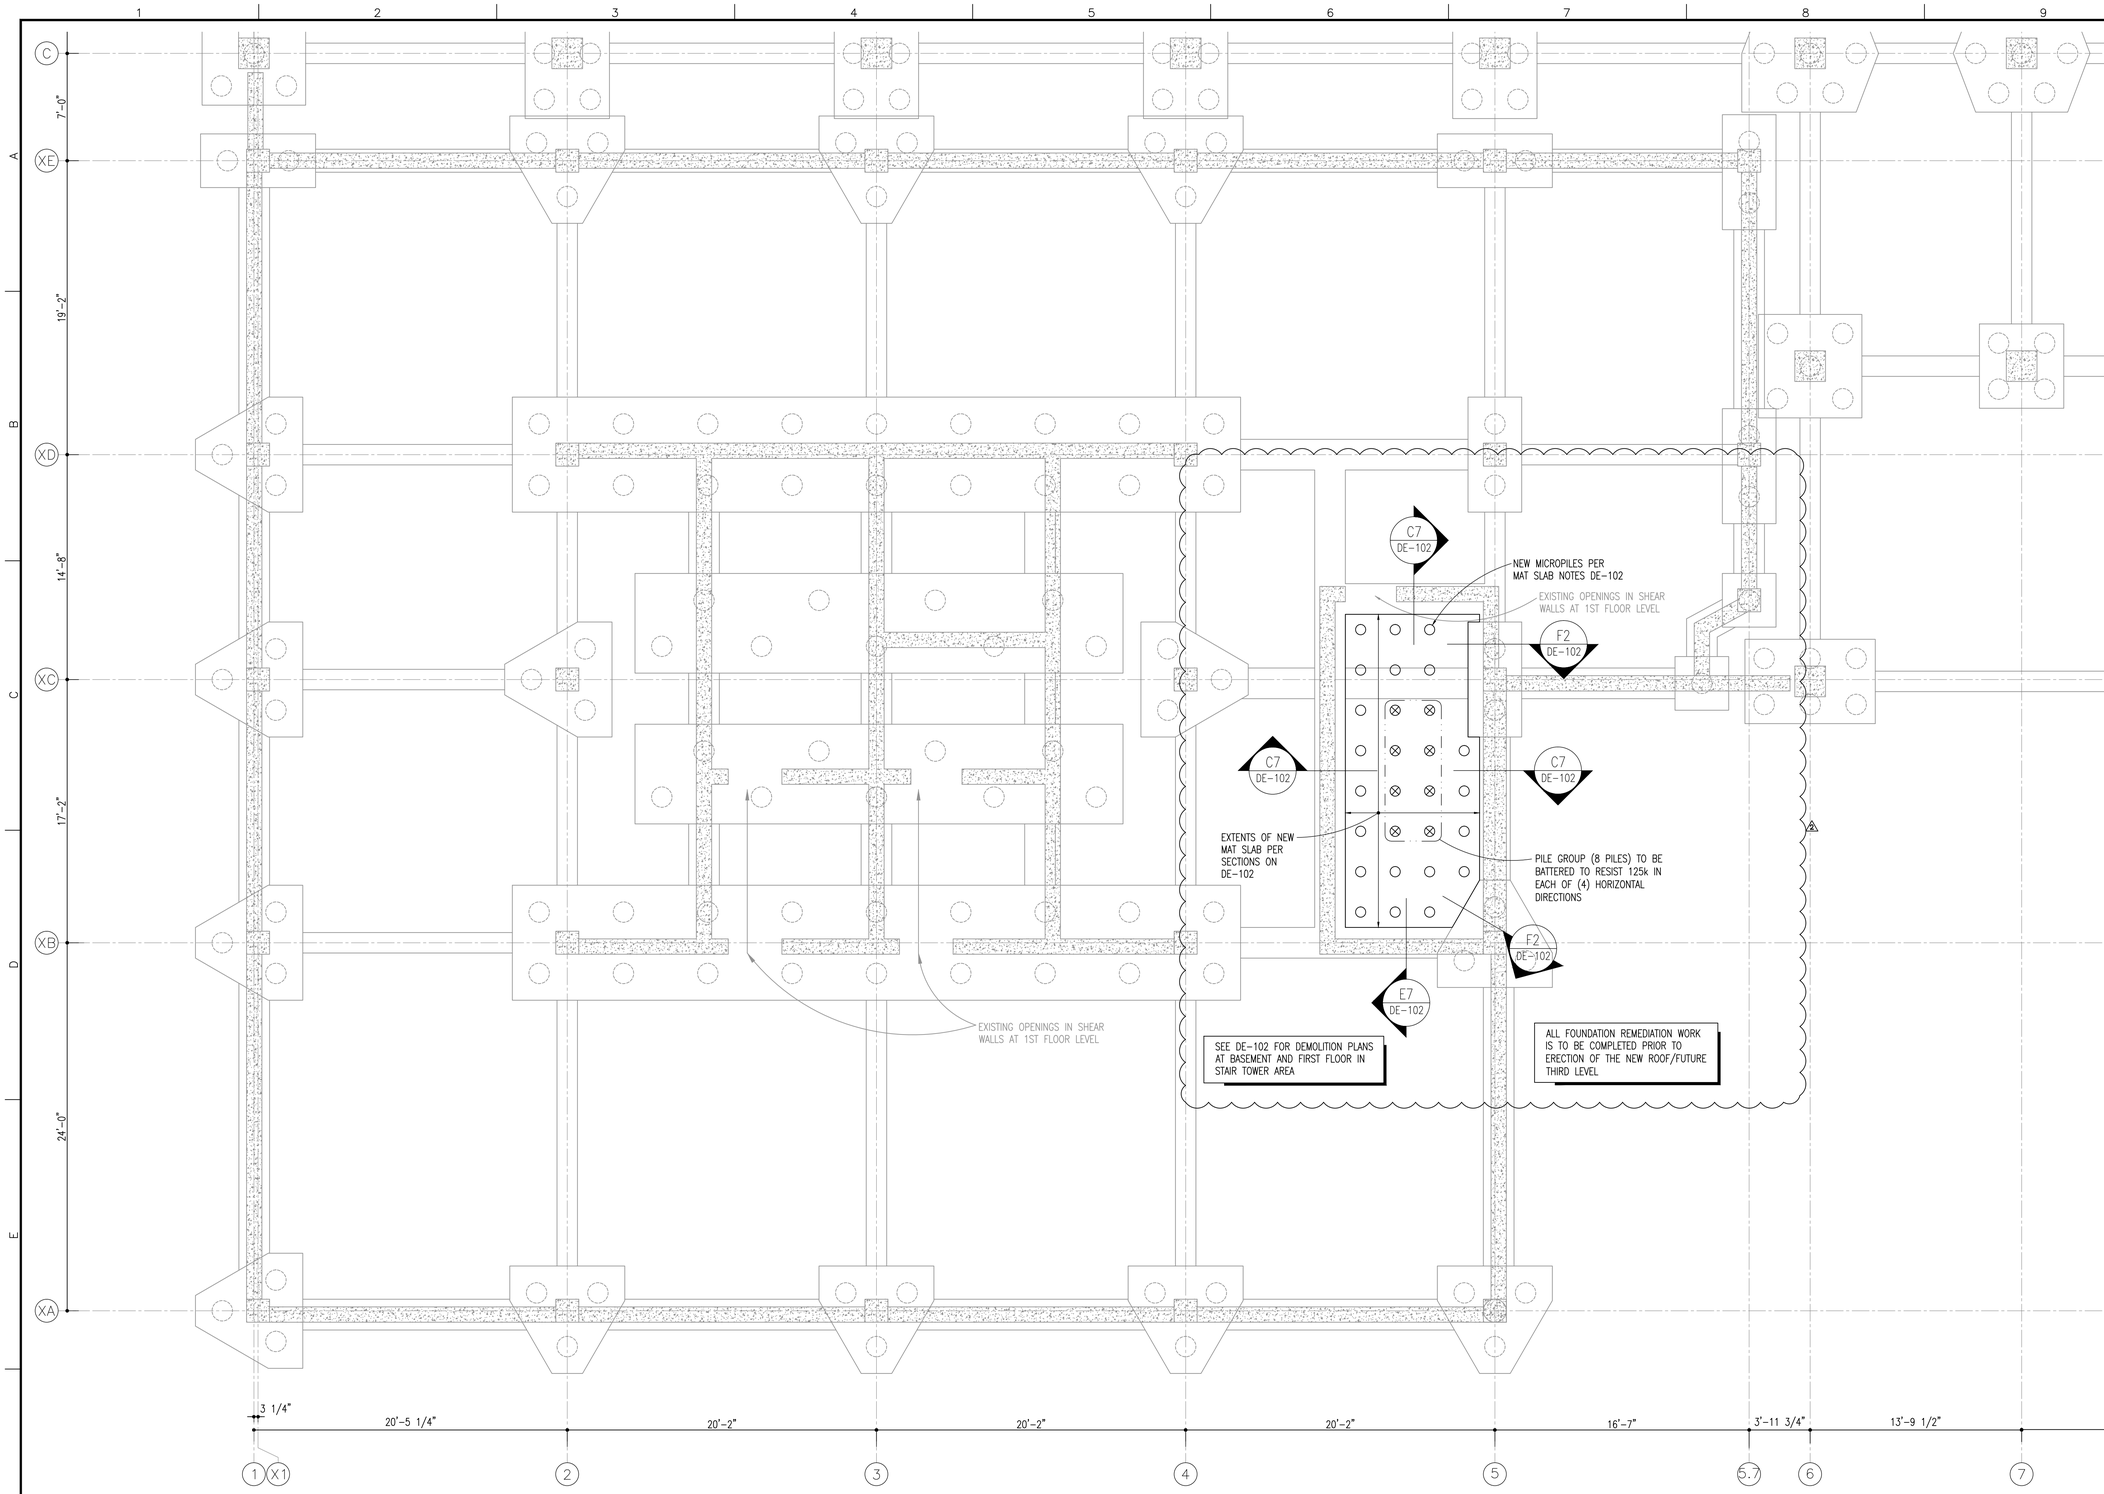

F1 FOUNDATION PLAN – AREA D

SCALE: 1/4" = 1'-0"

0 2' 4' 8'

COORDINATION DRAWINGS

KEYPLAN

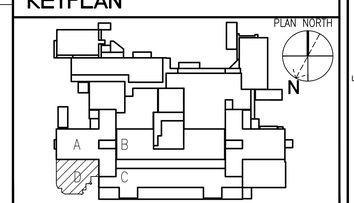

REVISION NO.	REVISION DESCRIPTION	
1	CLARIFICATION #1	7/20/15
2	CLARIFICATION #2	8/07/15
Revisions		By Date

Department of Veterans Affairs
Ralph H Johnson VA Medical Center
109 Bee Street
Charleston, SC 29401

SEAL

Architect/Engineer Address

HARRELL • DESIGN GROUP, PC •

formerly HARRELL, SALTRICK & HOPPER, PC

LAURENE, RICKHER & SORRELL, P.C.
Consulting Structural Engineers
8701 RED OAK BLVD. SUITE 500
CHARLOTTE, NORTH CAROLINA 28217
PHONE 704-522-0495 FAX 704-522-0499
EMAIL mail@lrspc.net WEB www.lrspc.net

8016 TOWER POINT DRIVE
CHARLOTTE, NC 28227
P 704.814.1320
F 704.321.0833

WWW.HARRELLDG.COM

COPYRIGHT © 2014 HARRELL DESIGN GROUP, PC

HDG PROJECT # 13026

Recommended Approvals:	
1. CHIEF, ENGINEERING SERVICE	
2. PROJECT MANAGER	

Drawing Title: FOUNDATION PLAN	Project Title: EXPAND/REPAIR INTENSIVE CARE UNIT, STEP DOWN UNIT, AND PULMONARY			Date: 05/29/2015
				Project Number: 534-325
BUILDING IS FULLY SPRINKLERED	Drawn: RJM	Building Number: 1	AutoCAD File Name	DRAWING No. S-101.D
CONSTRUCTION DOCUMENTS	Checked: MRS	Reviewed	Const. Contract No.	

Veterans Affairs