


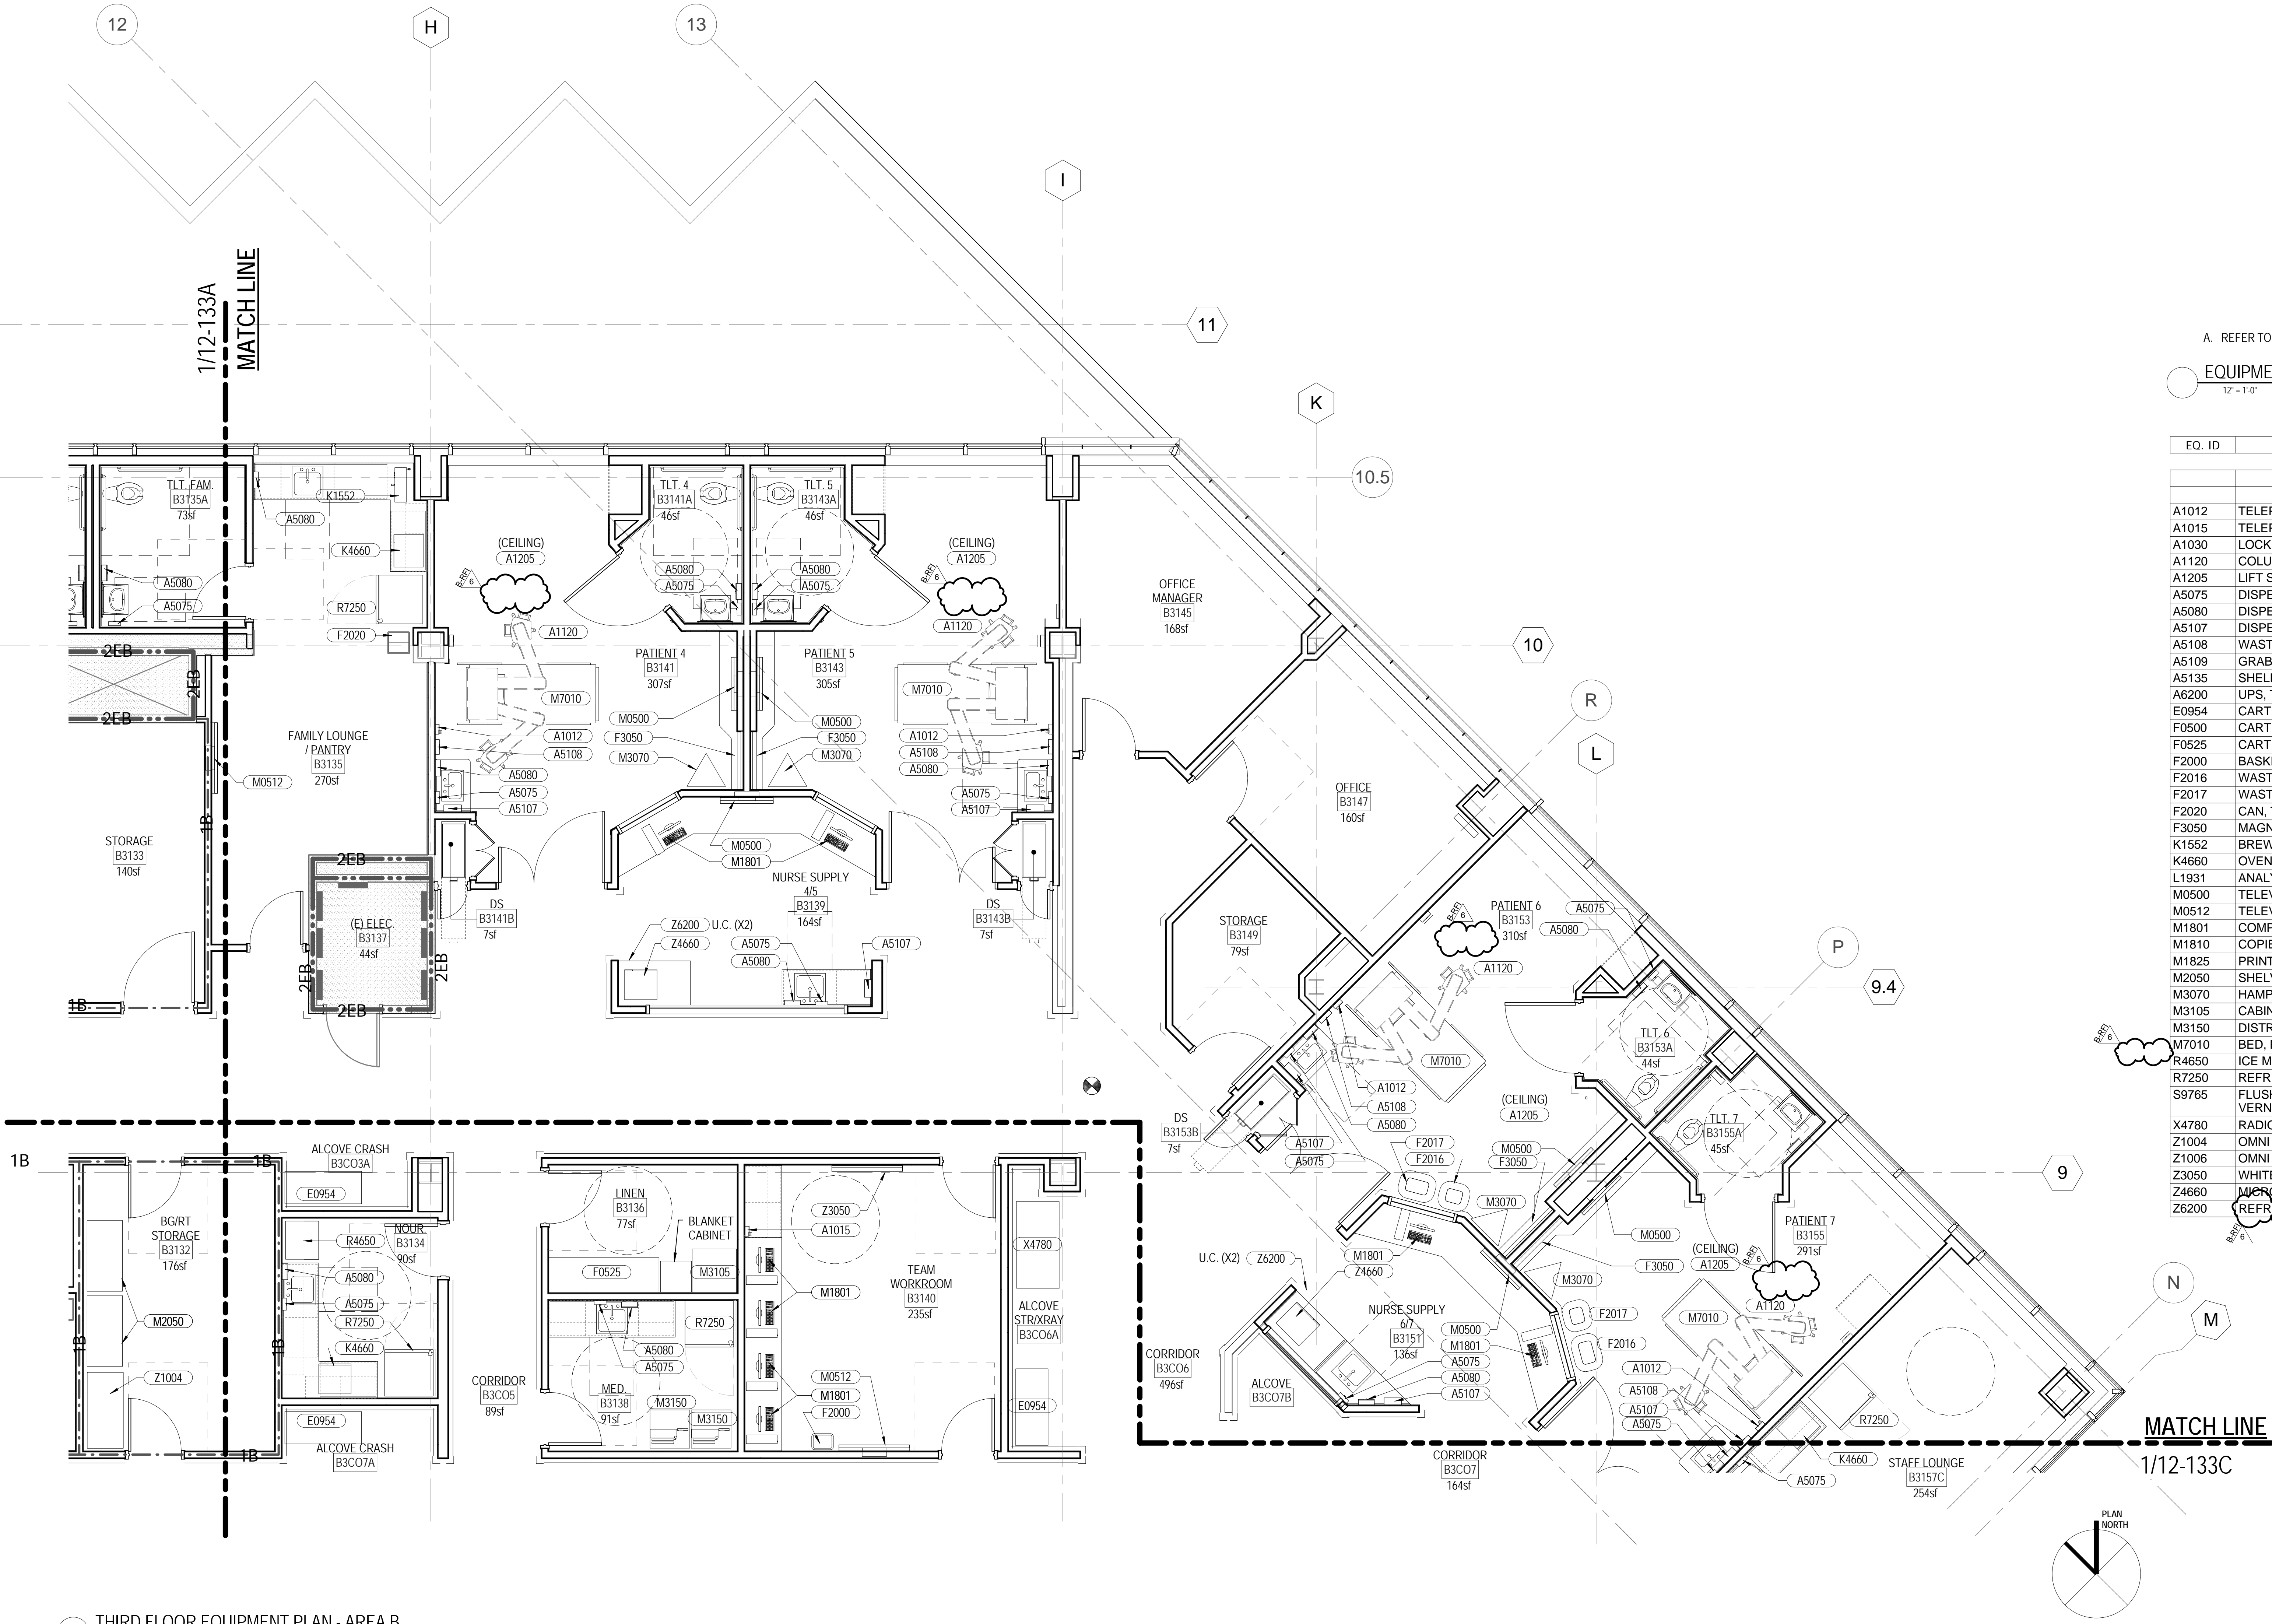


A. REFER TO SHEET 12-605 EQUIPMENT SCHEDULE FOR ADDITIONAL INFORMATION

EQUIPMENT PLAN GENERAL NOTES

12" = 1'-0"

EQ. ID	EQUIPMENT DESCRIPTION	DETAILS
A1012	TELEPHONE, WALL-MOUNTED, 1-LINE	
A1015	TELEPHONE, DESK, MULTIPLE LINE	
A1030	LOCKER, 2 PERSON, OVER/UNDER	
A1120	COLUMN, SERVICE, PREFAB, SURGICAL, CEILING MOUNTED	5/12-522
A1205	LIFT SYSTEM, OVERHEAD, PATIENT ROOM W/BATH	5/12-520
A5075	DISPENSER, SOAP, DISPOSABLE	12-S921
A5080	DISPENSER, PAPER TOWEL, SS, SURFACE MOUNTED	
A5107	DISPENSER, GLOVE, SURGICAL/EXAMINATION, WALL MOUNTED	
A5108	WASTE DISPOSAL UNIT, SHARPS	
A5109	GRAB BAR, 1-1/4" DIA., SS, 2 WALL, W/C ACCESSIBLE	13/12-521
A5135	SHELF, UTILITY W/ MOP/BROOM HOLDERS, SS, SURFACE MOUNTED	
A6200	UPS, THREE PHASE	
E0954	CART, EMERGENCY, MOBILE	
F0500	CART, JANITOR'S	
F0525	CART, SUPPLY	
F2000	BASKET, WASTE/PAPER, ROUND, METAL	
F2016	WASTE RECEPTACLE, 40 GAL	
F2017	WASTE RECEPTACLE, 24 GAL (RED)	
F2020	CAN, TRASH, 44 GALLON	
F3050	MAGNETIC MARKERBOARD, GLASS	
K1552	BREWER, COFFEE, AUTO. ELECT, 3 BURNER, FRONT/BACK	
K4660	OVEN, MICROWAVE, HEAVY DUTY, 1000 WATTS	
L1931	ANALYZER, BLOOD GAS	
M0500	TELEVISION, COLOR, 20" DIAGONAL	
M0512	TELEVISION, HDTV, LARGE SCREEN, 60"	
M1801	COMPUTER, MICROPROCESSING, W/FLAT PANEL MONITOR	
M1810	COPIER, FLOOR STANDING, DIGITAL	
M1825	PRINTER, COMPUTER	
M2050	SHELVING, STORAGE	
M3070	HAMPER, LINEN, MOBILE, W/LID	
M3105	CABINET, 28-COUNT WARMER, SAGE PRODUCT	
M3150	DISTRIBUTION SYSTEM, MEDICATION, AUTOMATIC	
M7010	BED, PATIENT, ELECTRIC	
R4650	ICE MAKER, FLAKED, WITH DISPENSER	
R7250	REFRIGERATOR/FREEZER, 20 CUBIC FEET	
S9765	FLUSHER/DISINFECTOR, DISPOSAL, (MACERATORS-V40-310 VERNACARE)	
X4780	RADIOGRAPHIC UNIT, MOBILE, BATTERY	
Z1004	OMNI CELL STORAGE, 2-CELL CABINET, 4'-0"	
Z1006	OMNI CELL STORAGE, 3-CELL CABINET, 6'-0"	
Z3050	WHITEBOARD DRY ERASE - 3' x 4'	
Z4660	MICROWAVE, COMBI FOR PERSONAL CLEANING, SAGE PRODUCTS	
Z6200	REFRIGERATOR, DRAWER SYSTEM, RANDELL	

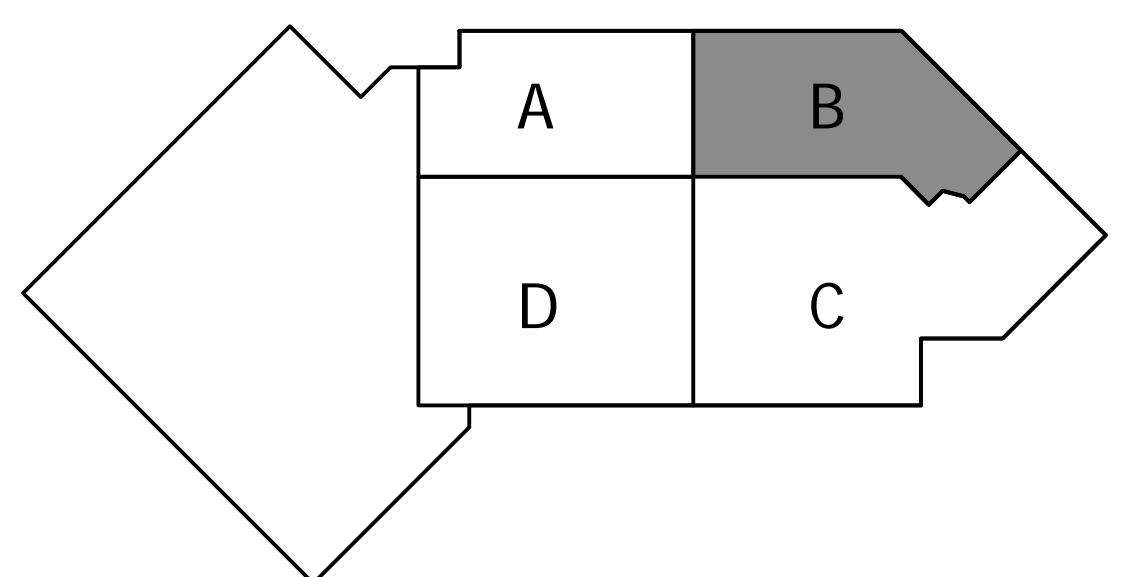


KEYMAP

Scale: As indicated

1 THIRD FLOOR EQUIPMENT PLAN - AREA B
1/4" = 1'-0"

CONSULTANTS:

ARCHITECT/ENGINEERS:

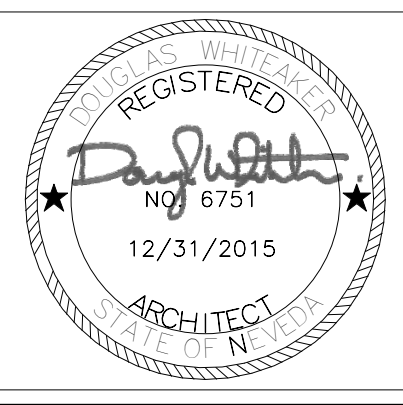

Architecture | Engineering | Planning
Hammel, Green and Abrahamson, Inc.
1410 Rocky Ridge Drive, Suite 250
Roseville, California USA 95661
Telephone 916.787.5100 Facsimile 916.784.7738
Contact: Douglas Whiteaker

Drawing Title
THIRD FLOOR EQUIPMENT PLAN - AREA B

Project Title
WARD 2C REMODEL: INTENSIVE CARE UNIT

Project Number
654-412

Building Number
12

Drawing Number
12-133B

Dwg. of

Office of
Construction
and Facilities
Management



BIDDING RFI #6
Revisions:
8/6/2015
Date:

Date
01/30/2015

Checked
Checker

Drawn
Author

12-133B