


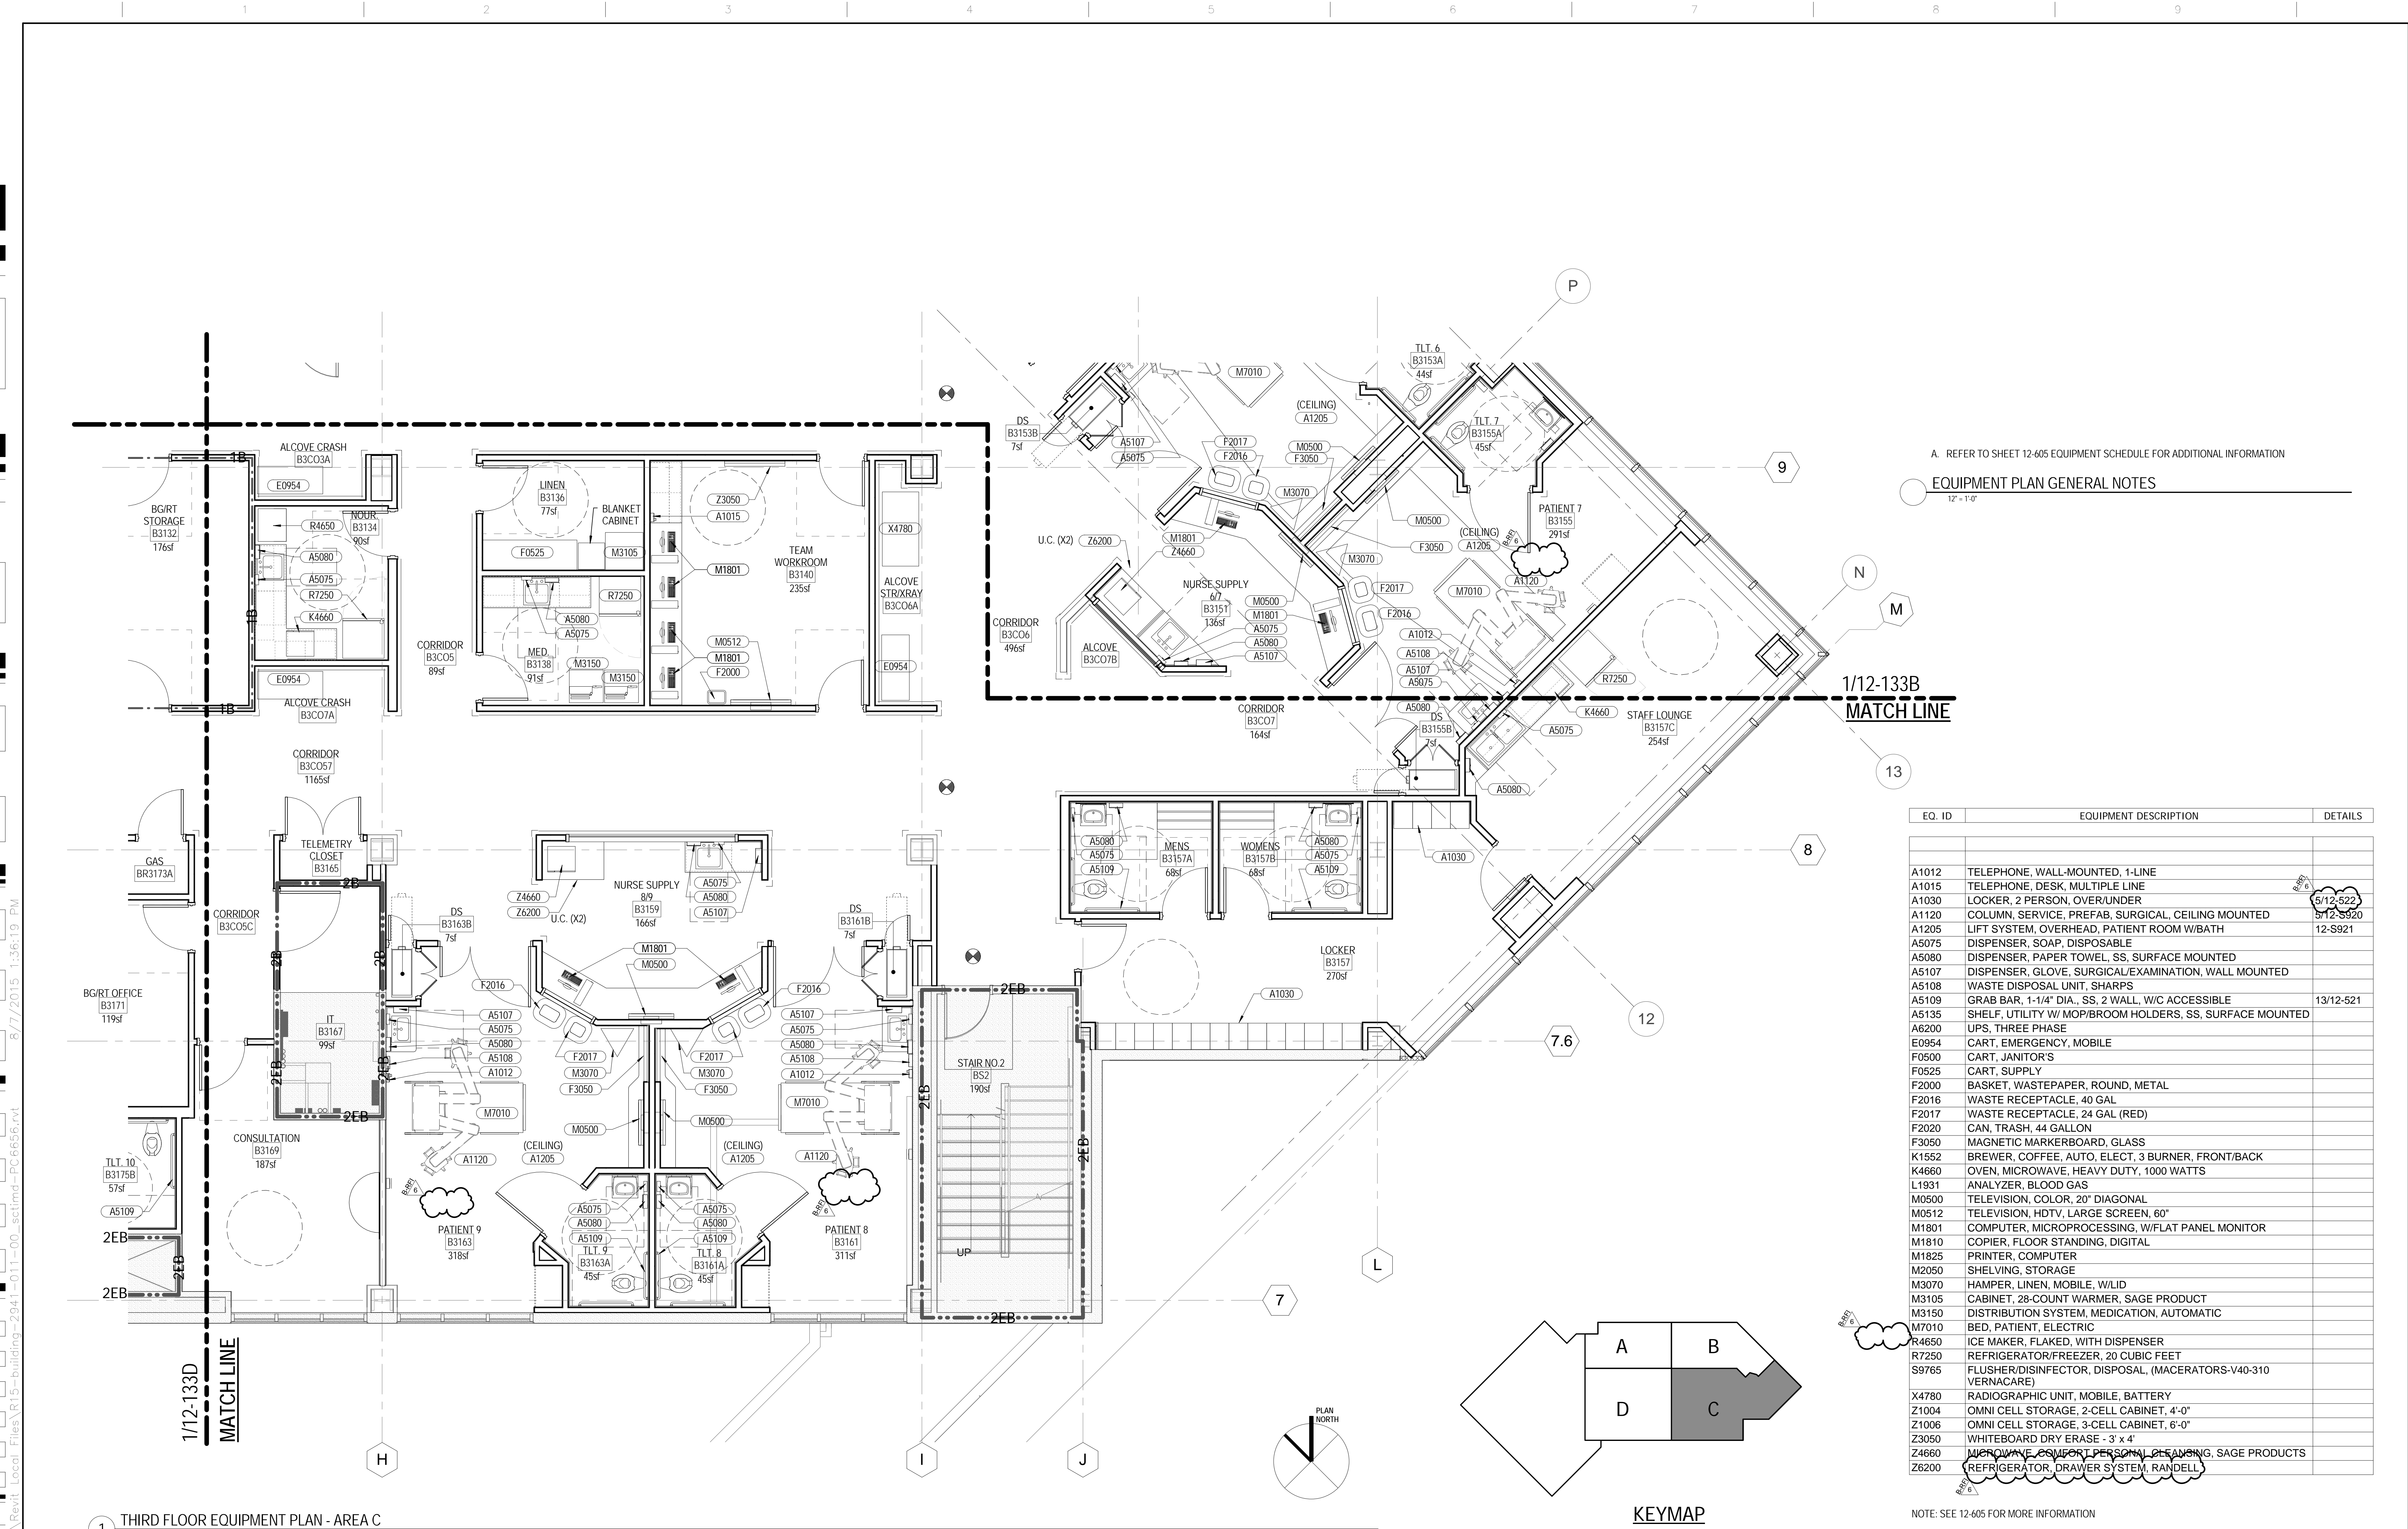

A. REFER TO SHEET 12-605 EQUIPMENT SCHEDULE FOR ADDITIONAL INFORMATION

EQUIPMENT PLAN GENERAL NOTES


12" = 1'-0"

1/12-133B  
MATCH LINE

EQ. ID	EQUIPMENT DESCRIPTION	DETAILS
A1012	TELEPHONE, WALL-MOUNTED, 1-LINE	
A1015	TELEPHONE, DESK, MULTIPLE LINE	
A1030	LOCKER, 2 PERSON, OVER/UNDER	5/12-522
A1120	COLUMN, SERVICE, PREFAB, SURGICAL, CEILING MOUNTED	5/12-S920
A1205	LIFT SYSTEM, OVERHEAD, PATIENT ROOM W/BATH	12-S921
A5075	DISPENSER, SOAP, DISPOSABLE	
A5080	DISPENSER, PAPER TOWEL, SS, SURFACE MOUNTED	
A5107	DISPENSER, GLOVE, SURGICAL/EXAMINATION, WALL MOUNTED	
A5108	WASTE DISPOSAL UNIT, SHARPS	
A5109	GRAB BAR, 1-1/4" DIA., SS, 2 WALL, W/C ACCESSIBLE	13/12-521
A5135	SHELF, UTILITY W/ MOP/BROOM HOLDERS, SS, SURFACE MOUNTED	
A6200	UPS, THREE PHASE	
E0954	CART, EMERGENCY, MOBILE	
F0500	CART, JANITOR'S	
F0525	CART, SUPPLY	
F2000	BASKET, WASTEPAPER, ROUND, METAL	
F2016	WASTE RECEPTACLE, 40 GAL	
F2017	WASTE RECEPTACLE, 24 GAL (RED)	
F2020	CAN, TRASH, 44 GALLON	
F3050	MAGNETIC MARKERBOARD, GLASS	
K1552	BREWER, COFFEE, AUTO, ELECT, 3 BURNER, FRONT/BACK	
K4660	OVEN, MICROWAVE, HEAVY DUTY, 1000 WATTS	
L1931	ANALYZER, BLOOD GAS	
M0500	TELEVISION, COLOR, 20" DIAGONAL	
M0512	TELEVISION, HDTV, LARGE SCREEN, 60"	
M1801	COMPUTER, MICROPROCESSING, W/FLAT PANEL MONITOR	
M1810	COPIER, FLOOR STANDING, DIGITAL	
M1825	PRINTER, COMPUTER	
M2050	SHELVING, STORAGE	
M3070	HAMPER, LINEN, MOBILE, W/LID	
M3105	CABINET, 28-COUNT WARMER, SAGE PRODUCT	
M3150	DISTRIBUTION SYSTEM, MEDICATION, AUTOMATIC	
M7010	BED, PATIENT, ELECTRIC	
R4650	ICE MAKER, FLAKED, WITH DISPENSER	
R7250	REFRIGERATOR/FREEZER, 20 CUBIC FEET	
S9765	FLUSHER/DISINFECTOR, DISPOSAL, (MACERATORS-V40-310 VERNACARE)	
X4780	RADIOGRAPHIC UNIT, MOBILE, BATTERY	
Z1004	OMNI CELL STORAGE, 2-CELL CABINET, 4'-0"	
Z1006	OMNI CELL STORAGE, 3-CELL CABINET, 6'-0"	
Z3050	WHITEBOARD DRY ERASE - 3' x 4'	
Z6200	REFRIGERATOR, DRAWER SYSTEM, RANDALL	

NOTE: SEE 12-605 FOR MORE INFORMATION


KEYMAP

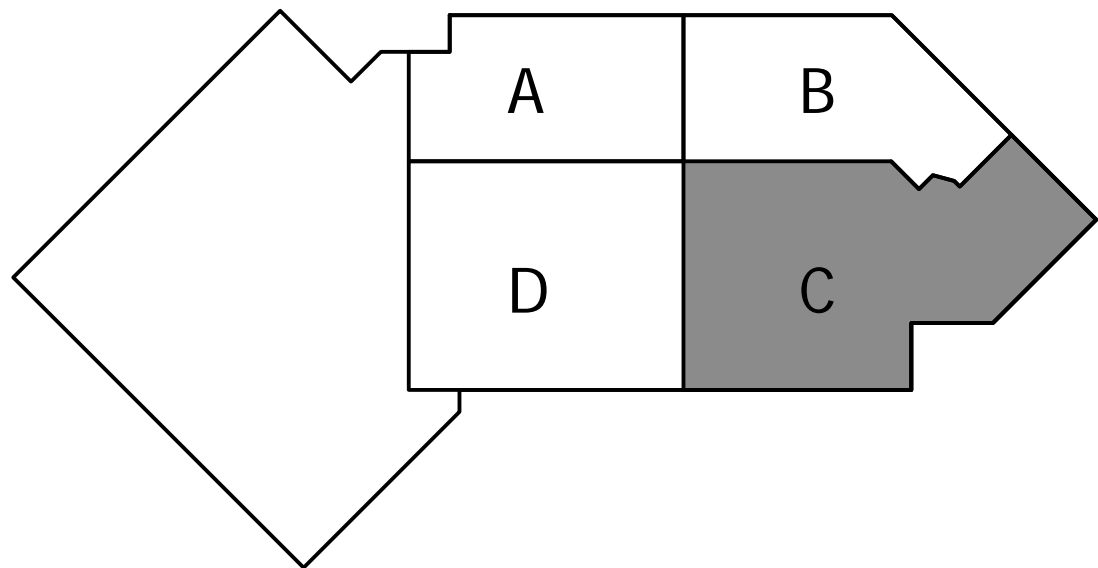

1 THIRD FLOOR EQUIPMENT PLAN - AREA C  
1/4" = 1'-0"

CONSULTANTS:

ARCHITECT/ENGINEERS:

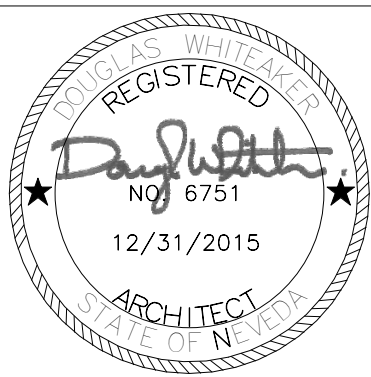

Architecture | Engineering | Planning  
Hammel, Green and Abrahamson, Inc.  
1410 Rocky Ridge Drive, Suite 250  
Roseville, California USA 95661  
Telephone 916.787.5100 Facsimile 916.784.7738  
Contact: Douglas Whiteaker

Drawing Title  
THIRD FLOOR EQUIPMENT PLAN - AREA C

Approved: Project Director

Project Title  
WARD 2C REMODEL: INTENSIVE CARE UNIT

Location  
975 KIRMAN AVE.  
RENO, NV 89520

Date  
01/30/2015

Checked  
Checker

Drawn  
Author

Project Number  
654-412

Building Number  
12

Drawing Number  
12-133C

Dwg. of

Office of  
Construction  
and Facilities  
Management

Department of  
Veterans Affairs

Scale: As indicated