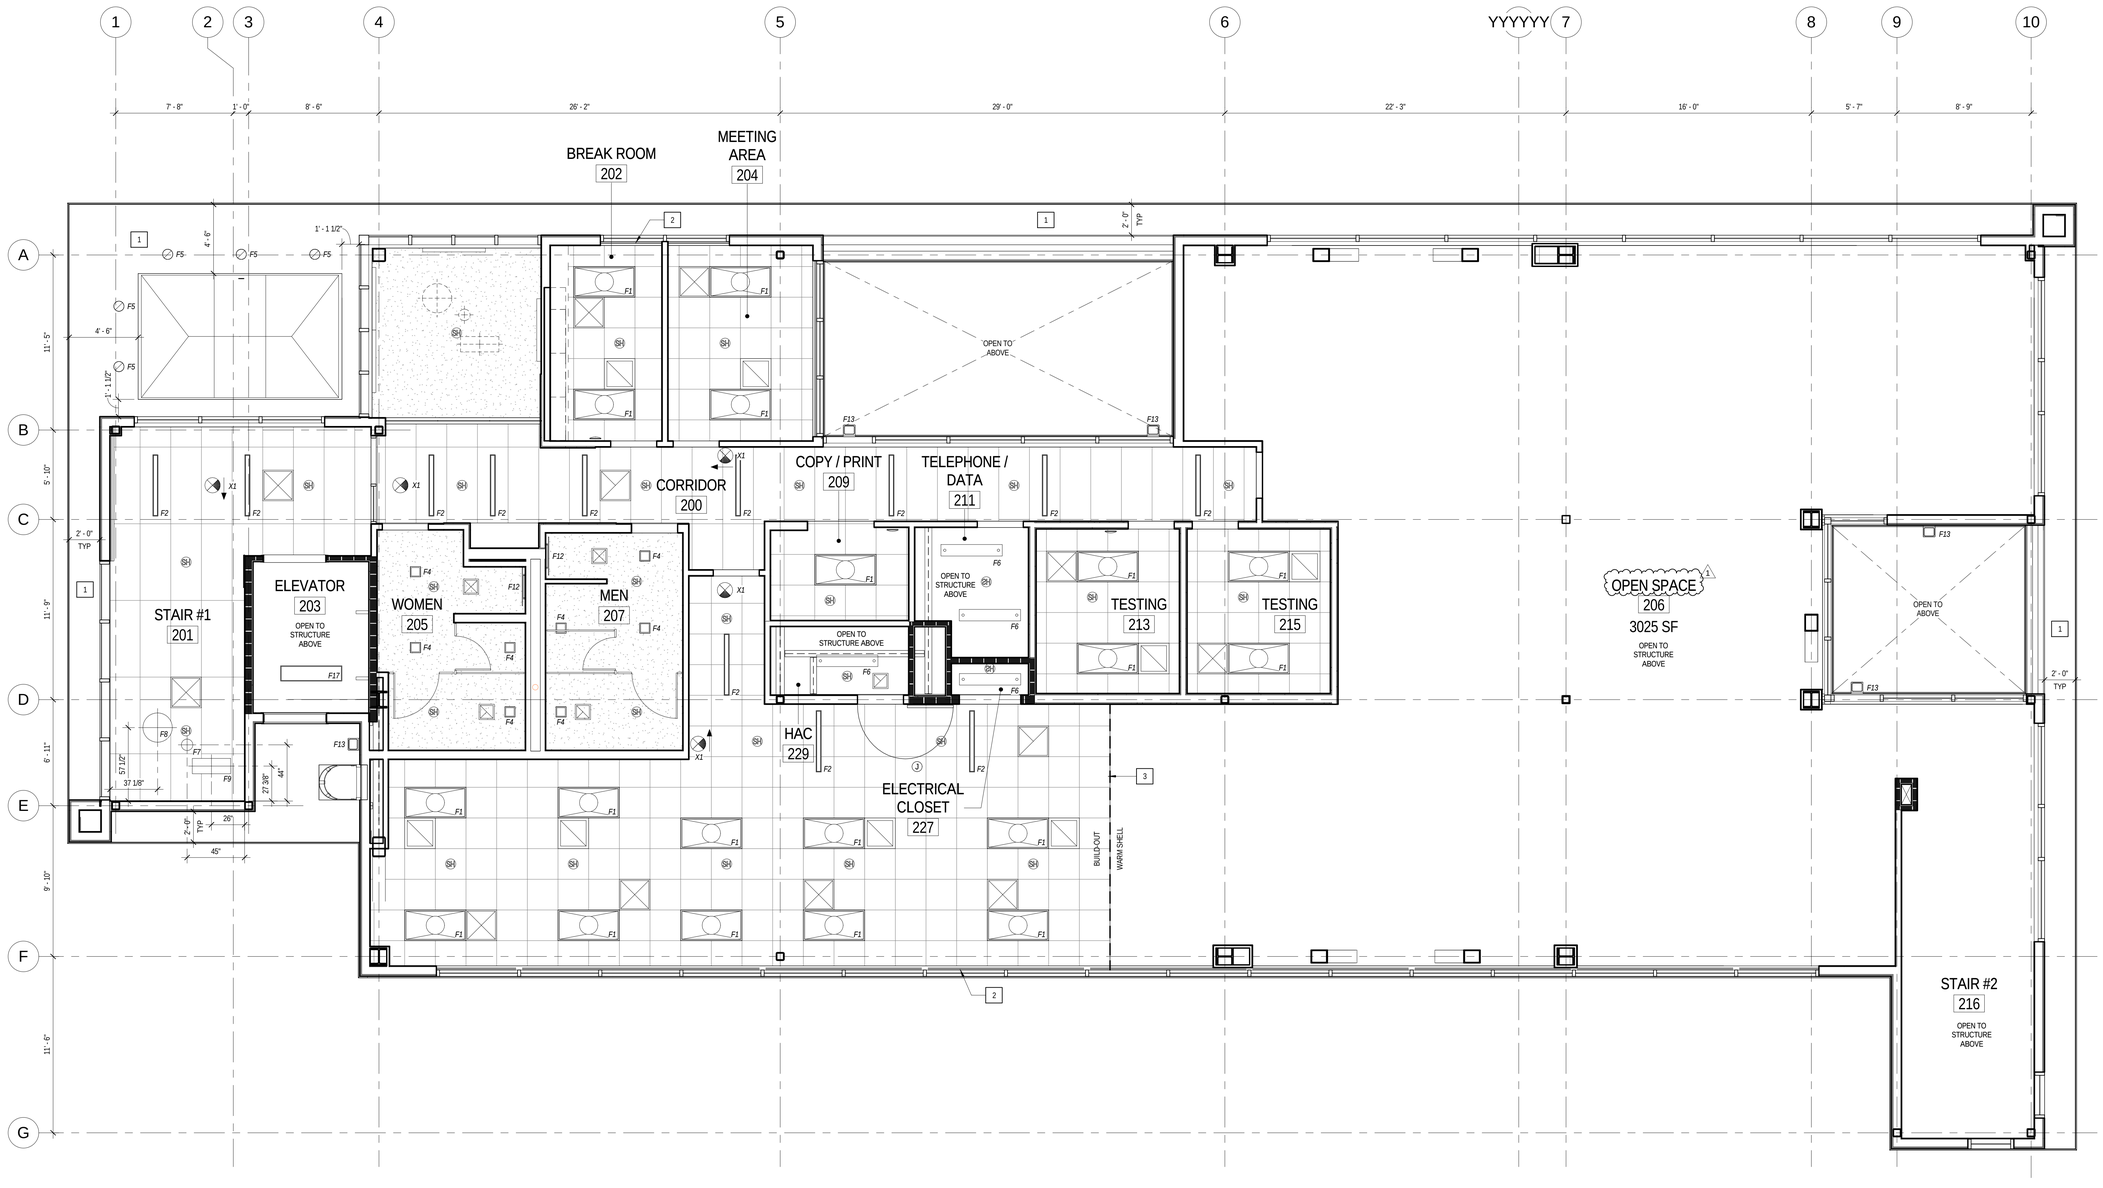

SHEET NOTES

1. SEE ELECTRICAL DRAWINGS FOR SWITCHING, CIRCUITING AND OTHER POWER INFORMATION
2. CENTER CEILING GRID IN ROOM OR CORRIDOR AS SHOWN, UON
3. ALL CEILING MOUNTED DEVICES SUCH AS SPEAKERS, SMOKE DETECTORS, OCCUPANCY SENSORS, SPRINKLER HEADS, DOWNLIGHTS, ETC. TO BE CENTERED IN CEILING TILES, U.O.N.
4. FOR ACCESS PANEL IN GYP. BOARD CEILING SEE 7/AS515.
5. SEE ELECTRICAL DRAWINGS FOR EMERGENCY LIGHTING LOCATIONS

KEY NOTES

1. CEMENT PLASTER SOFFIT
2. HORIZONTAL WINDOW BLINDS, TYP (SEE DEDUCTIVE ALTERNATE GI002)
3. EXTENT OF EXTERIOR BUILD OUT

LEGEND

AT1	2' x 5' SUSPENDED ACOUSTICAL CEILING 9'-0" A.F.F., U.O.N.
AT2	2' x 2' SUSPENDED ACOUSTICAL CEILING 9'-0" A.F.F., U.O.N.
GWB1	SUSPENDED GYP BD CEILING 9'-0" A.F.F., U.O.N.
F1	2' x 4' RECESSED LED LIGHT FIXTURE
F2	SURFACE MOUNTED LED LIGHT FIXTURE 4" x 48'
F3	4" x 96
F4	8" x 8" RECESSED LED DOWNLIGHT
F5	8" DIA RECESSED EXTERIOR DOWNLIGHT
F6	9" x 4' SUSPENDED LED LIGHT FIXTURE
F7	9" DIA LED PENDANT LIGHT FIXTURE
F8	23" DIA LED PENDANT LIGHT FIXTURE
F9	12" x 30" LED PENDANT LIGHT FIXTURE
F10	WALL MOUNTED STEP LIGHT
F11	ELECTRIC BACK-LIT MIRROR 30" W x 42" H
F12	54" W x 42" H
F13	EXTERIOR WALL MOUNTED SCONCE
F16	EXTERIOR WALL MOUNTED SCONCE
F17	1' x 4' SURFACE MOUNTED LED LIGHT FIXTURE
X1	CEILING MOUNTED EXIT SIGN - SINGLE FACE (DIRECTIONAL ARROWS AS INDICATED ON PLAN)
X2	CEILING MOUNTED EXIT SIGN - DOUBLE FACE (DIRECTIONAL ARROWS AS INDICATED ON PLAN)
	SUPPLY DIFFUSER, SMD
	RETURN REGISTER, SMD
	EXHAUST REGISTER, SMD
SH	SPRINKLER HEAD, LOCATE IN CENTER OF CEILING TILE UON
J	JUNCTION BOX LOCATED ABOVE CEILING, COORDINATE WITH OFFICE WALL SYSTEM

100% CONSTRUCTION DOCUMENT SUBMISSION
APRIL 20, 2015

DELTA 1 ADDENDUM#2	8/7/2015
Revisions:	Date

CONSULTANTS:

LICENSED ARCHITECT
Mehmoush Arsanjani
RENEWAL
JULY 31,2015
STATE OF CALIFORNIA

ARCHITECT

POLYTECH ASSOCIATES INC.
235 Pine Street, 17th Floor
San Francisco, CA 94104
TEL (415) 397-3117
FAX (415) 397-1517

Drawing Title
DEDUCTIVE ALTERNATE #13A SECOND FLOOR REFLECTED CEILING PLAN - NEW TBI BUILDING

Approved: Project Director

Project Title
NEUROCOG TBI RESEARCH BUILDING / BUILDING R4 DEMOLITION / NEW PARKING LOT

Location
150 MUIR ROAD, MARTINEZ, CA 94553

Date	Checked	Drawn
04/20/2015	DW	CS

Project Number
612-125

Building Number

Drawing Number
AS105B

Office of Construction and Facilities Management

Department of Veterans Affairs