


1. CONTRACTOR SHALL VERIFY ALL DIMENSIONS AND BECOME FAMILIAR WITH THE WORK. IF DISCREPANCIES ARE FOUND, THE CONTRACTOR SHALL NOTIFY THE COR IMMEDIATELY BEFORE STARTING THE WORK.
2. CONTRACTOR SHALL NOTE THE WORK WHERE CLEAR DIMENSIONS ARE REQUIRED. THESE DIMENSIONS ARE CRITICAL FOR CLEARANCE.

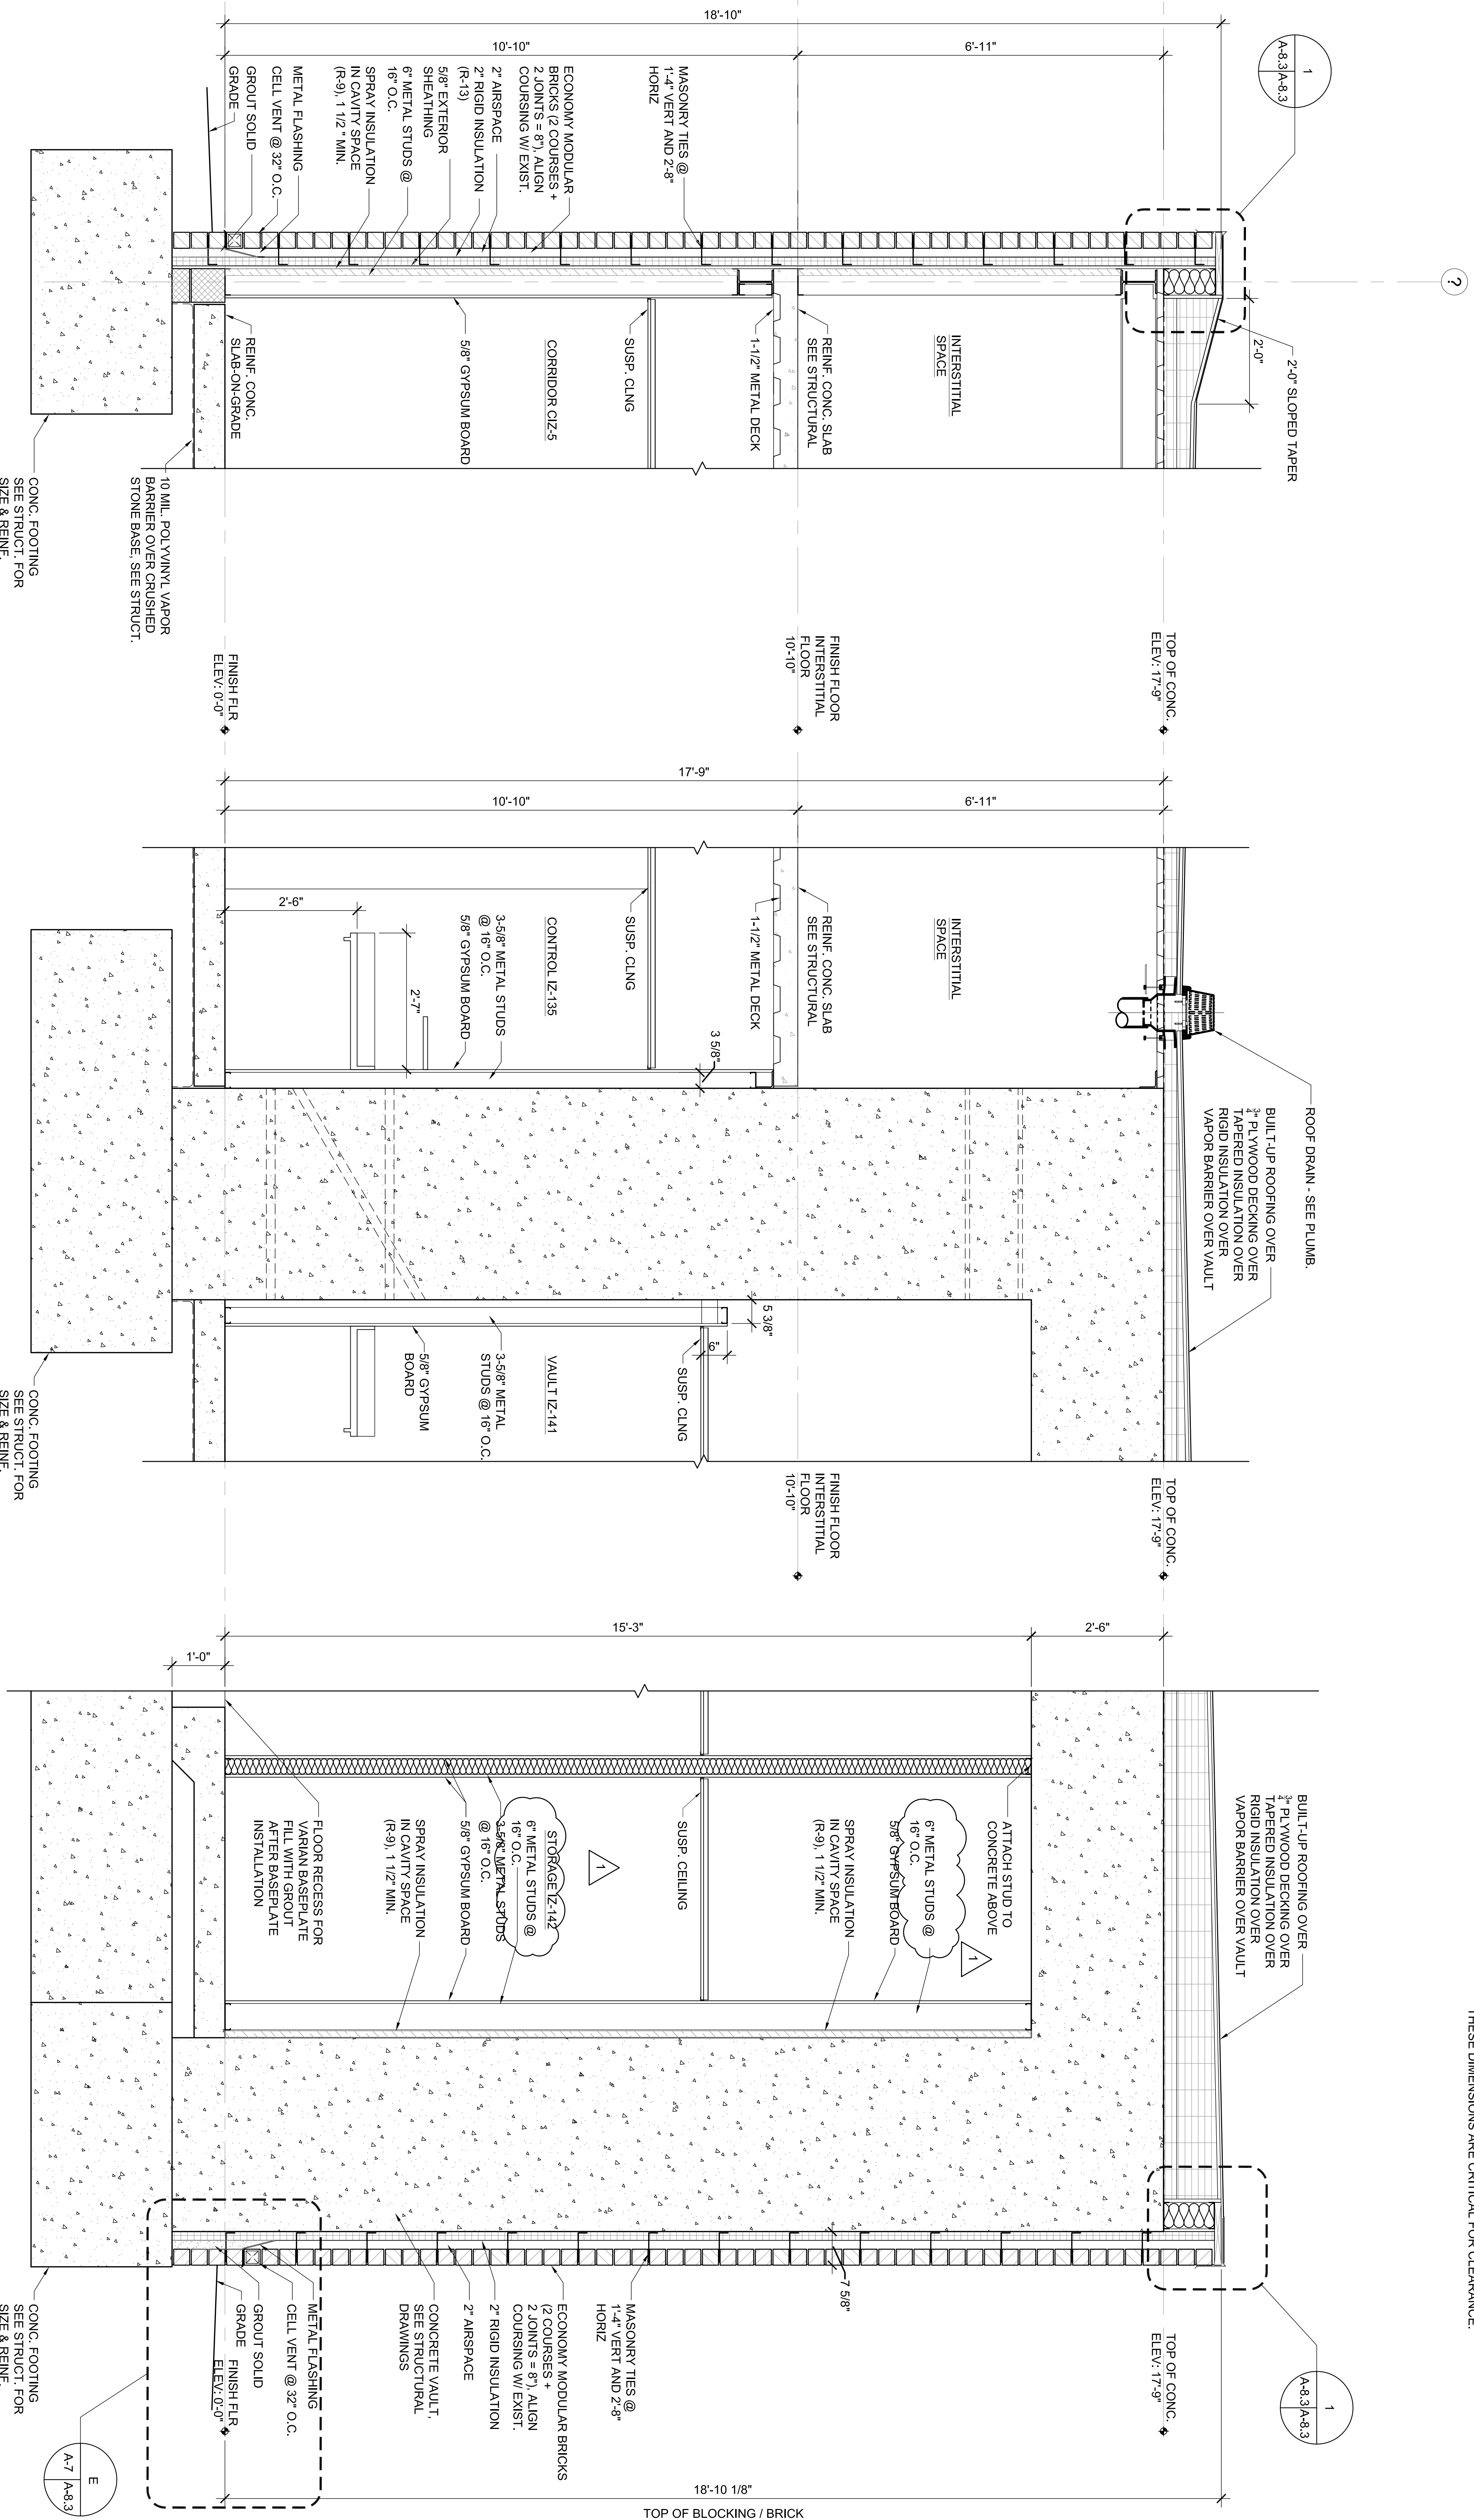

3
A-8.3
WALL SECTION
3/4"=1'-0"

2
A-8.3

WALL SECTION
3/4"=1'-0"

1
A-8.3

WALL SECTION
3/4"=1'-0"

[illegible]