



S:\Facility_Planning_Project_Development_Section\PROJECTS - NRM\2015\640-15-150 T6B Floor and Deck Replacement\Work\Drawings\DWG\CS101-SitePlan.dwg 8-11-15 02:29:13 PM vhapalngory

VA FORM 08-6231

NEW FLATWORK PLAN

SCALE: 3/16" = 1'-0"

CONSULTANTS:

ARCHITECT/ENGINEERS:

Drawing Title
CIVIL ENGINEERING PLAN

Project Title	Project Number
Building T&D	640-15-150

Office of


Appendix No 1

8/10/15

8/10/15

Prev

Date

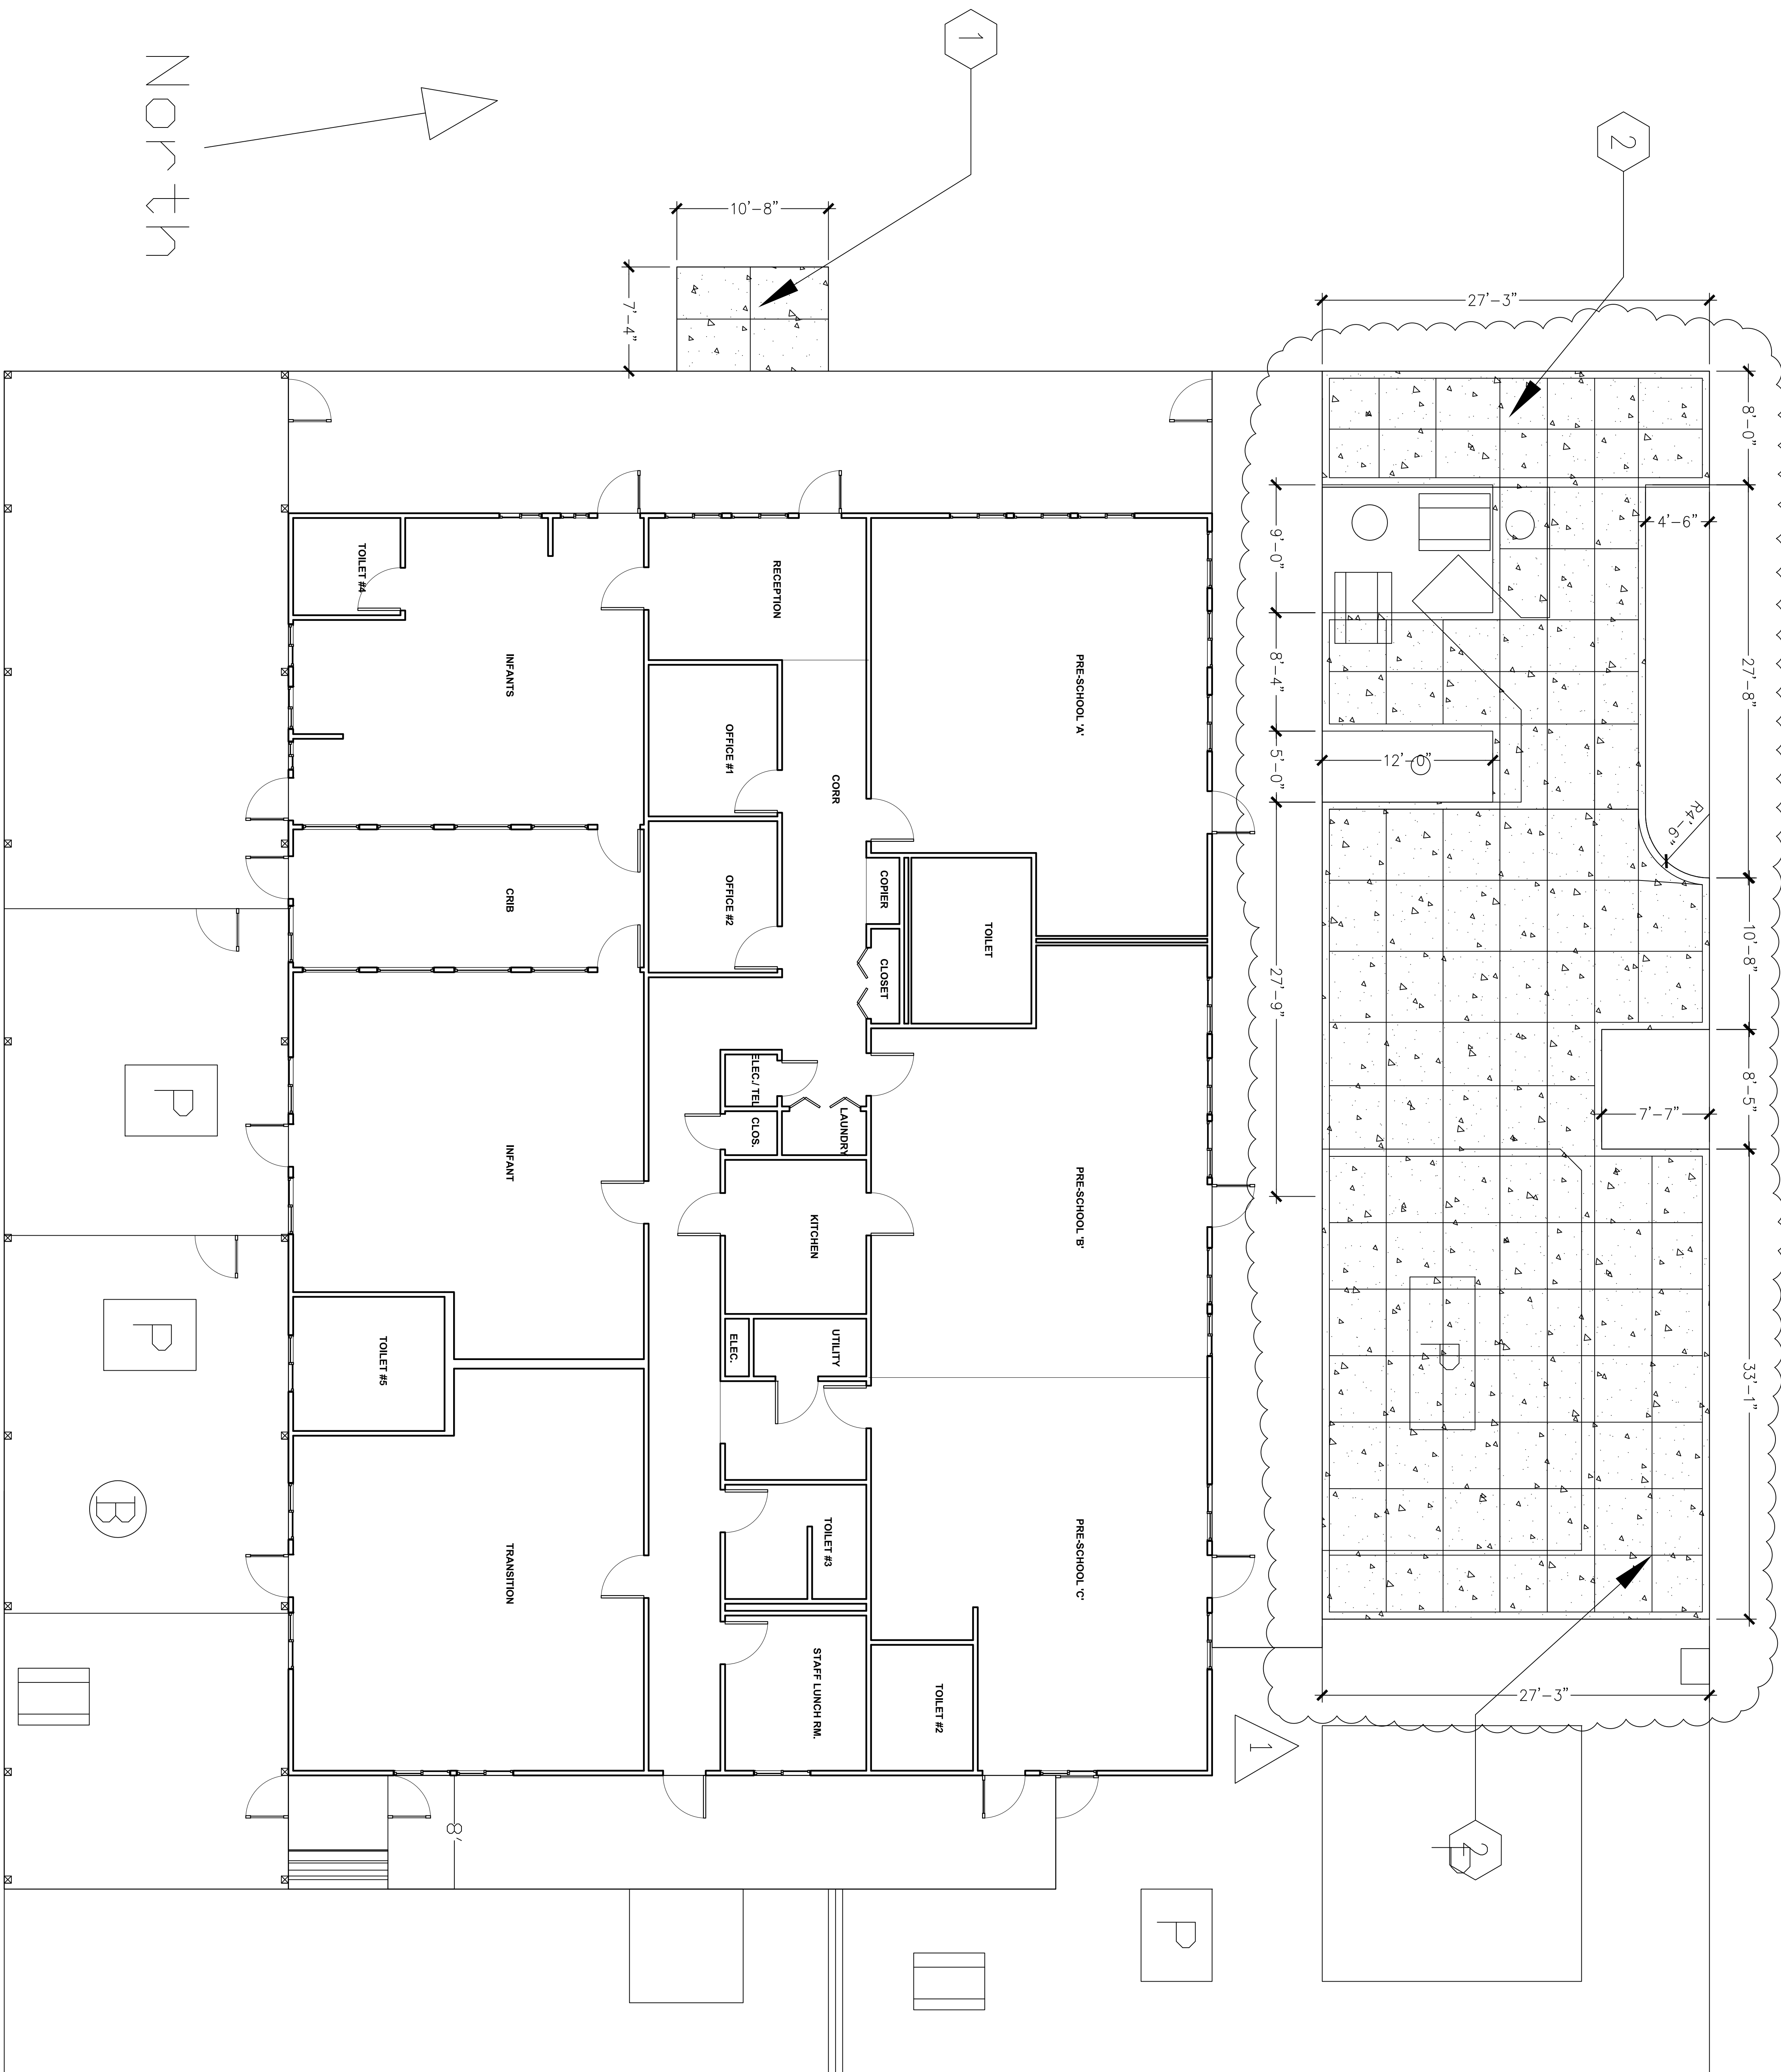

KEYED SHEET NOTES

- ① NEW CONCRETE RAMP ON GRADE MATCH EXISTING DECK RAMP DIMENSIONS AND SLOPE
5" CONCRETE FLATWALK w/ #4 @ 12" O.C. EA. WAY
EA. WAY CENTERED IN SLAB OVER 4" COMPACTED BASE
MATCH EXISTING LOCATION
- ② NEW CONCRETE FLATWALK w/ 6" CURB /
BAND TO RECEIVE POURED IN PLACE
RUBBER SURFACING
5" CONCRETE FLATWALK w/ #4 @ 12" O.C. EA. WAY
EA. WAY CENTERED IN SLAB OVER 4" COMPACTED BASE
OVER COMPACTED GRADE

NOTE:

1. CONCRETE SLOPES TO MATCH EXISTING CONDITIONS
 2. ALL FLATWORK TO RECEIVE BROOM FINISH
 3. CONCRETE TO BE NATURAL COLOR
 4. PROVIDE TOOLED EXPANSION JOINTS @ ALL FLATWORK 4'-0" TO 5'-0" O.C. MAX
 5. ADJUST TO SPACING TO FIT ALL DIMENSIONS ARE APPROXIMATE
- VERIFY IN FIELD

Building Number T6B

6.

15 12 13

Page 12 of 12

