

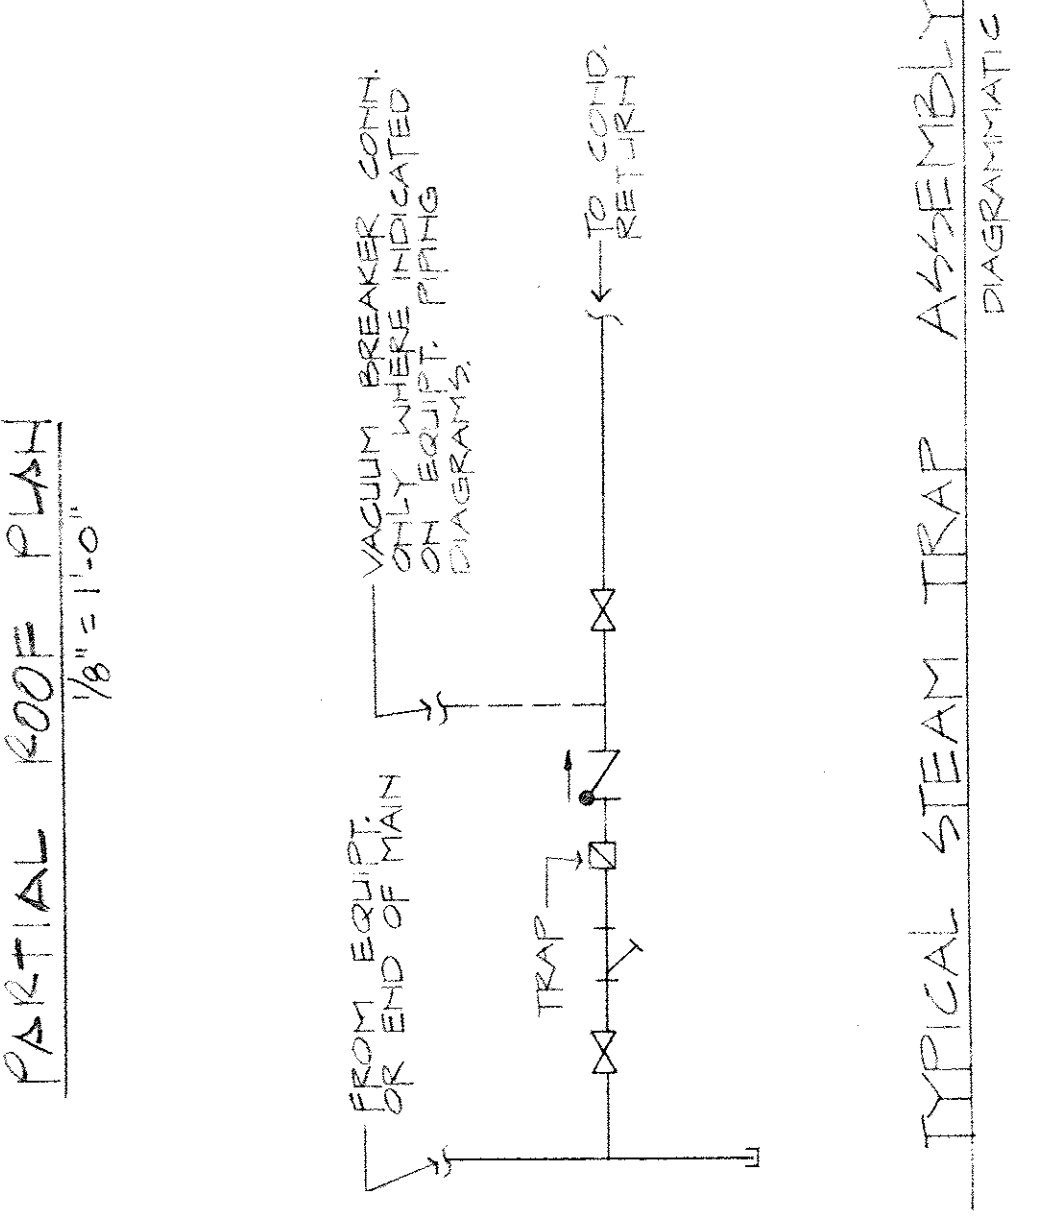
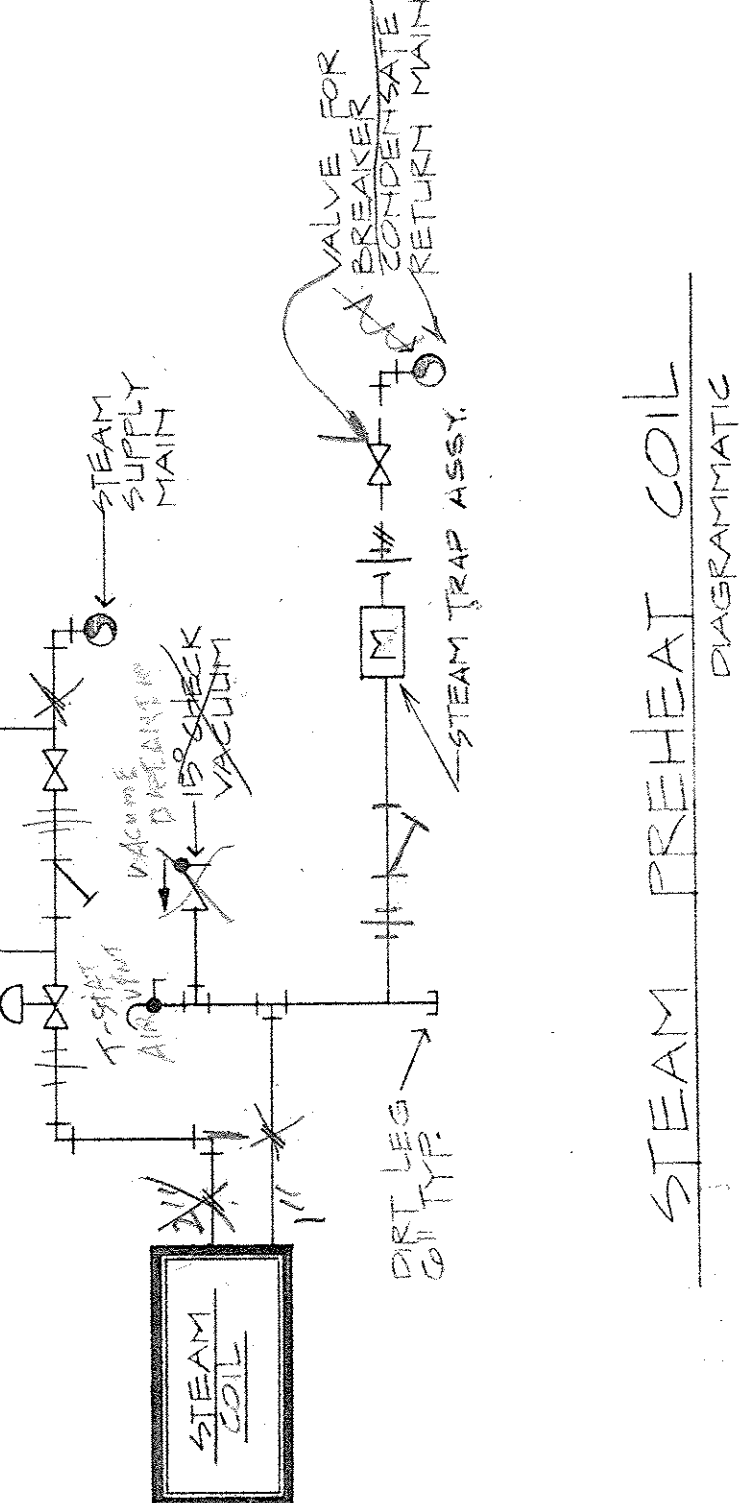


- MULTIZONE CONTROL SEQUENCE
1. Cold deck temperature is controlled by zone requiring the lowest leaving air temperature. (As reset by leaving air temperature.)
  2. When outside air damper is open, outside air damper set point, economizer controls become operative and outside air damper modulates to maintain cold deck entering air temperature at set point. (Equal to cold deck leaving air set point.)
  3. If outside air temperature is not cold enough to maintain cold deck temperature, cold deck controls supplement cooling by opening refrigerant valves.
  4. If return air relative humidity rises above set point (50% R.H.) of humidistat, cold deck control is overridden by humidistat thru high pressure selector to dehumidify.
  5. If mixed air relative humidity rises above set point (65% R.H.) of humidity limit, outside air damper modulate closed to maintain humidity level at 65% maximum.
  6. Cold deck temperature is controlled by the zone requiring the highest leaving air temperature. (Reset by leaving air temperature.) Controller modulates 2-way steam valve.
  7. Relief air dampers are controlled by the return air static pressure controller to maintain constant return air static pressure by modulating the dampers.

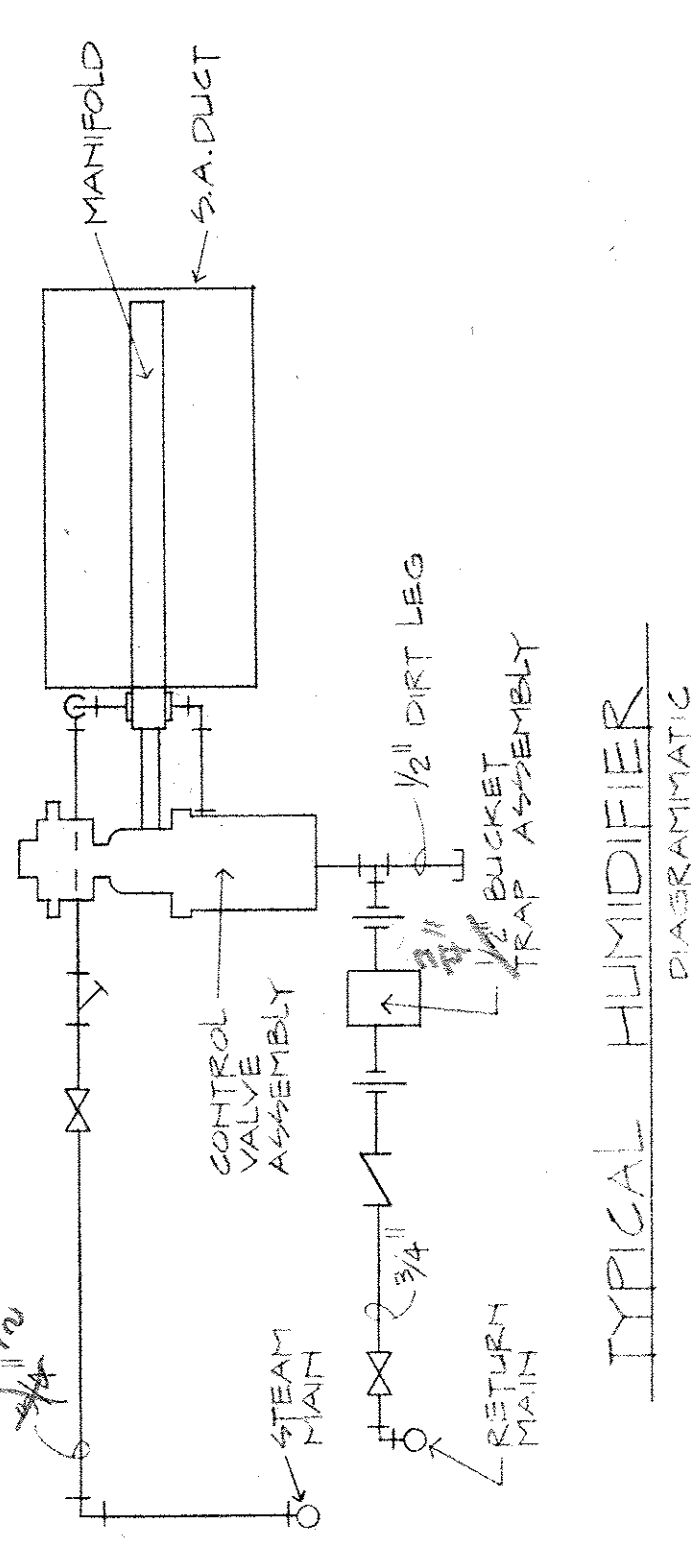

PARTIAL ROOF PLAN  
1/8" = 1'-0"

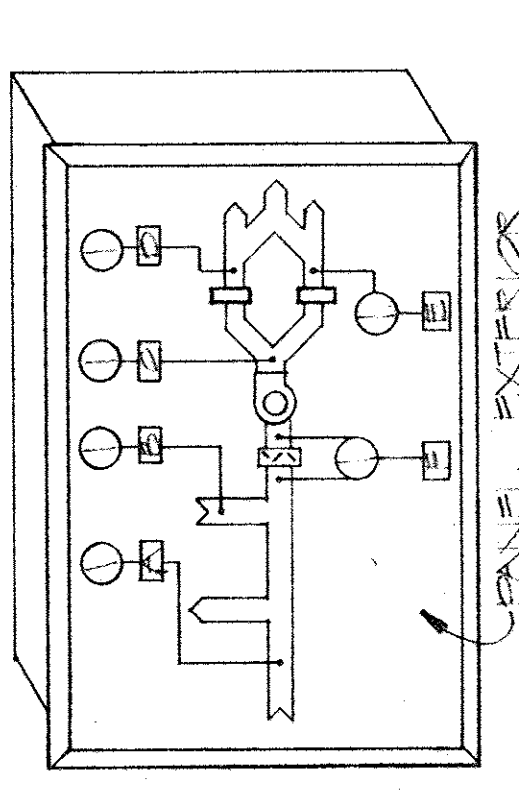

- LEGEND
- A RETURN AIR TEMPERATURE
  - B OUTSIDE AIR TEMPERATURE
  - C MIXED AIR TEMPERATURE
  - D HOT DECK TEMPERATURE
  - E COLD DECK TEMPERATURE
  - F FILTER AIR
  - G Road Switch (Emergency)

NO.		DATE	DESCRIPTION
107		BA	ICU REMODEL
108		BA	ICU REMODEL
