
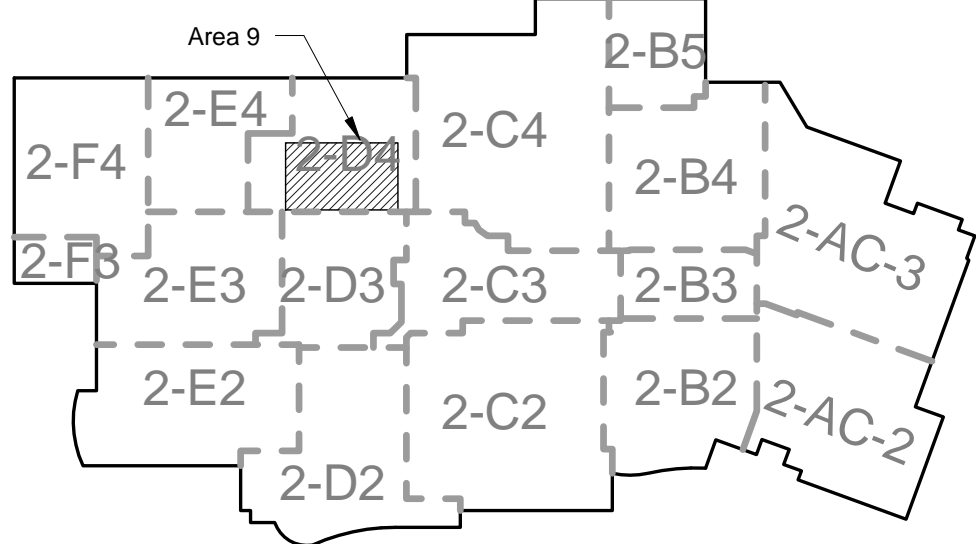


three inches = one foot
one and one half = one foot
one inch = one foot
three quarters inch = one foot
one half inch = one foot
three eighths inch = one foot
one quarter inch = one foot
one eighth inch = one foot

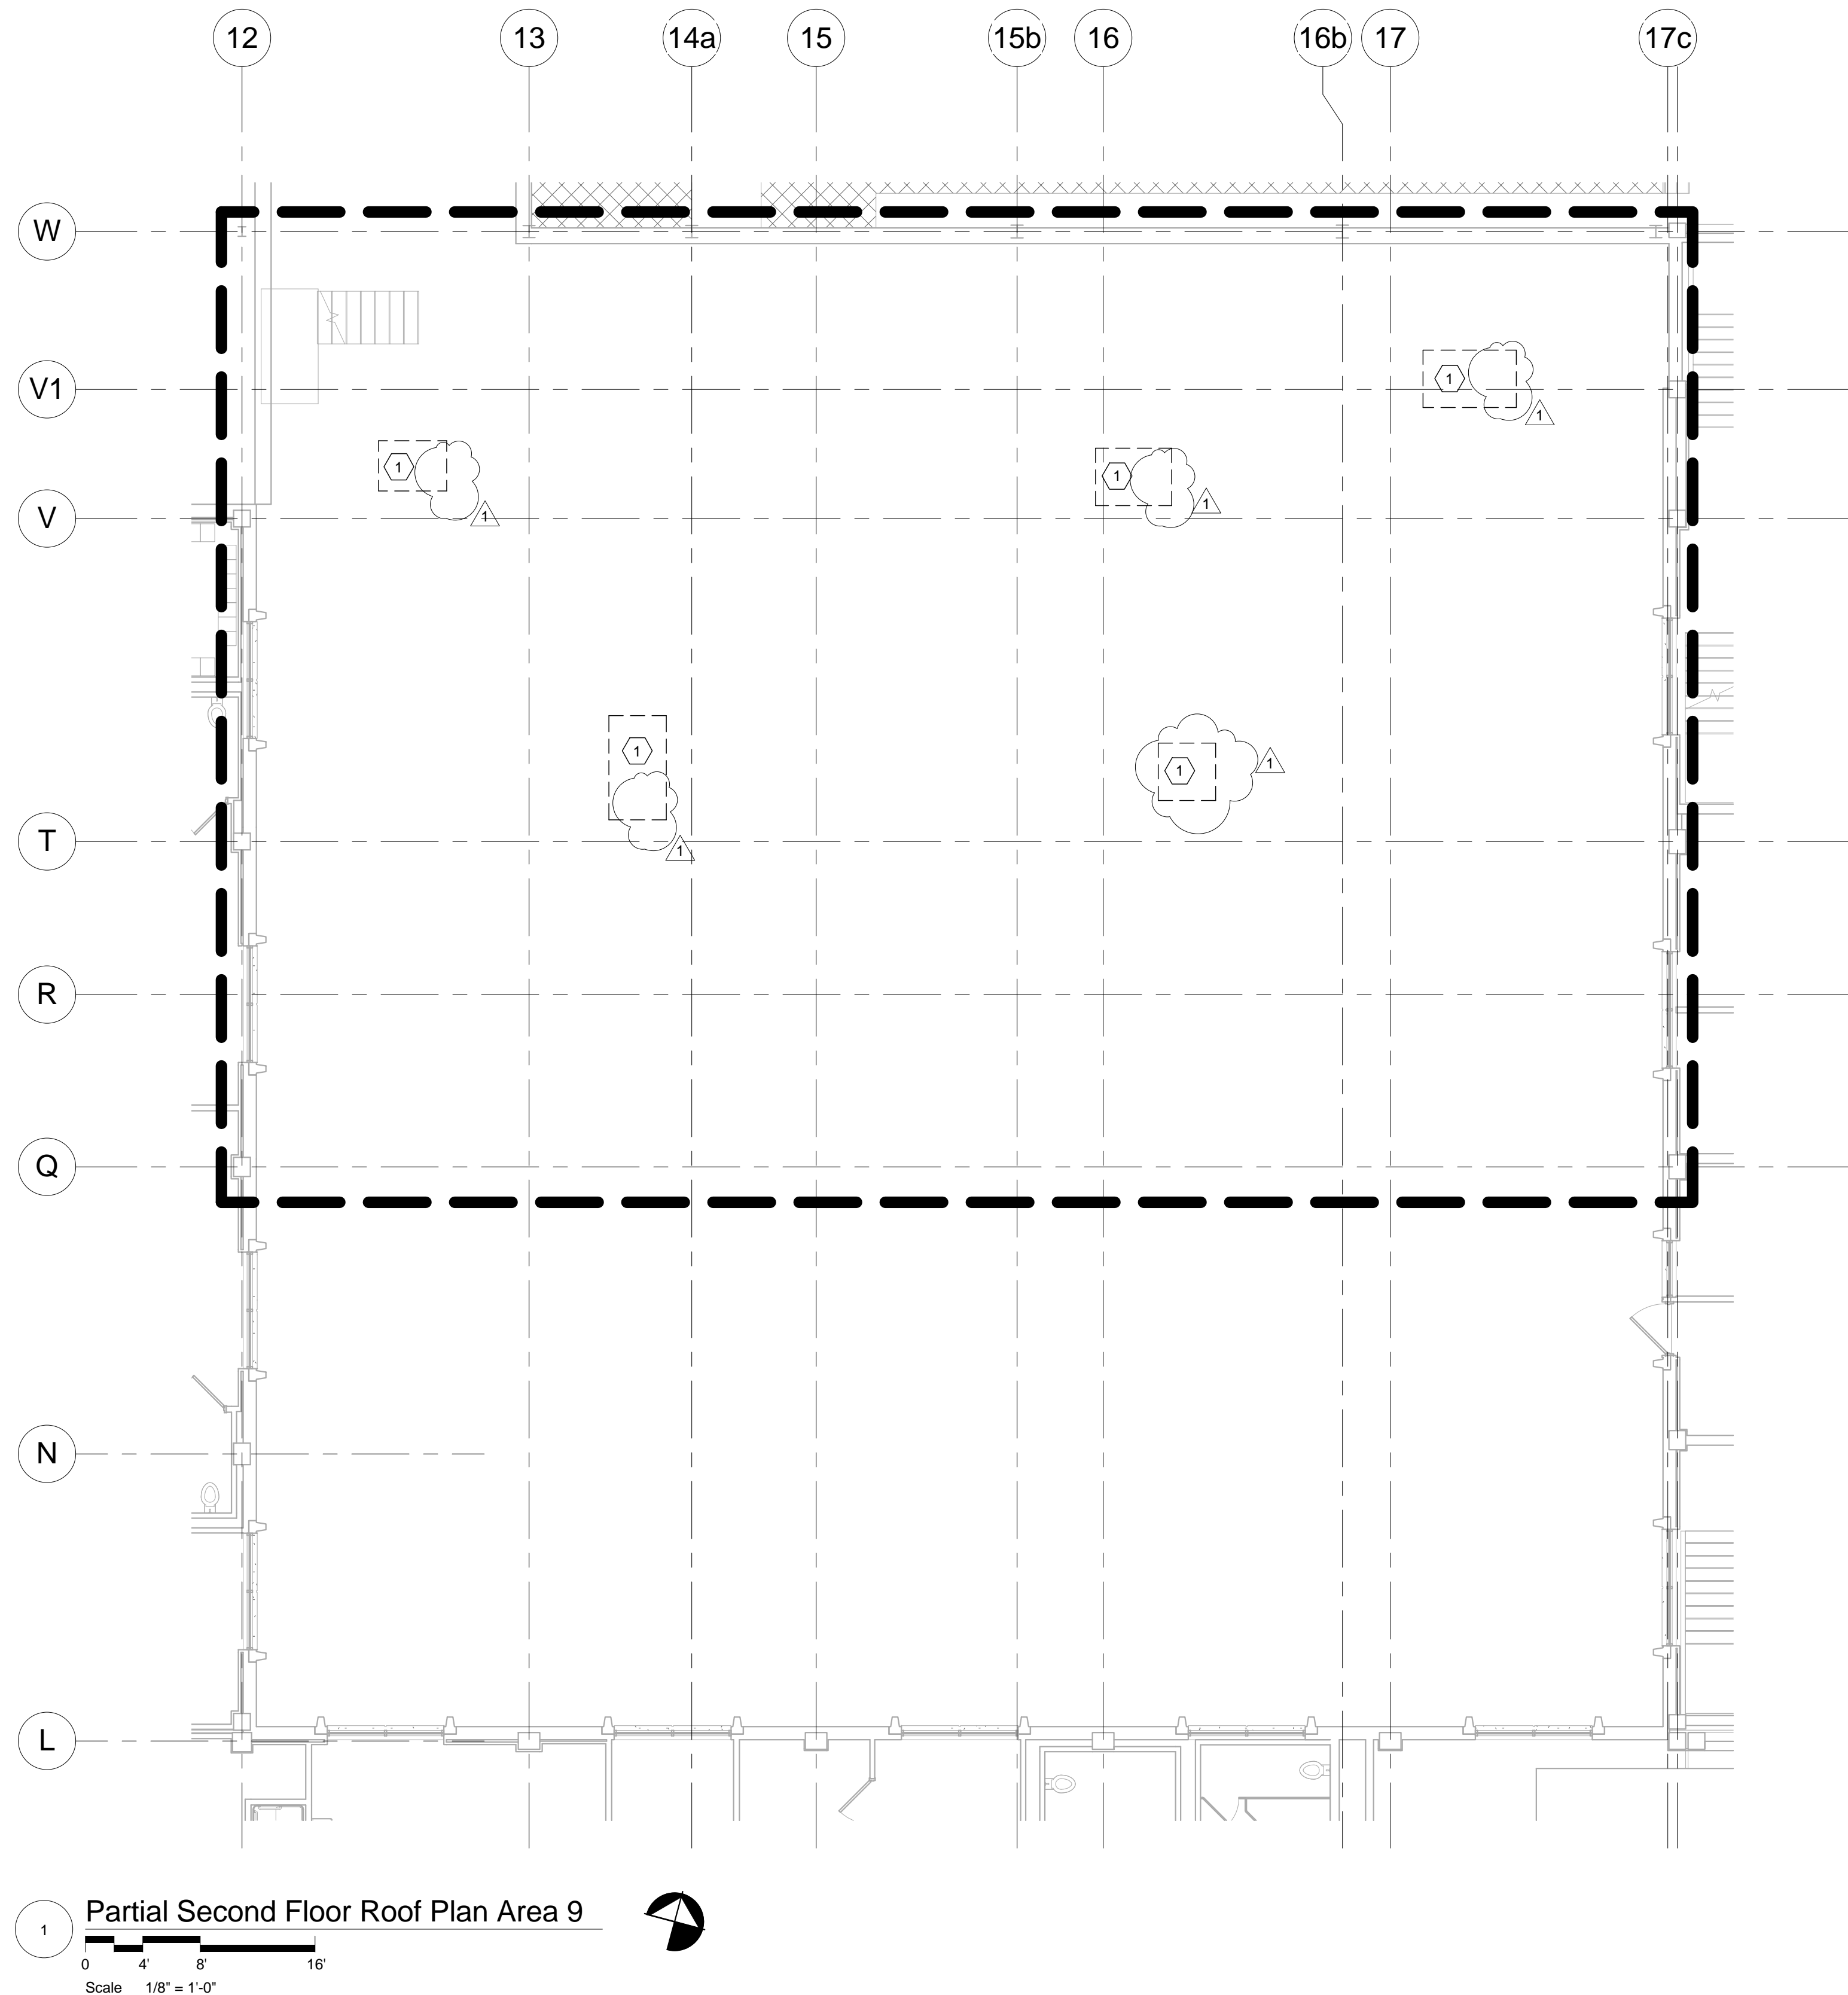


KEY PLAN - SECOND FLOOR
Not to Scale

ROOF PLAN GENERAL NOTES

1. The existing Ethylene-Interpolymer (EIP), Protected Roof Membrane Assembly (PRMA) roof is under a five year warranty by the manufacturer and installing contractor, William Roofing Co. Inc, phone number 440-238-3080. Coordinate all roofing construction with this company. Preserve existing roofing system warranty by patching holes and openings using approved materials and methods. Notify warrantors before proceeding with roof patching. At completion of roof patching, notify warrantors to obtain documentation verifying that existing roofing system has been inspected and warranty remains in effect. Submit documentation at project closeout.
2. Project scope line is indicated for general intent only. Contractor will complete all work regardless if it is located outside of project scope area as indicated on any drawing.
3. Weather Limitations: Proceed with installation only when existing and forecasted weather conditions permit roofing system to be installed according to manufacturer's written instructions and warranty requirements. Do not apply roofing membrane during inclement or windy weather with ambient temperatures below 40° and falling. During cold weather conditions, the temperature/humidity ratio must be at least 5° F above the dew point of ambient air and rising. Protect roof deck, insulation and interior spaces from moisture at the end of the day's work or when the weather is threatening.
4. Contractor shall provide additional roof patches indicated by work shown on drawings.

ROOF PLAN CODED NOTES

- 1 Provide infill at existing roof openings. See also drawing 1-S1 and mechanical drawings. Patch EIP-PRMA roof per 07 13 30 at locations exposed to weather.

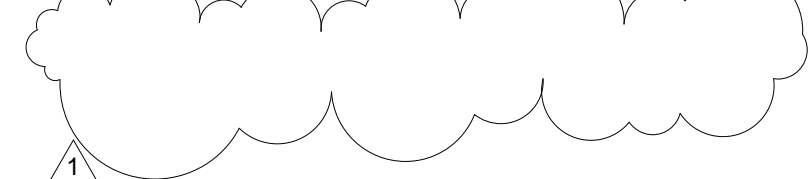

FINAL CONSTRUCTION DOCUMENTS SUBMISSION	11/04/14
ADDENDUM #1	08/14/15
Revisions:	Date

CONSULTANTS:




FREDRICK, FREDRICK & HELLER
ENGINEERS, INC.
672 EAST ROYALTON ROAD
BROADVIEW HTS., OHIO 44147
TEL (440) 546-9696
FAX: (440) 546-9699



BARBER & HOFFMAN, INC.
Consulting Engineers

2217 East 9th Street, Suite 350
Cleveland, OH 44115-1257
216-875-0100/ (F) 216-875-0111
barberhoffman.com

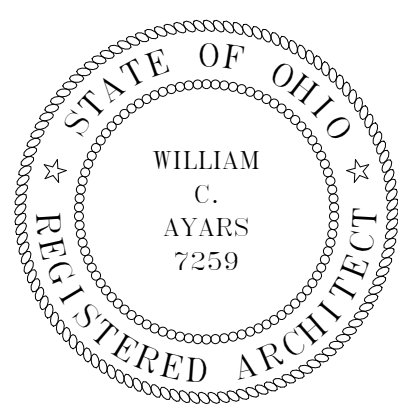

ARCHITECT:

Perspectus
architecture

13212 Shaker Square Suite 204 Cleveland, Ohio 44120
P. 216.752.1800 F. 216.752.3833

DESIGN AND CONSTRUCTION DOCUMENTS AS INSTRUMENTS OF SERVICE ARE GIVEN IN CONFIDENCE AND REMAIN THE PROPERTY OF PERSPECTUS ARCHITECTURE. THE USE OF THIS DESIGN AND THESE CONSTRUCTION DOCUMENTS FOR PURPOSES OTHER THAN THE SPECIFIC PROJECT NAMED HEREIN IS STRICTLY PROHIBITED WITHOUT THE EXPRESSED WRITTEN CONSENT OF PERSPECTUS ARCHITECTURE. COPYRIGHT © 2004.

Drawing Title
PARTIAL SECOND FLOOR ROOF PLAN

Approved:

FINAL CONSTRUCTION DOCUMENTS SUBMISSION
FULLY SPRINKLERED

Project Title
**ENHANCE MEDICAL,
SPECIALTY CARE, AND
ADMIN. SERVICES**

Location
VAMC - WADE PARK

Date
11/04/2014

Checked
RN

Drawn
BG

Project Number
541-15-101

Building Number
1

Drawing Number
1-03.4

Dwg. of

Office of
Facilities
Management

