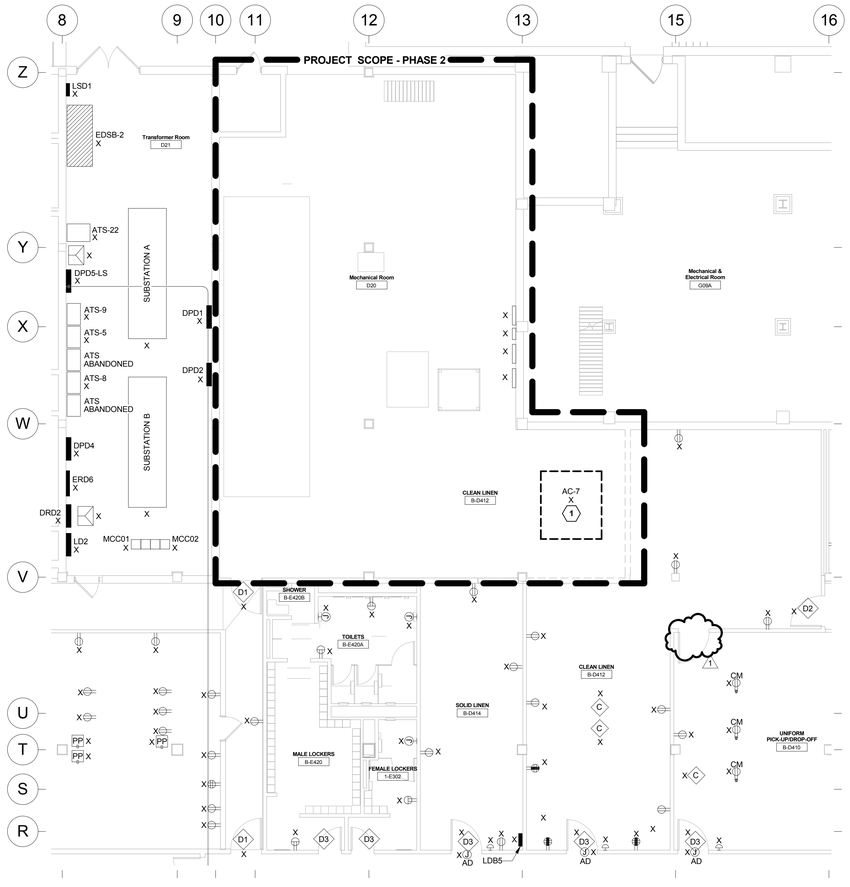

PARTIAL BASEMENT POWER AND SECURITY DEMOLITION PLAN - PHASE 2 (1)

1/8" = 1'-0"

0' 4' 8' 16' 32'

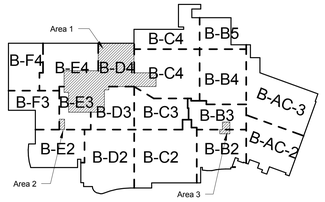

KEY PLAN - BASEMENT FLOOR

Not to Scale

ELECTRICAL DEMOLITION NOTES

D1	ALL EXISTING LIGHTING FIXTURES, RECEPTACLES, SPECIAL SYSTEMS OUTLETS, CONDUIT, WIRING ETC. THAT WILL NOT BE REUSED IN THE REMODELED INSTALLATION SHALL BE REMOVED UNLESS OTHERWISE NOTED. THIS DEMOLITION SHALL INCLUDE ALL ELECTRICAL ITEMS SHOWN ON THIS PLAN THAT ARE NOT DESIGNATED BY "X", "XN" OR "XRR" AND ALL OTHER ADDITIONAL ITEMS THAT ARE NOT SHOWN BUT THAT MUST BE REMOVED IN ORDER TO PRODUCE A NEAT, FINISHED, PROPERLY FUNCTIONING ELECTRICAL INSTALLATION. MAINTAIN CIRCUIT CONTINUITY TO ALL EXISTING REUSED ELECTRICAL SYSTEMS COMPONENTS - PROVIDE ALL CONDUIT AND WIRING NECESSARY TO ACHIEVE THE SAME. THE CONTRACTOR SHALL FIELD VERIFY THE NATURE AND EXTENT OF ALL DEMOLITION WORK AND SHALL INCLUDE COST FOR THE SAME IN THE BID SUBMITTAL.
D2	ALL EXISTING REMOVED ELECTRICAL EQUIPMENT, DEVICES, ETC. THAT ARE NOT RETAINED BY THE OWNER SHALL BE DISPOSED OF BY THE ELECTRICAL CONTRACTOR.
D3	DASHED WALLS ON PLAN INDICATE EXISTING CONSTRUCTION TO BE REMOVED.
D4	REFER TO ELECTRICAL LEGEND FOR ALL SYMBOL DESIGNATIONS. NOTE SPECIAL ATTENTION TO SELECTED EXISTING DEVICES, WIREWAYS, ETC. MARKED XB, XRR OR XN, AND REMOVE/BLANK OFF, RELOCATE OR REPLACE THESE COMPONENTS AS REQUIRED.
D5	MAINTAIN CIRCUIT CONTINUITY TO ALL EXISTING ELECTRICAL SYSTEM COMPONENTS IN AREAS NOT BEING REMODELED UNLESS OTHERWISE NOTED. PROVIDE ALL CONDUIT AND WIRING EXTENSIONS NECESSARY TO ACHIEVE SAME.
D6	THE ELECTRICAL CONTRACTOR SHALL CLOSELY COORDINATE ALL ELECTRICAL DEMOLITION WORK WITH THE GENERAL AND MECHANICAL CONTRACTORS, AND SHALL DISCONNECT ALL REQUIRED CIRCUITS IN A TIMELY MANNER.

POWER AND SECURITY DEMO CODED NOTES

1	DISCONNECT EXISTING AIR HANDLING UNIT AND REMOVE CONDUIT, WIRING, AND ALL ASSOCIATED ELECTRICAL EQUIPMENT COMPLETE BACK TO SOURCE.

FINAL CONSTRUCTION DOCUMENTS SUBMISSION
FULLY SPRINKLERED

Revisions:	Date
FINAL CONSTRUCTION DOCUMENTS SUBMISSION	11/04/14
ADDENDUM #1	08/14/15

CONSULTANTS:

FREDRICK, FREDRICK & HELLER ENGINEERS, INC.
672 EAST ROYALTON ROAD
BROADVIEW HT'S., OHIO 44147
TEL: (440) 546-9696
FAX: (440) 546-9699

1100 West 9th Street
Cleveland, OH 44113-1003
216-875-0100/ (F) 216-875-0111
barberhoffman.com
BARBER & HOFFMAN, INC.
Consulting Engineers

STATE OF OHIO
M.P. LONG
59459
REGISTERED
PROFESSIONAL ENGINEER

ARCHITECT:

Perspectus architecture
13212 Shaker Square Suite 204 Cleveland, Ohio 44120
P. 216.752.1800 F. 216.752.3833

DESIGN AND CONSTRUCTION DOCUMENTS AS INSTRUMENTS OF SERVICE ARE GIVEN IN CONFIDENCE AND REMAIN THE PROPERTY OF PERSPECTUS ARCHITECTURE. THE USE OF THIS DESIGN AND THESE CONSTRUCTION DOCUMENTS ARE RESTRICTED TO THE SPECIFIC USE FOR THE PROJECT NAMED HEREIN AND ARE STRICTLY PROHIBITED WITHOUT THE EXPRESSED WRITTEN CONSENT OF PERSPECTUS ARCHITECTURE.
COPYRIGHT © 2004.

Drawing Title: **PARTIAL BASEMENT POWER AND SECURITY DEMOLITION PLAN - PHASE 2**

Approved:

Project Title: **ENHANCE MEDICAL, SPECIALTY CARE, AND ADMIN. SERVICES**

Location: **VAMC - WADE PARK**

Date: **11/04/2014** | Checked: MPL | Drawn: CPC

Project Number: 541-15-101

Building Number: 1

Drawing Number: **1-E2.7**

Dwg. of

Office of Facilities Management

Department of Veterans Affairs

VA FORM 08-6231, OCT 1978