


VA - STRATTON - FISHER HOUSE
N.T.S.
03/09/15

FIRST FLOOR

NOTES:
*3 REFER TO PHOTO #1
ELEVATION FOR ACCENT
PAINT LOCATIONS THIS
ELEVATION
*4 REFER TO PHOTO #2
ELEVATION FOR ACCENT PAINT
BELOW CHAIR RAIL.

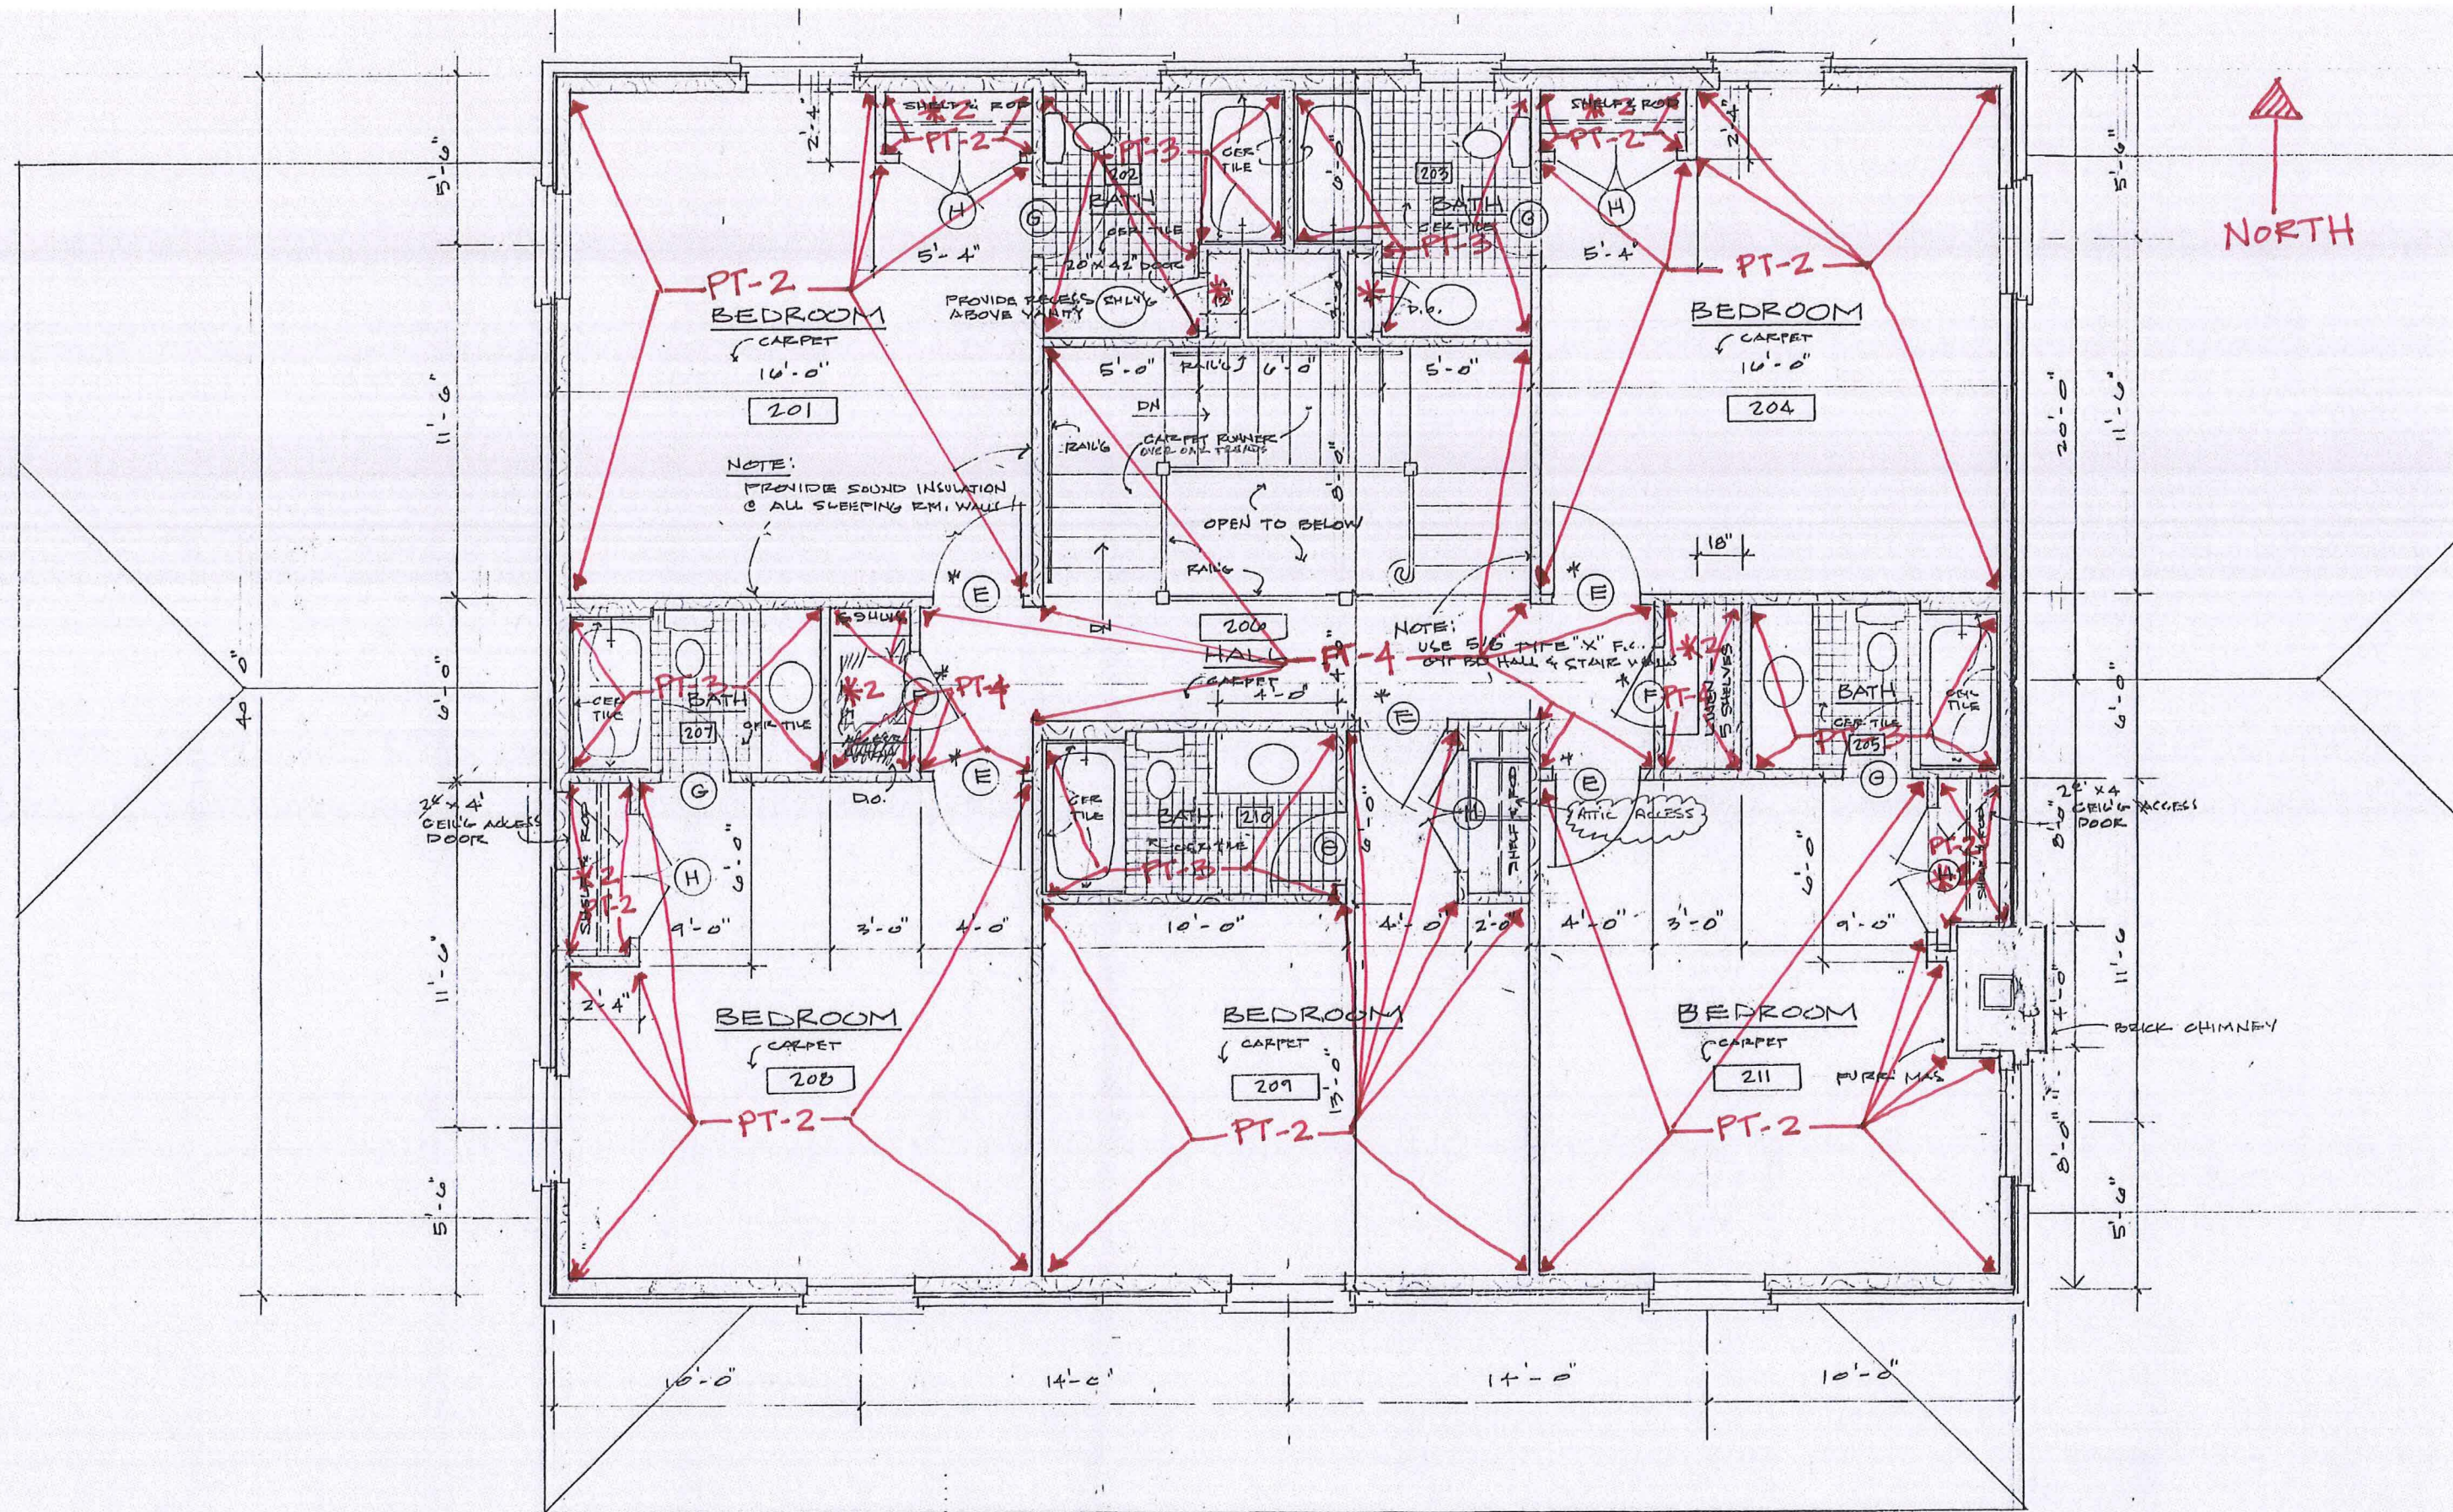

VA-STRATTON - FISHER HOUSE
N.T.S.
03/09/15

SECOND FLOOR

NOTES:
* CABINET - INTERIOR WALLS & SHELVING
PT-7
*2 CLOSET INTERIORS - SHELVING & INNER
TRIM PT-7