

ONE INCH = FORTY FEET (1" = 40')

THREE INCHES = ONE FOOT

ONE AND ONE HALF INCHES = ONE FOOT

THREE QUARTERS INCH = ONE FOOT

ONE HALF INCH = ONE FOOT




ONE QUARTER INCH = ONE FOOT

ONE EIGHT INCH = ONE FOOT

ONE SIXTEENTH INCH = ONE FOOT

NEW AND OLD ROOM NUMBERS LEGEND

NEW	OLD
1N126	1N133
1N130	1N135
1MN120	1MN127
1MN130	1MN135

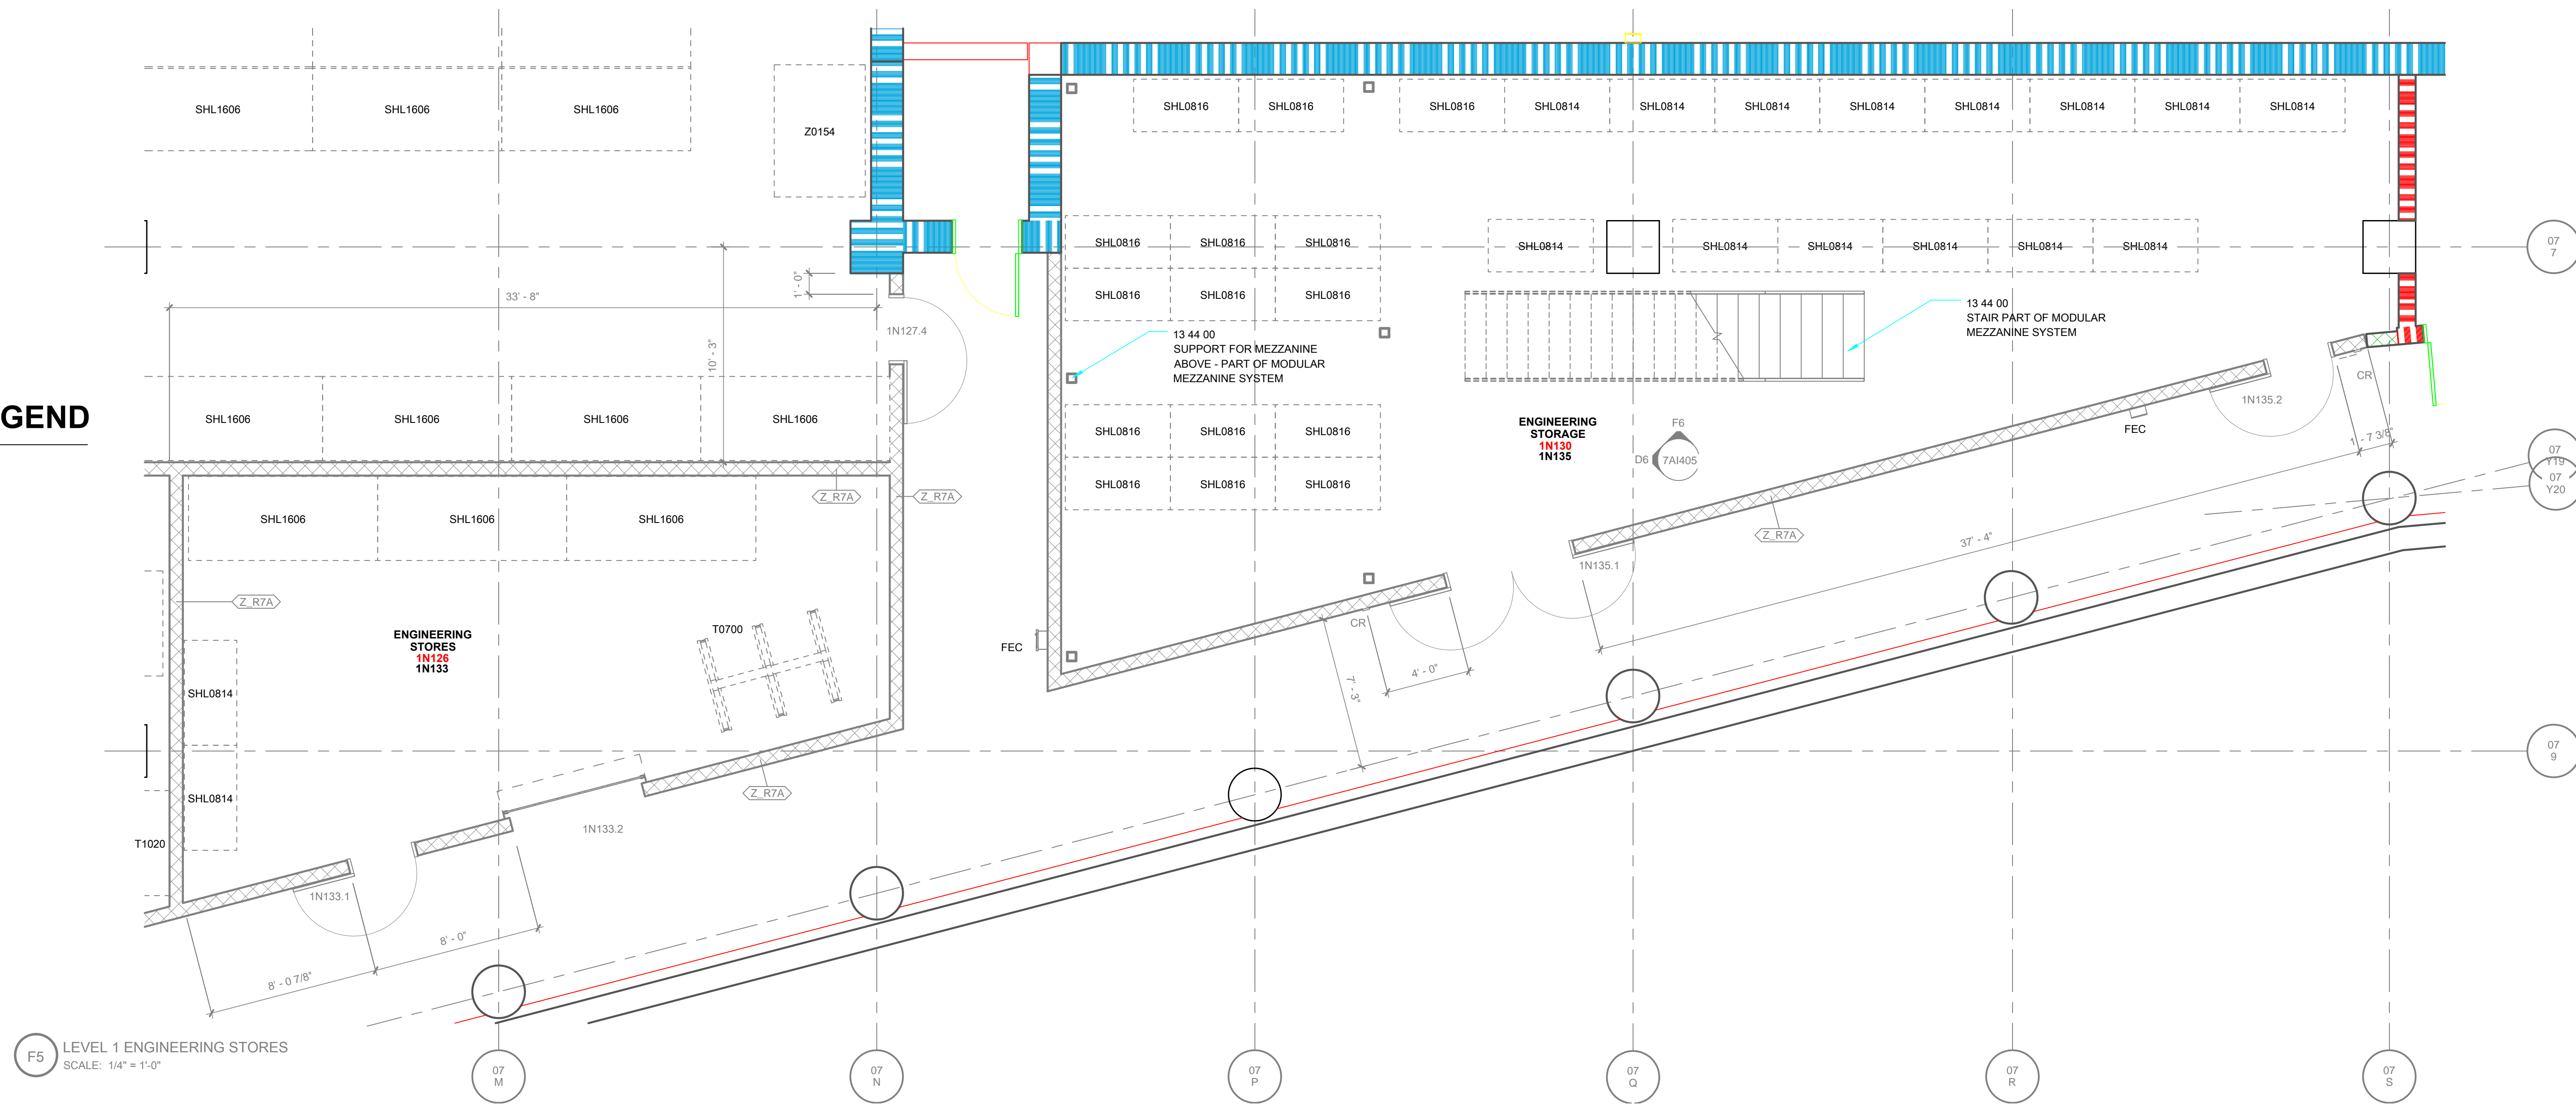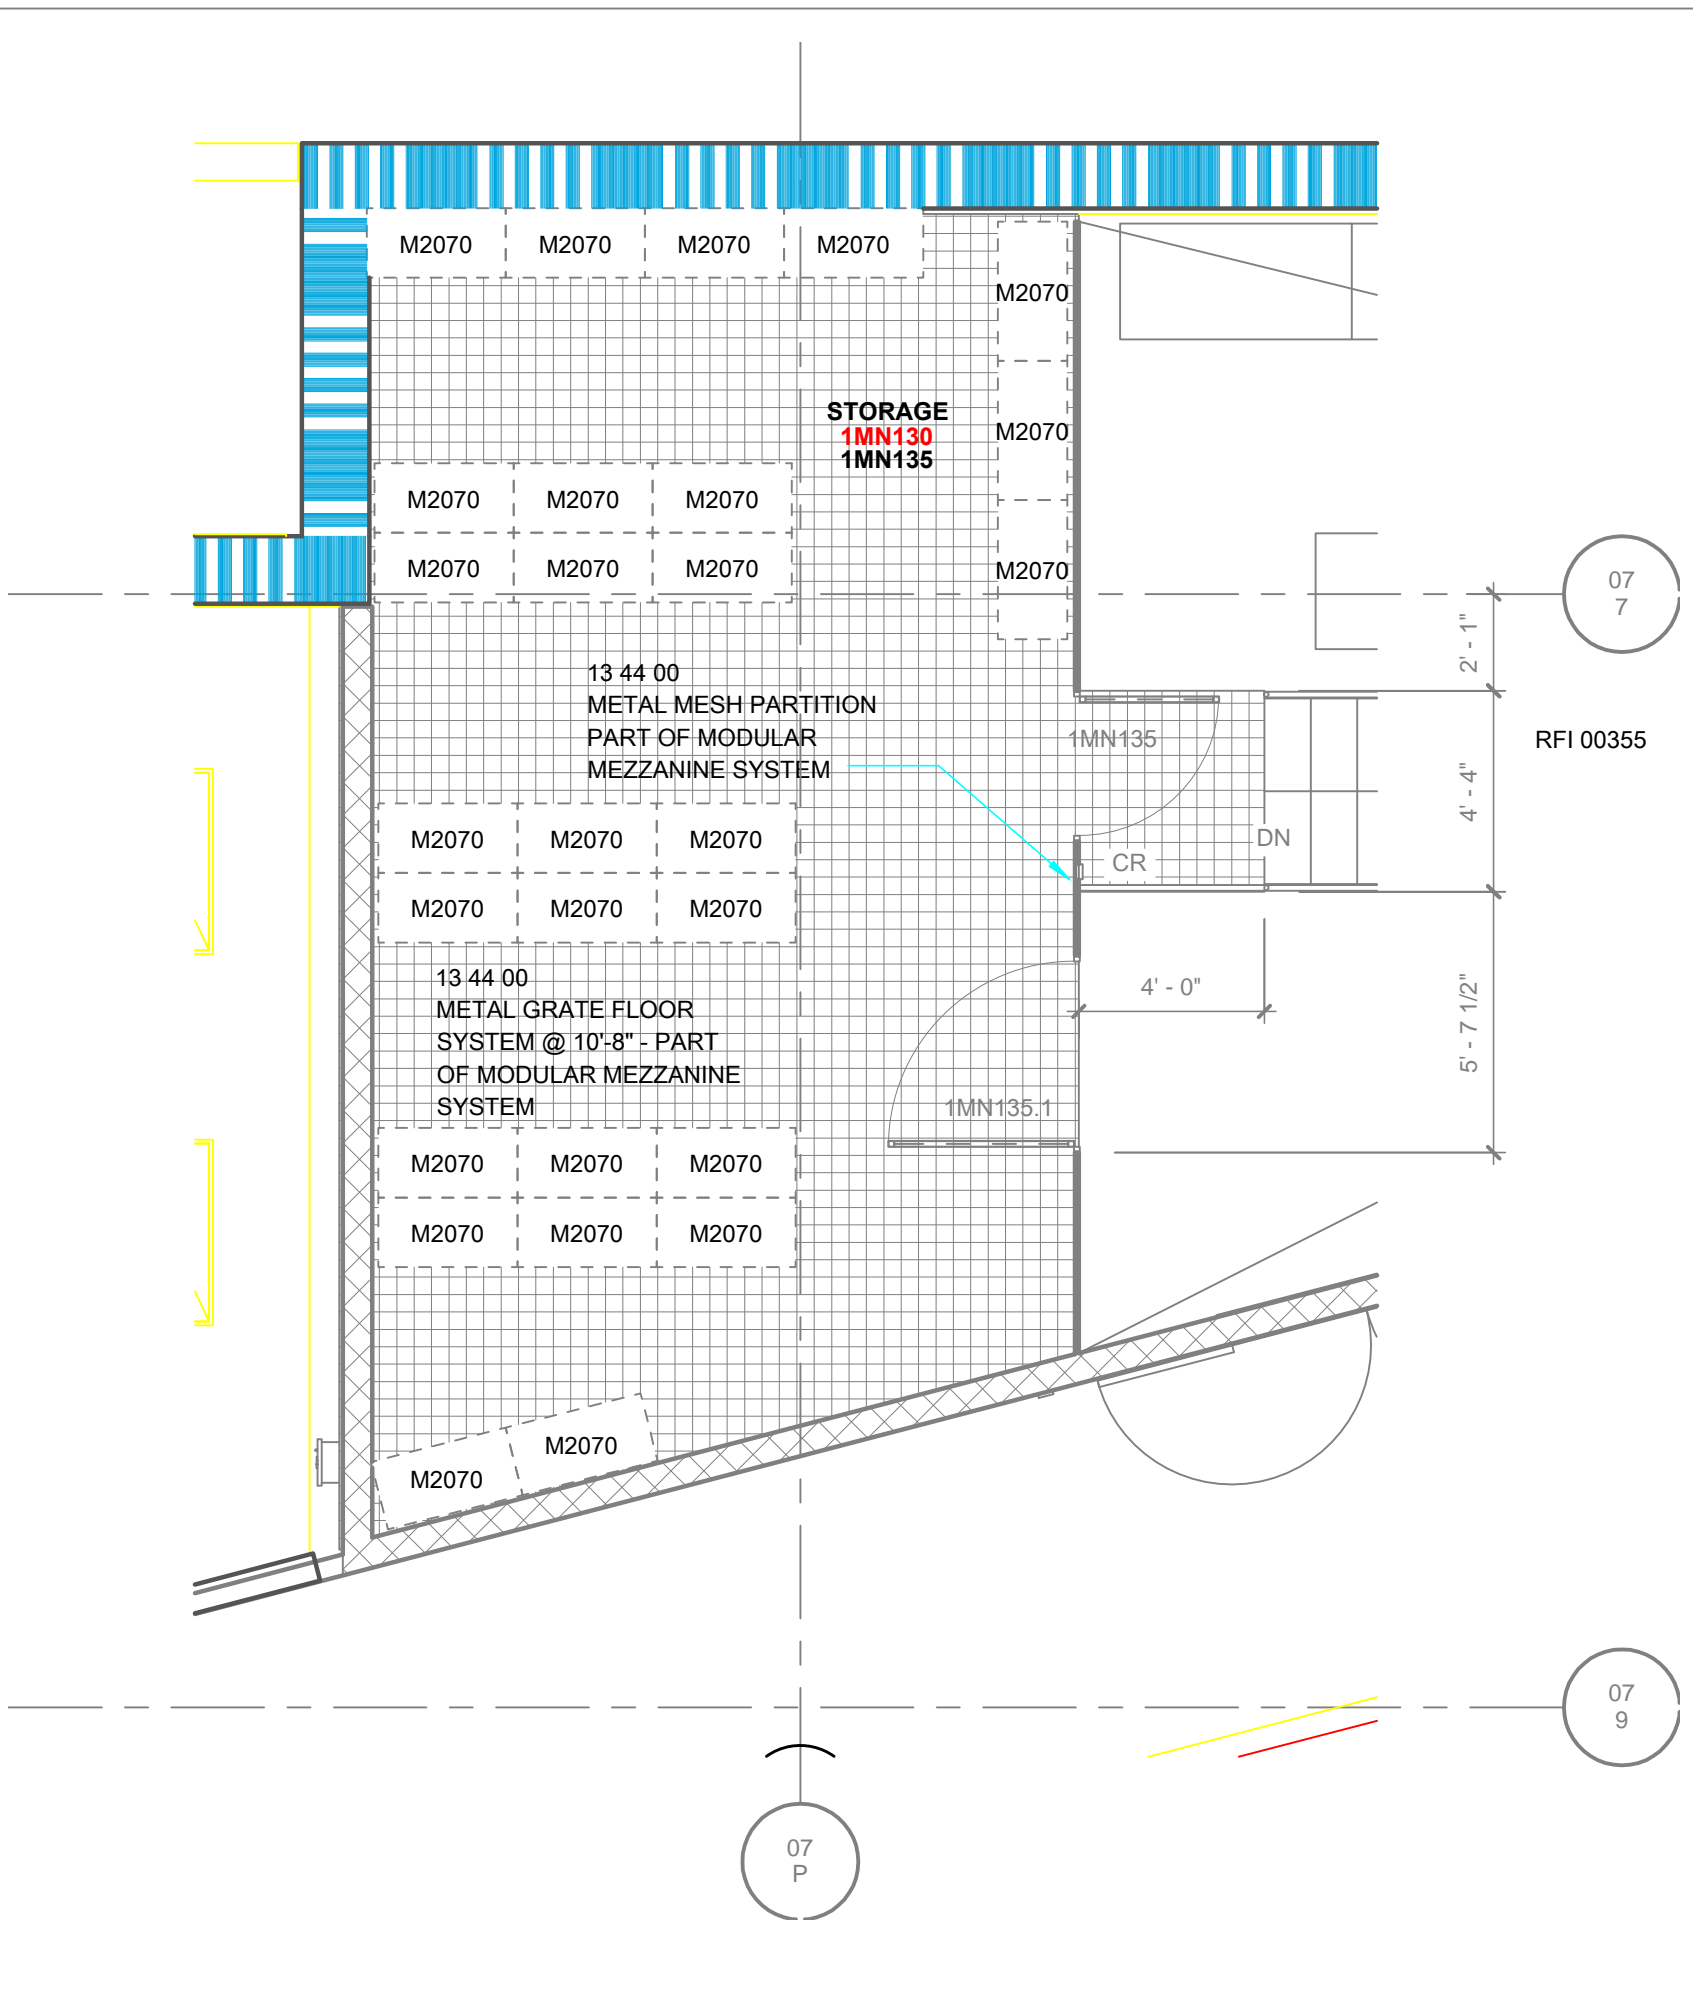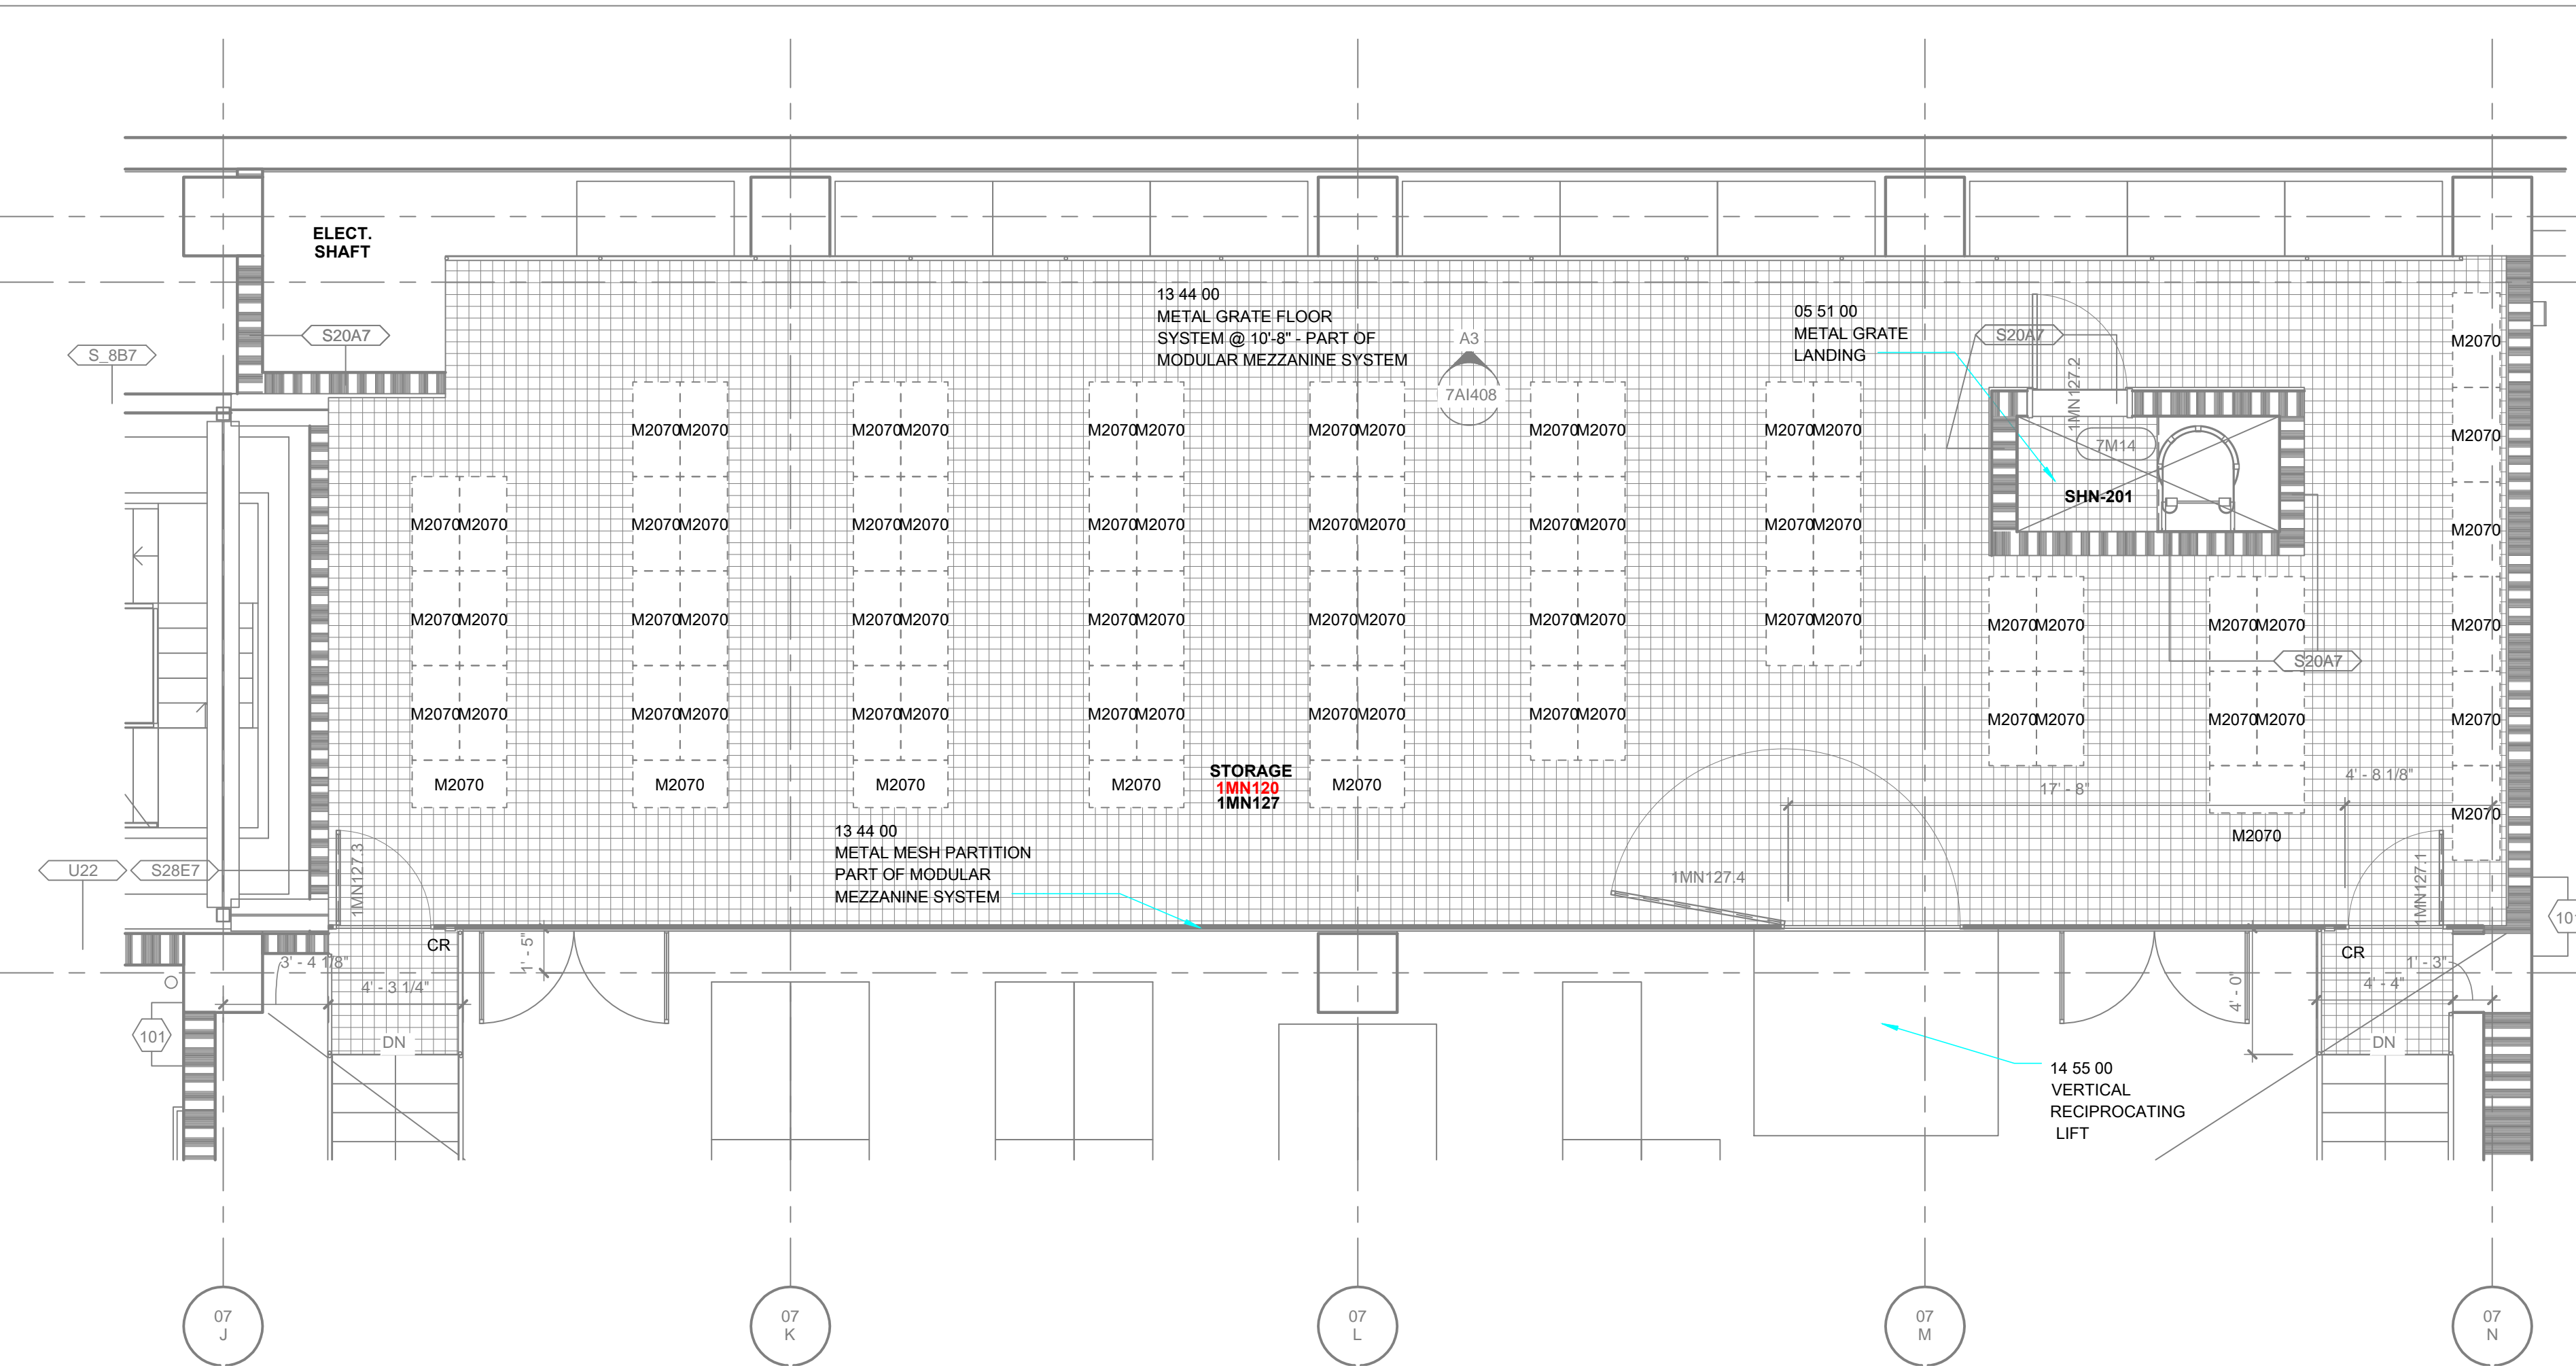

REVISIONS:	DATE
3 RFI Responses	5/1/2012

CONSULTANTS:
DESMAN ASSOCIATES / PARKING
CODE CONSULTANTS, INC. / CODE CONSULTANT
THE SEXTANT GROUP / AV & ACOUSTICAL
HAMMER DESIGN ASSOCIATES / FOOD SERVICE
PYBURN & ODOM / ABATEMENT
TATA & HOWARD / TANK CONSULTANT

ARCHITECT/ENGINEERS:
SCHRENK & PETERSON CONSULTING ENGINEERS / CIVIL
KORDA/NEMETH ENGINEERING / STRUCTURAL
BR+A CONSULTING ENGINEERS / MECH, ELECT, PLUMBING, LOW VOLTAGE
ARCHITECTURAL ENGINEERING / PLUMBING
SCALES ASSOCIATES / FIRE PROTECTION

DRAWING TITLE
BLDG 7 ENLARGED VIEWS

APPROVED: PROJECT DIRECTOR

PROJECT TITLE
SLVHCS REPLACEMENT MEDICAL
CENTER PROJECT

LOCATION
NEW ORLEANS, LOUISIANA

DATE
February 29, 2012

CHECKED
DV

DRAWN
JEN

PROJECT NUMBER
629-HS2-401

BUILDING NUMBER
7

DOCUMENT SET PACKAGE
WP_08

DRAWING NUMBER
7A1405

OFFICE OF
CONSTRUCTION
AND FACILITIES
MANAGEMENT

Department of
Veterans Affairs

CONSTRUCTION DOCUMENTS 1
FULLY SPRINKLERED