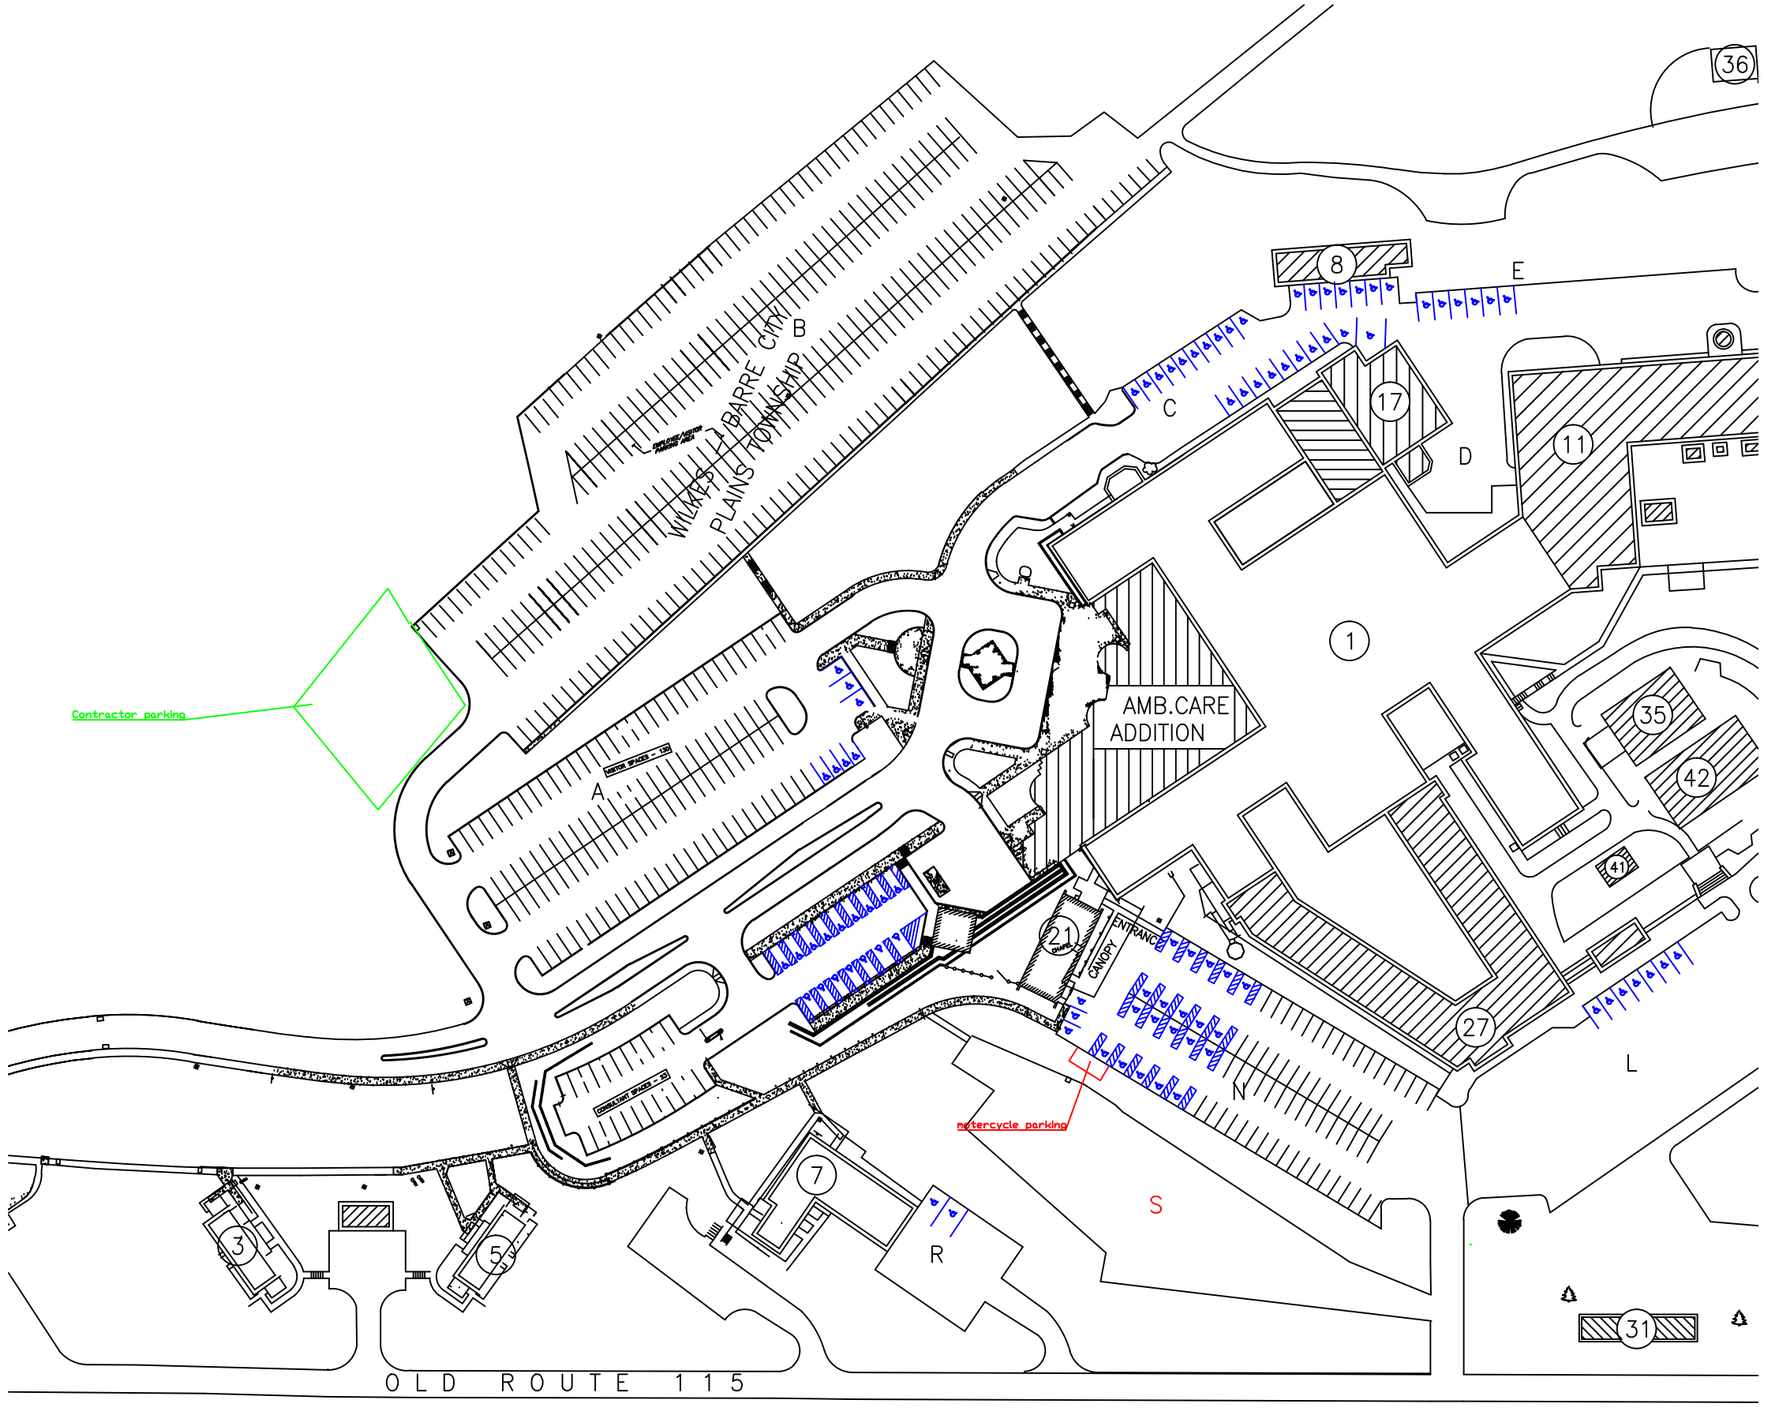

WILKES-BARRE VAMC
SITE PLAN