
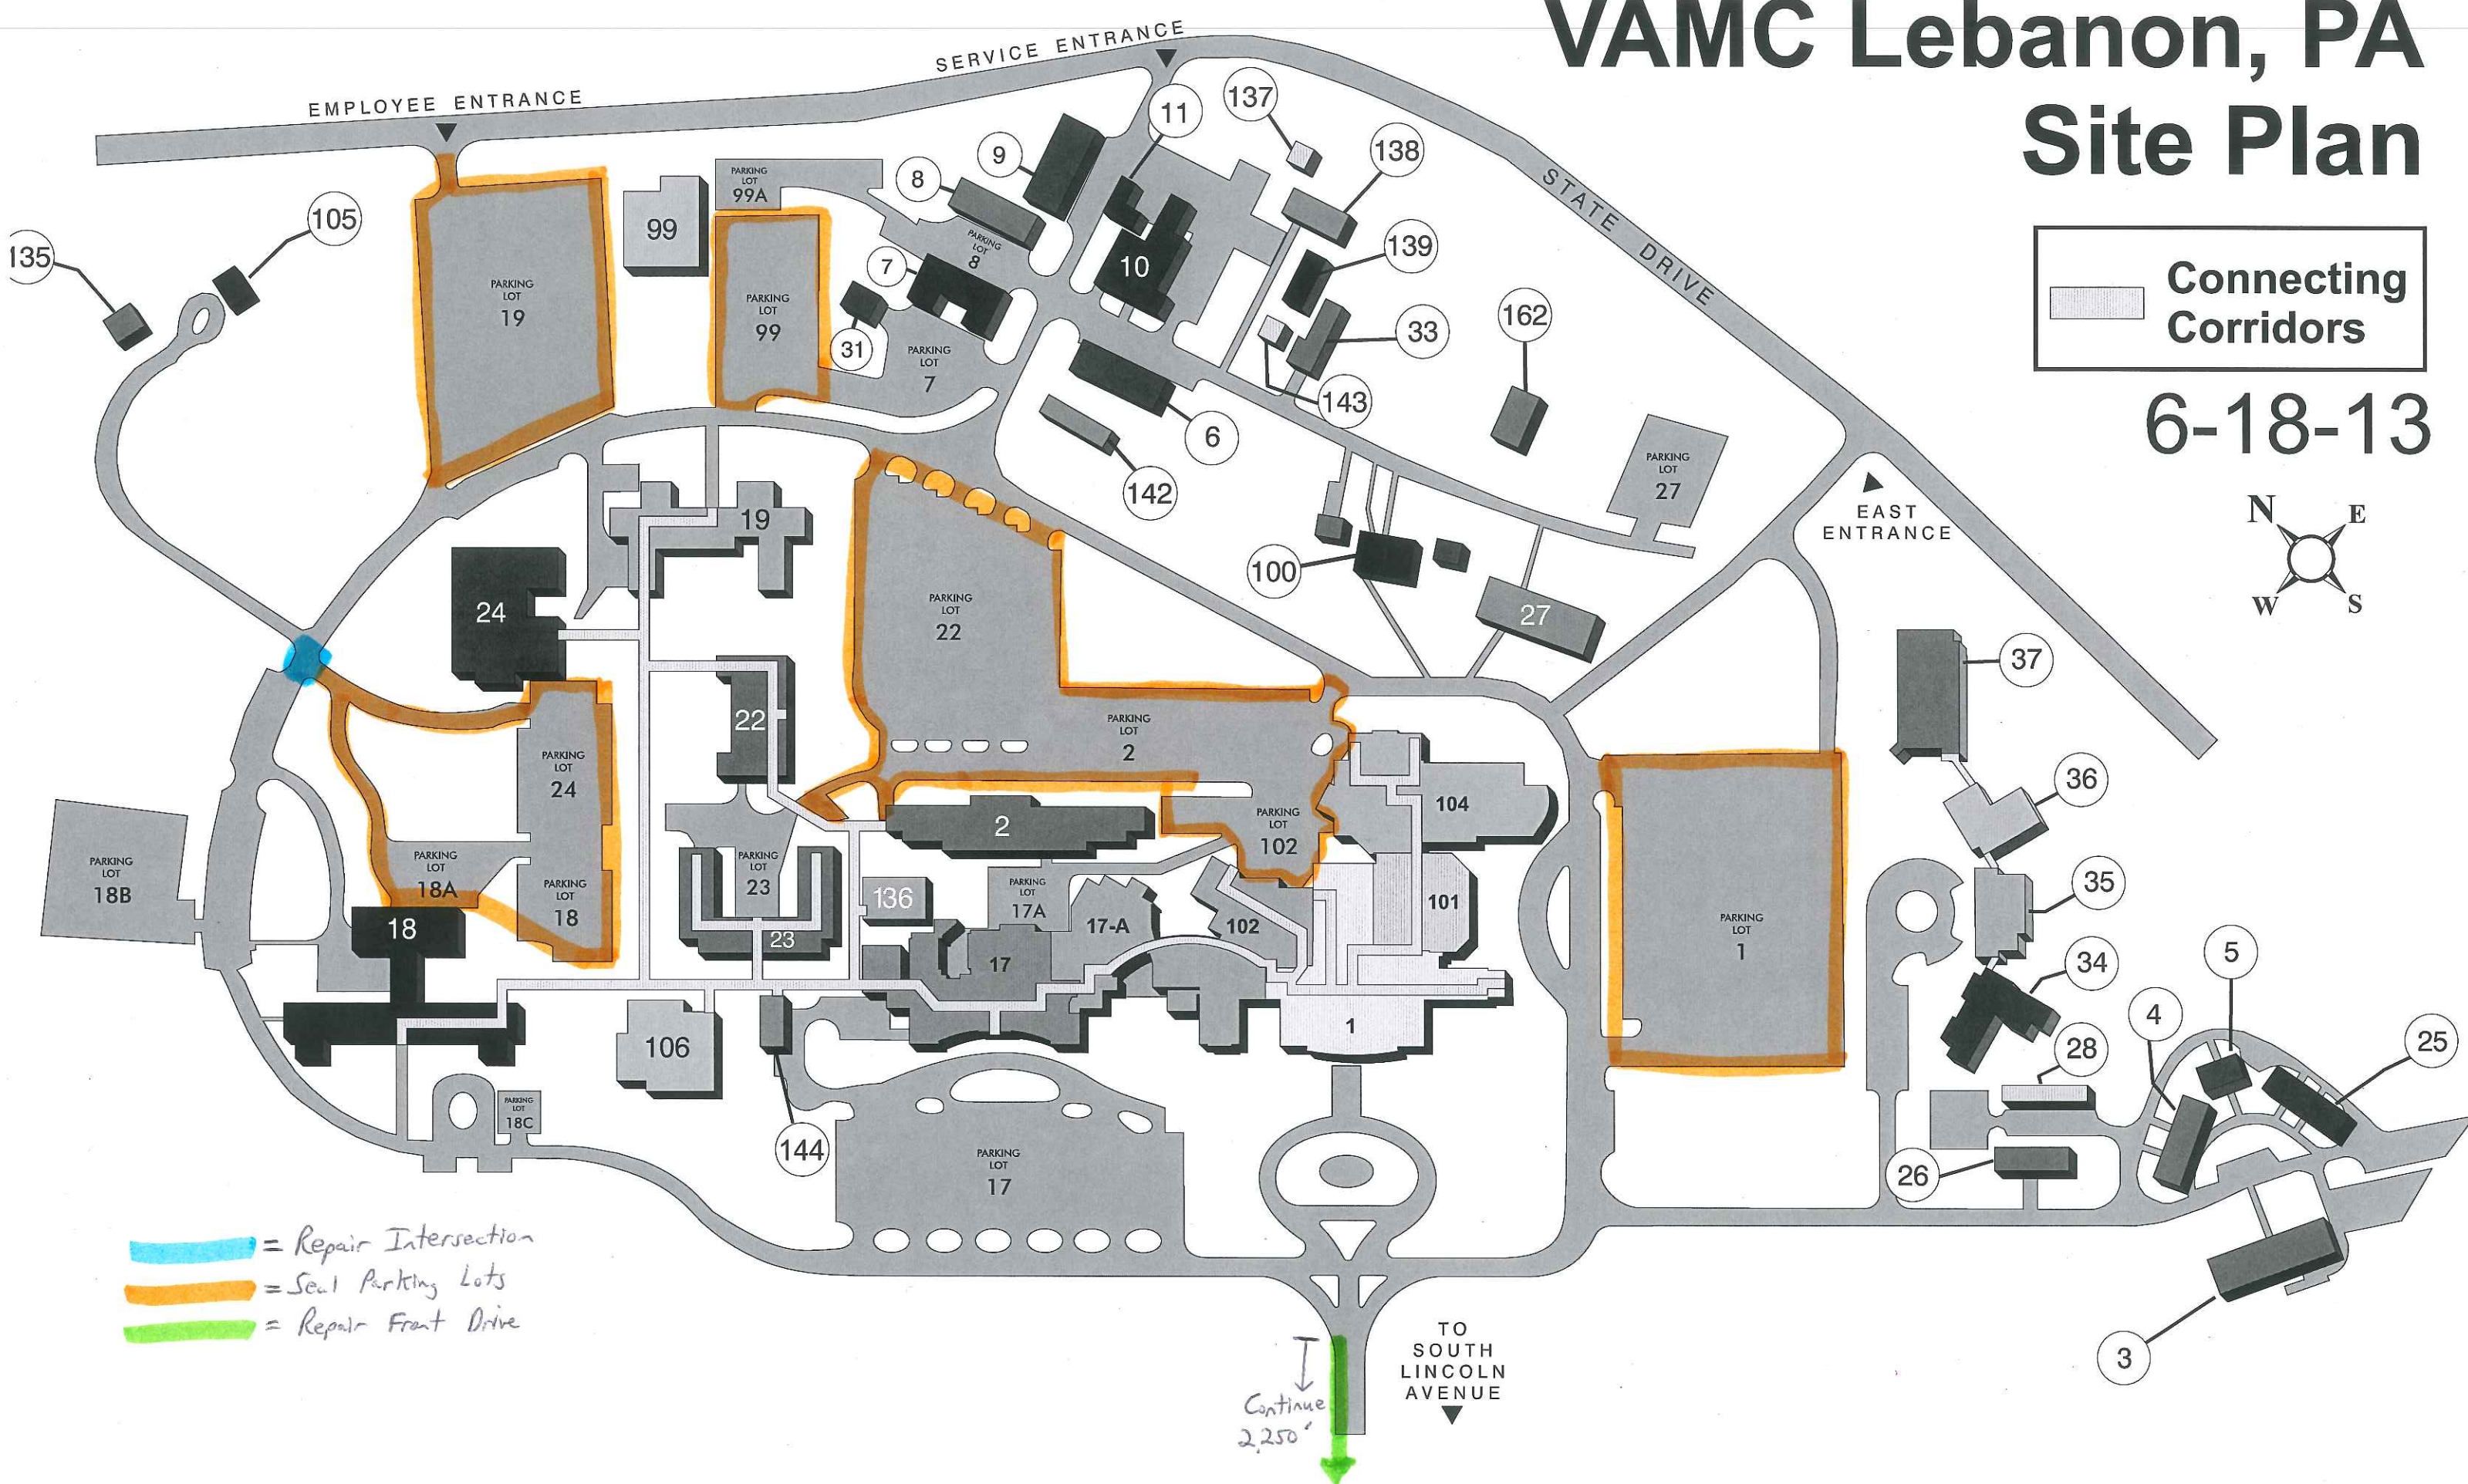


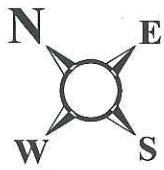


# VAMC Lebanon, PA

## Site Plan

Connecting  
Corridors

6-18-13



 = Repair Intersection  
 = Seal Parking Lots  
 = Repair Front Drive