

1	4C/5th Floor Alteration Plan
---	------------------------------

CONSULTANTS:




**H+K ARCHITECTS**  
ARCHITECTS/ENGINEERS

5485 Reno Corporate Drive, Suite 100  
Reno, Nevada 89511-2262  
P 775-332-6640  
F 775-332-6642  
hkarchitects.com




4C/5th Floor Alteration Plan

Renovation of 4C/5th Floor to Single Patient Rooms		Location 975 Kirman Avenue, Reno NV 89520	
Date August 22, 2013	Checked MMH	Drawn EL	

 Department of Veterans Affairs	Office of Construction and Facilities Management	AE151
		Bldg 12
	654-12-724	

1	4C/5th Floor Alteration Plan
---	------------------------------

Areas highlighted in blue are rooms that require new patient lifts.

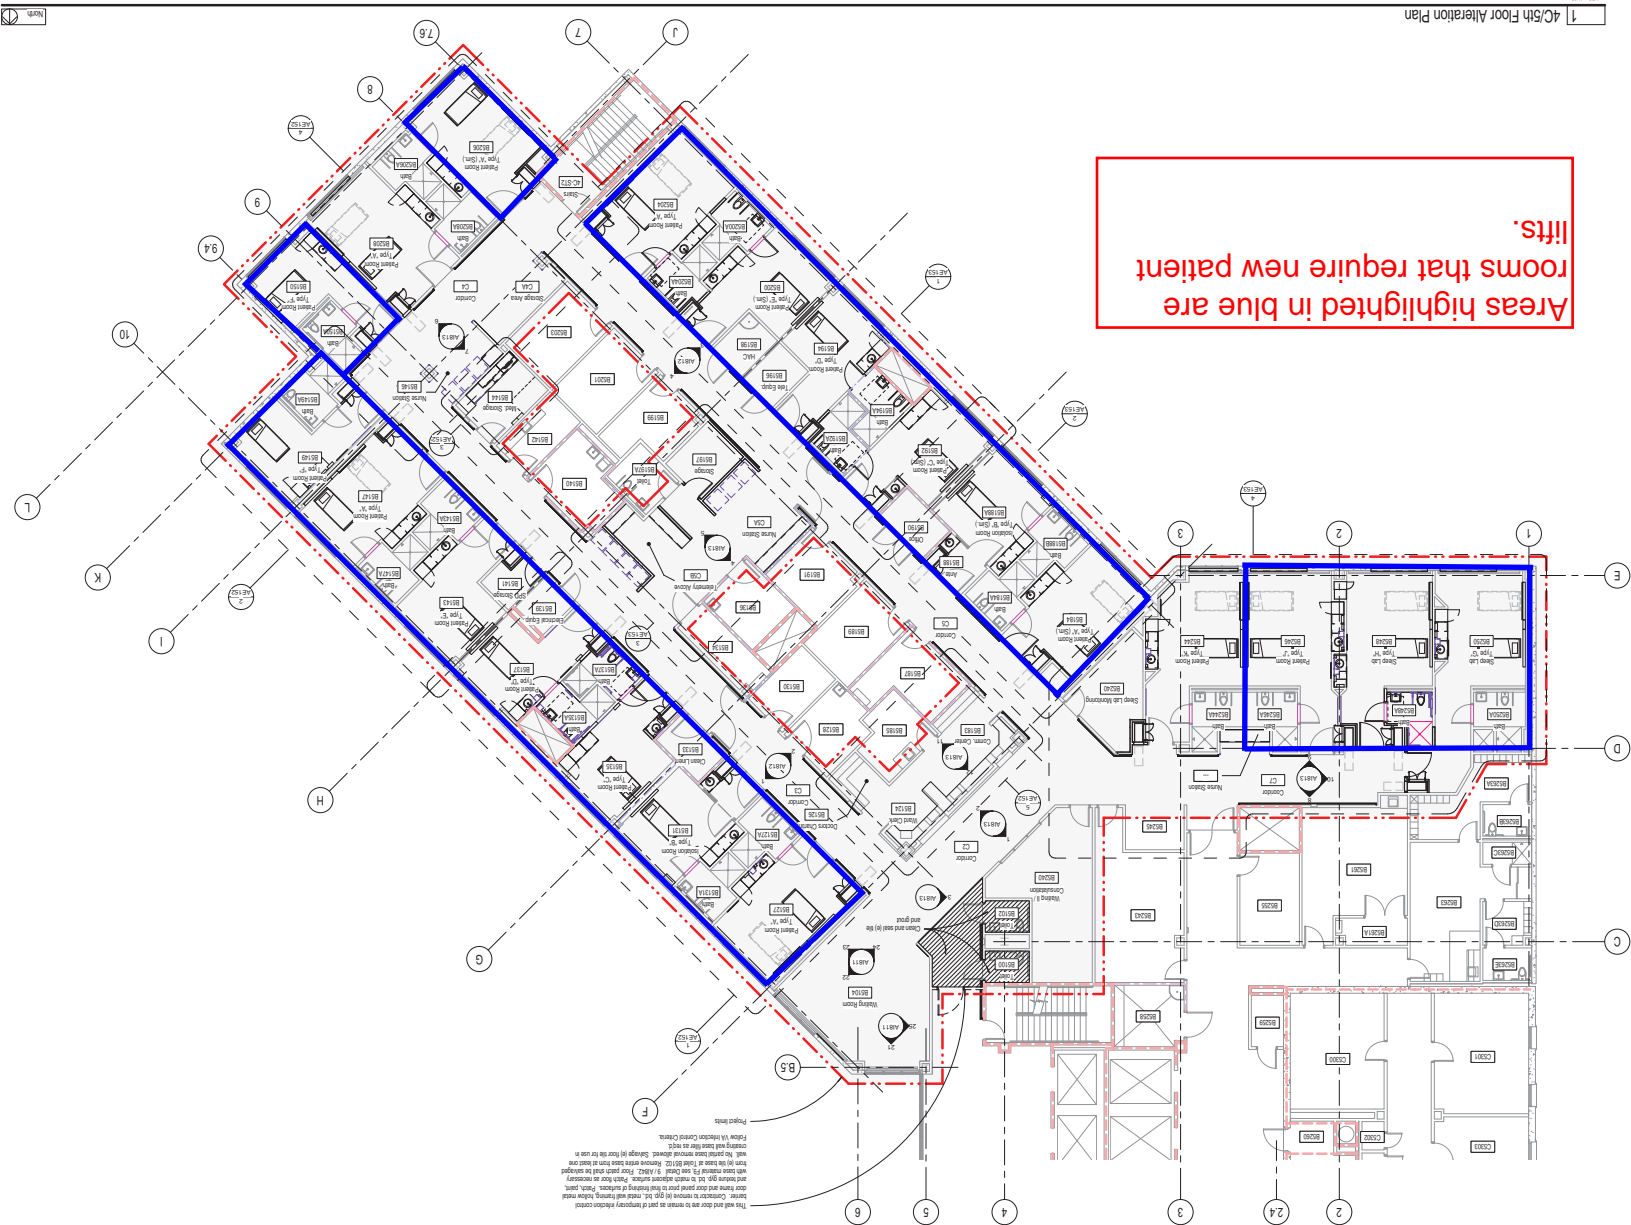

## Keyplan

