
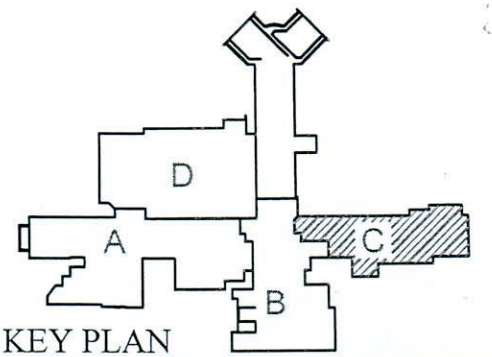
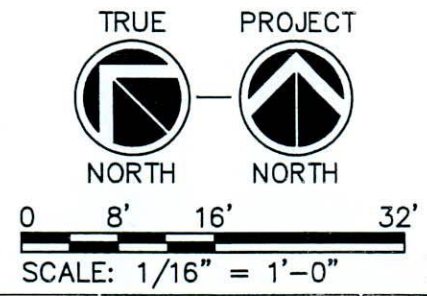


File Name: P:\2010\20100195\Drawings\Bldg 1\3Sheet\95F.01.1c.dwg Last Plotted: 2010/11/01 @ 12:29 PM By: jdd

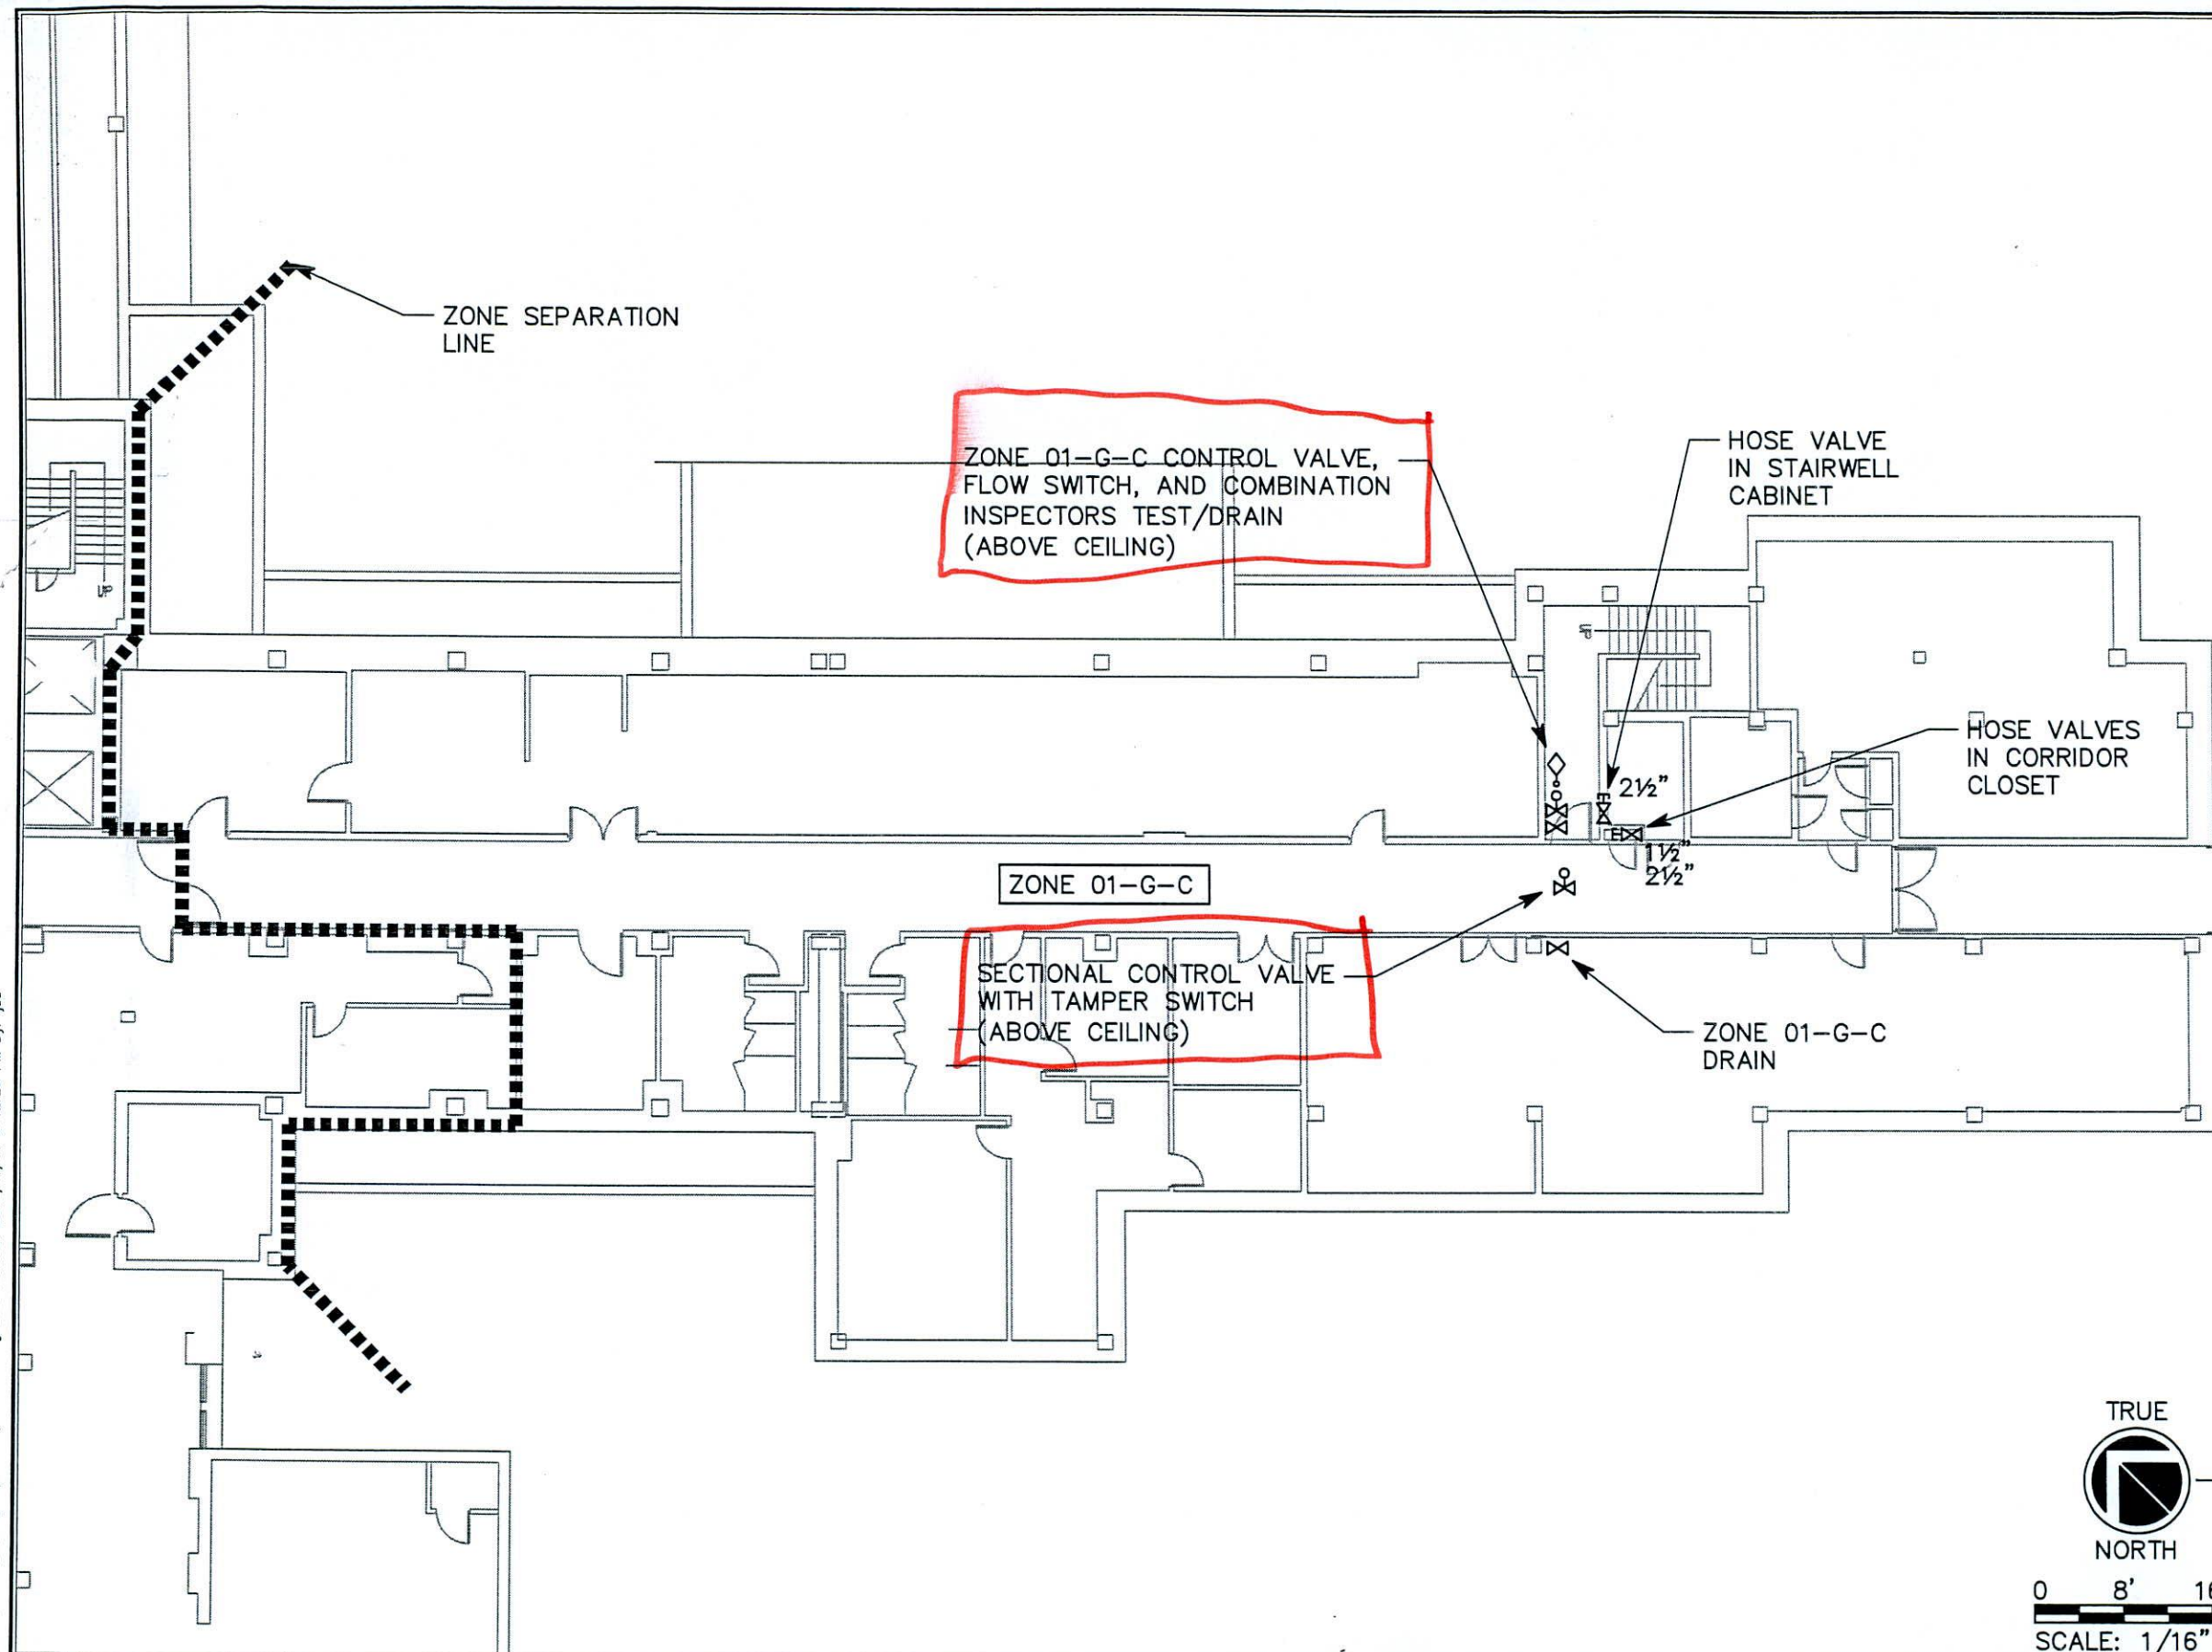

Revisions	
Date	Date

Consultant

SPECTRUM
ENGINEERS
324 South State Street, Suite 400
Salt Lake City, Utah 84111
801.328.5151
800.678.7077
FAX 801.328.5155
www.spectrum-engineers.com

Project Title CAMPUS WIDE FIRE SPRINKLING TEST STATION MODIFICATION AND DEFICIENCIES STUDY	
Consultant Project No. 20100195	
Drawn BXW	Checked JDD

Drawing Title BUILDING 1 GROUND LEVEL ZONE C

Date 08.03.2010
Project No. 660-10-110
Building No. 1

DRAWING No.
F.01.1C
Dep. of
or XX
