

ZONE SEPARATION  
LINE


ZONE 01-1-A CONTROL VALVE,  
FLOW SWITCH, AND COMBINATION  
INSPECTORS TEST/DRAIN  
(ABOVE CEILING)

ZONE 01-1-A

*Deleted 2013*  
HOSE VALVES  
IN CORRIDOR  
CLOSET

HOSE VALVE  
IN STAIRWELL  
CABINET

HOSE VALVES  
IN CORRIDOR  
CLOSET

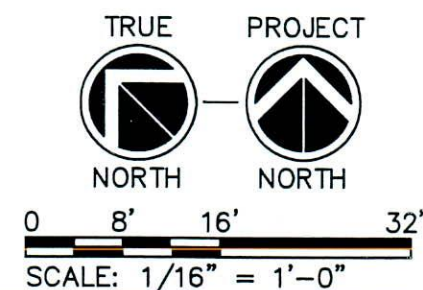

KEY PLAN

Revisions

Date  
Date



324 South State Street, Suite 400  
Salt Lake City, Utah 84111  
801.328.5151  
800.678.7077  
FAX 801.328.5155  
www.spectrum-engineers.com

Project Title  
CAMPUS WIDE FIRE SPRINKLING TEST STATION  
MODIFICATION AND DEFICIENCIES STUDY

Consultant Project No. 20100195

Drawn BXW Checked JDD

Drawing Title  
BUILDING 1  
FIRST LEVEL  
ZONE A

Date  
08.03.2010

Project No.  
660-10-110

Building No.  
1

DRAWING No.  
F.01.2A

Dep. of  
XX

VAMC  
TO QUALITY

AS-BUILT RECORD DRAWINGS

Department of  
Veterans Affairs

File Name: P:\2010\2010-195\Drawings\Bldg 1\3Sheet\95F.01.2a.dwg Last Plotted: 2010/11/01 12:29 PM By: jdd