ZONE 01–1–C CONTROL VALVE, FLOW SWITCH, AND COMBINATION INSPECTORS TEST/DRAIN (ABOVE CEILING)

HOSE VALVE IN STAIRWELL CABINET

ZONE SEPARATION LINE

2½"

1½"
2½"

HOSE VALVES IN CORRIDOR CLOSET

ZONE 01–1–C

ZONE SEPARATION LINE

TRUE NORTH

PROJECT NORTH

0 8' 16' 32'

SCALE: 1/16" = 1'–0"

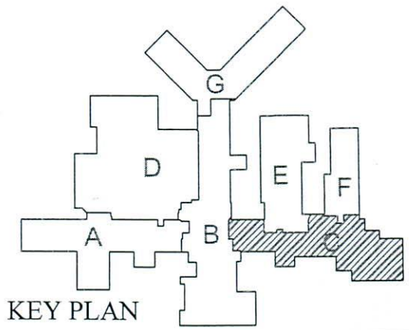


KEY PLAN

AS-BUILT RECORD DRAWINGS

Department of Veterans Affairs

| Revisions | Date |
|---|---|
| | Date |
| | Date |

Consultant
SPECTRUM ENGINEERS


324 South State Street, Suite 400
Salt Lake City, Utah 84111
801.328.5151
800.678.7077
FAX 801.328.5155
www.spectrum-engineers.com


Project Title
CAMPUS WIDE FIRE SPRINKLING TEST STATION MODIFICATION AND DEFICIENCIES STUDY

Consultant Project No. 20100195

Drawn BXW

Checked JDD

Drawing Title
BUILDING 1
FIRST LEVEL
ZONE C

Date 08.03.2010

Project No. 660-10-110

Building No. 1

DRAWING No. F.01.2C
Dwg. of XX

VAMC

File Name: P:\2010\20100195\1Drawings\Bldg 1\3Sheet\95F.01.2c.dwg Last Plotted: 2010/11/01 @ 12:28 PM By: jdd