
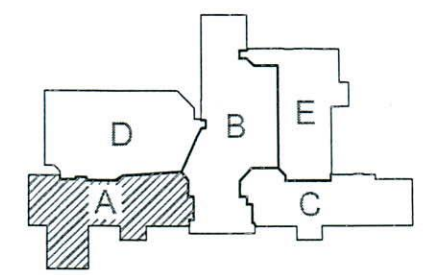
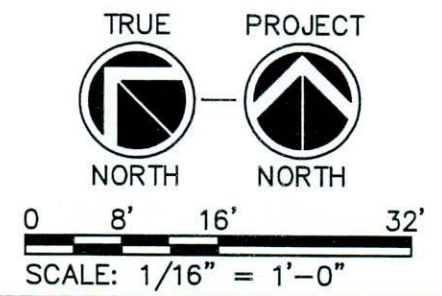


File Name: P:\2010\20100195\1Drawings\Bldg 1\3Sheet\95F.01.3a.dwg Last Plotted: 2010/11/01 12:28 PM By: jdd

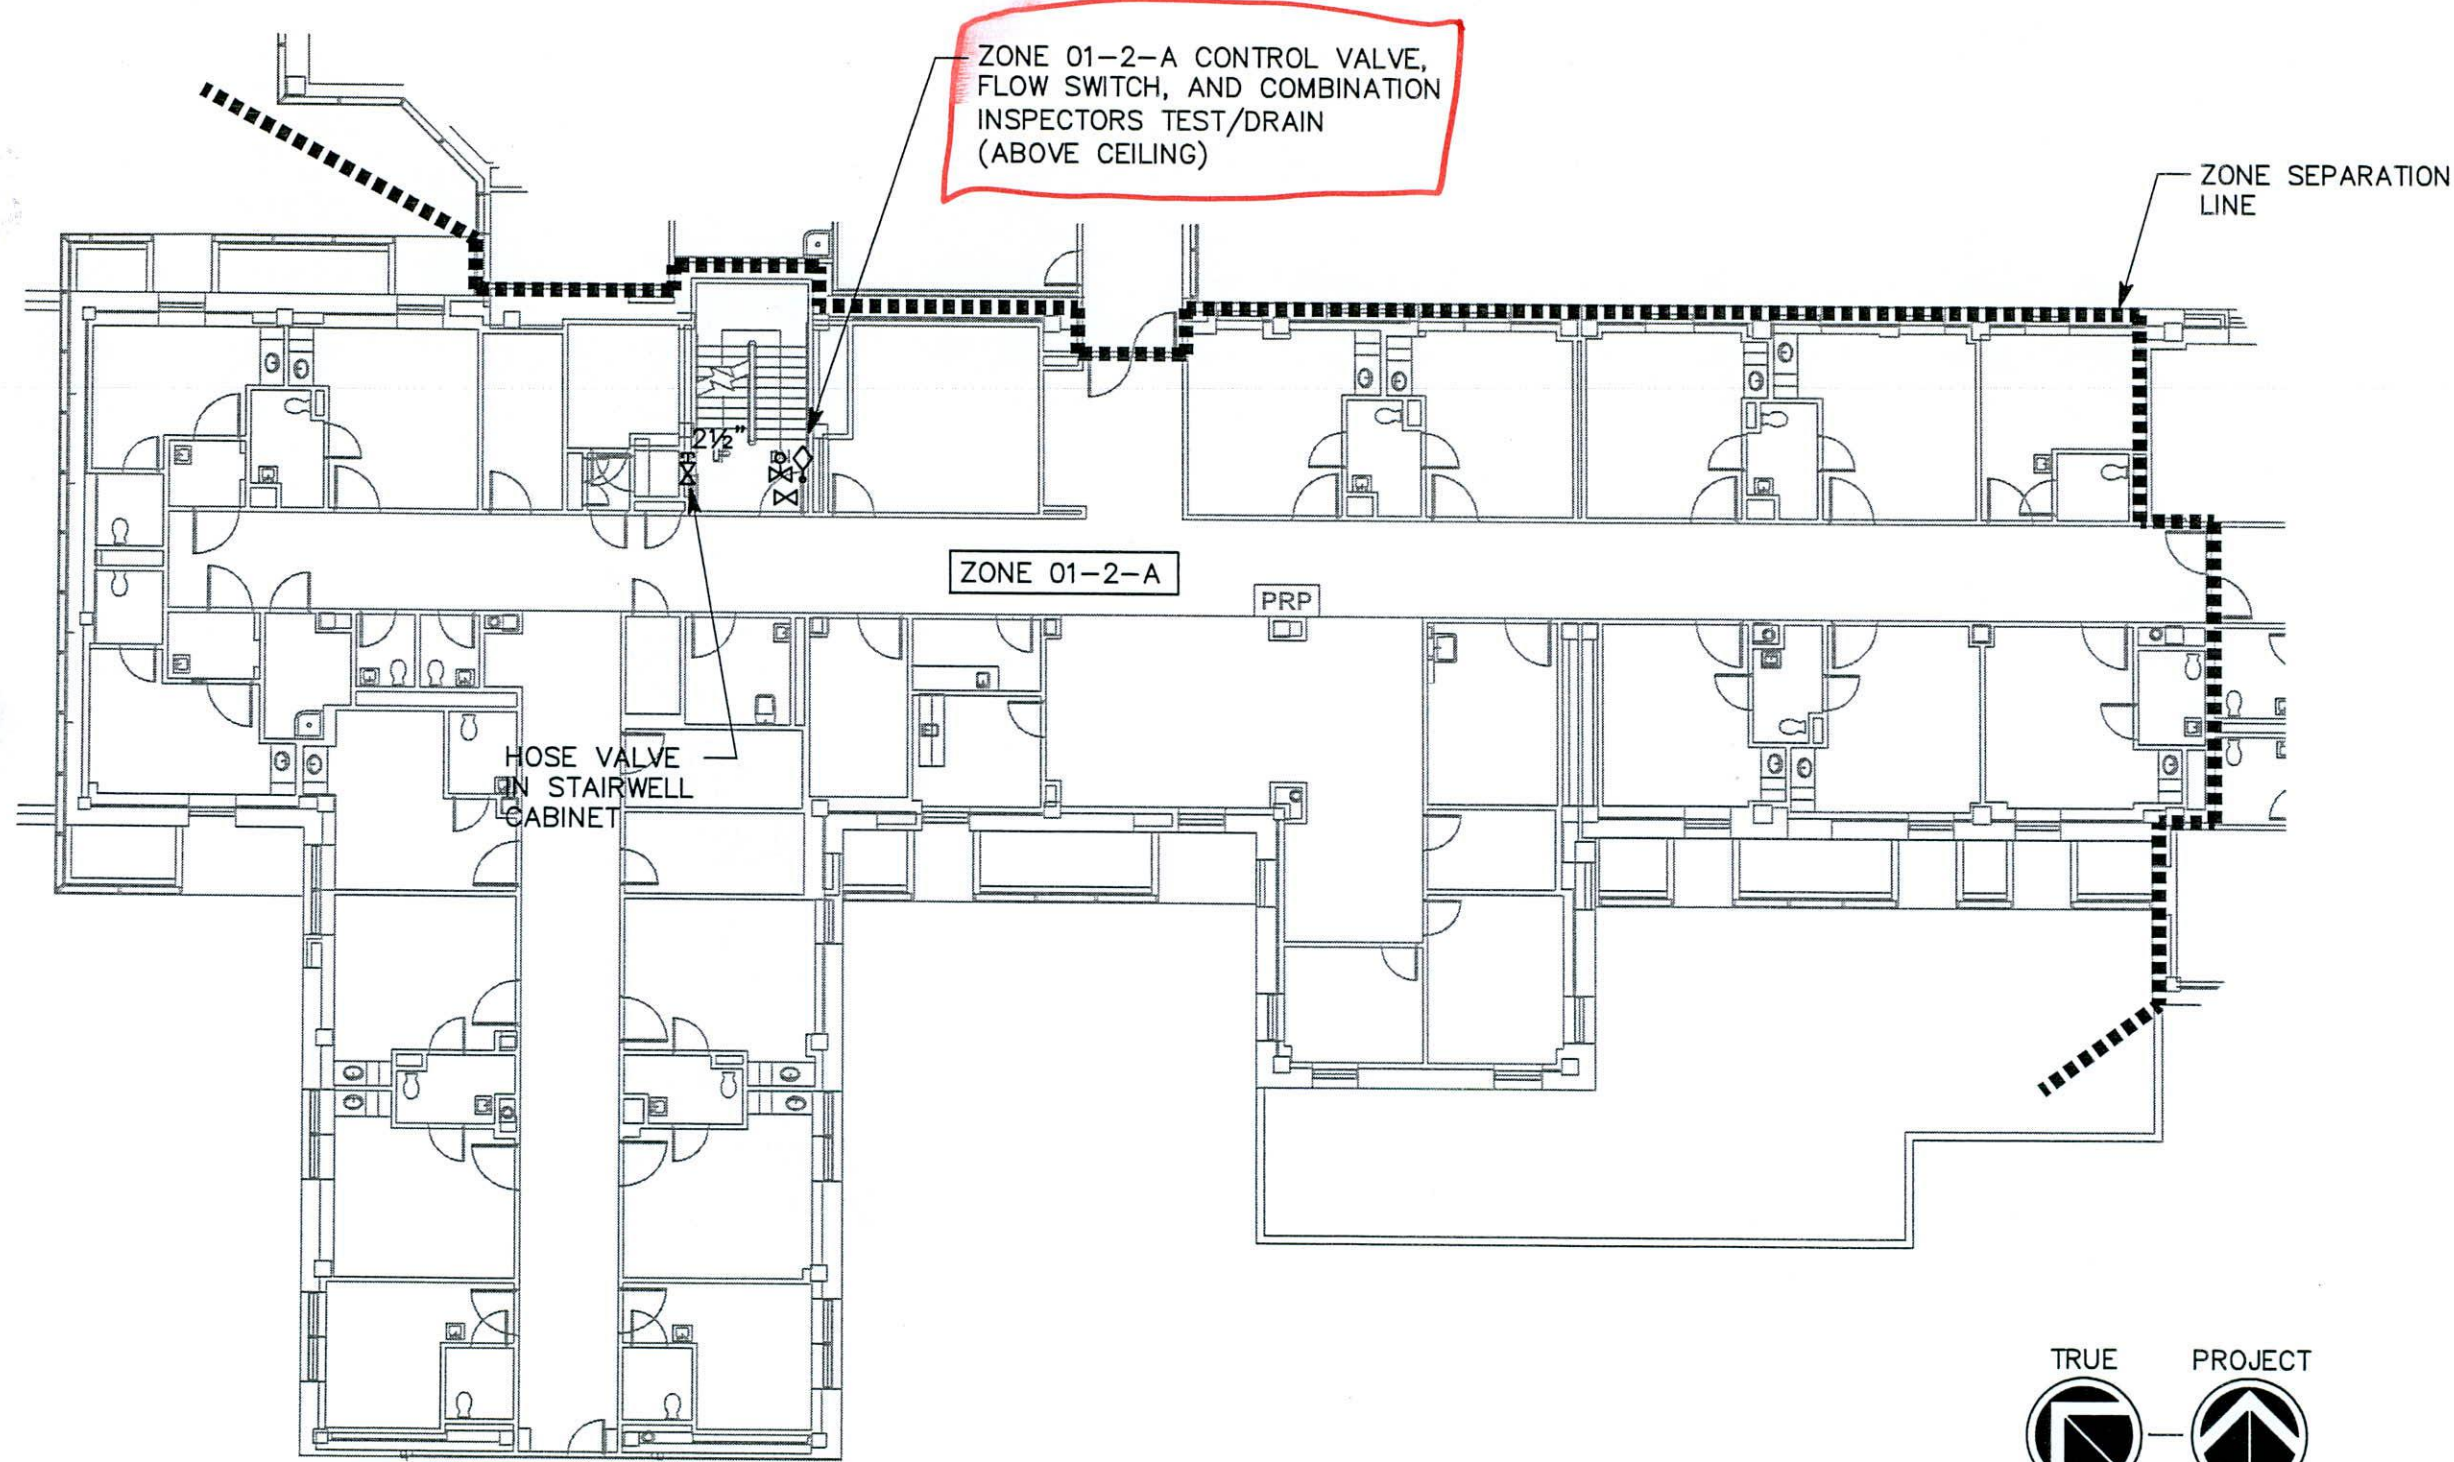

KEY PLAN

Revisions	Date

Consultant  
  
**SPECTRUM**  
ENGINEERS

324 South State Street, Suite 400  
Salt Lake City, Utah 84111  
801.328.5151  
800.678.7077  
FAX 801.328.5155  
www.spectrum-engineers.com

Project Title CAMPUS WIDE FIRE SPRINKLING TEST STATION MODIFICATION AND DEFICIENCIES STUDY	
Consultant Project No. 20100195	
Drawn BXW	Checked JDD

Drawing Title BUILDING 1 SECOND LEVEL ZONE A
---

Date 08.03.2010
Project No. 660-10-110
Building No. 1

DRAWING No.  
**F.01.3A**  
Dep. of XX

  
TO QUALITY