

ZONE SEPARATION
LINE



397 sf

ZONE 01-2-E

ZONE 01-2-E CONTROL VALVE,
FLOW SWITCH, AND COMBINATION
INSPECTORS TEST/DRAIN
(ABOVE CEILING)
*HEADS IN THIS
ZONE WHERE REPLACED
2012*

ZONE SEPARATION
LINE

PRP

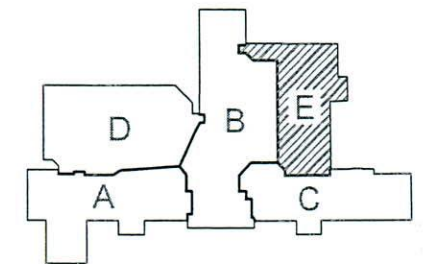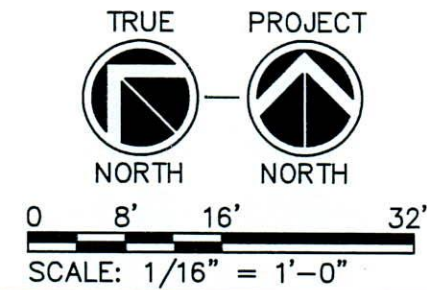

KEY PLAN

Revisions

Date
Date



Consultant
324 South State Street, Suite 400
Salt Lake City, Utah 84111
801.328.5151
800.678.7077
FAX 801.328.5155
www.spectrum-engineers.com

Project Title
CAMPUS WIDE FIRE SPRINKLING TEST STATION
MODIFICATION AND DEFICIENCIES STUDY

Consultant Project No. 20100195

Drawn BXW

Checked JDD

Drawing Title
BUILDING 1
SECOND LEVEL
ZONE E

Date
08.03.2010
Project No.
660-10-110
Building No.
1



AS-BUILT RECORD DRAWINGS

Department of
Veterans Affairs