



File Name: P:\2010\20100195\Drawings\Bldg 2\3Sheet\95F.02.1d.dwg Last Plotted: 2010/11/01 12:25 PM By: jdd

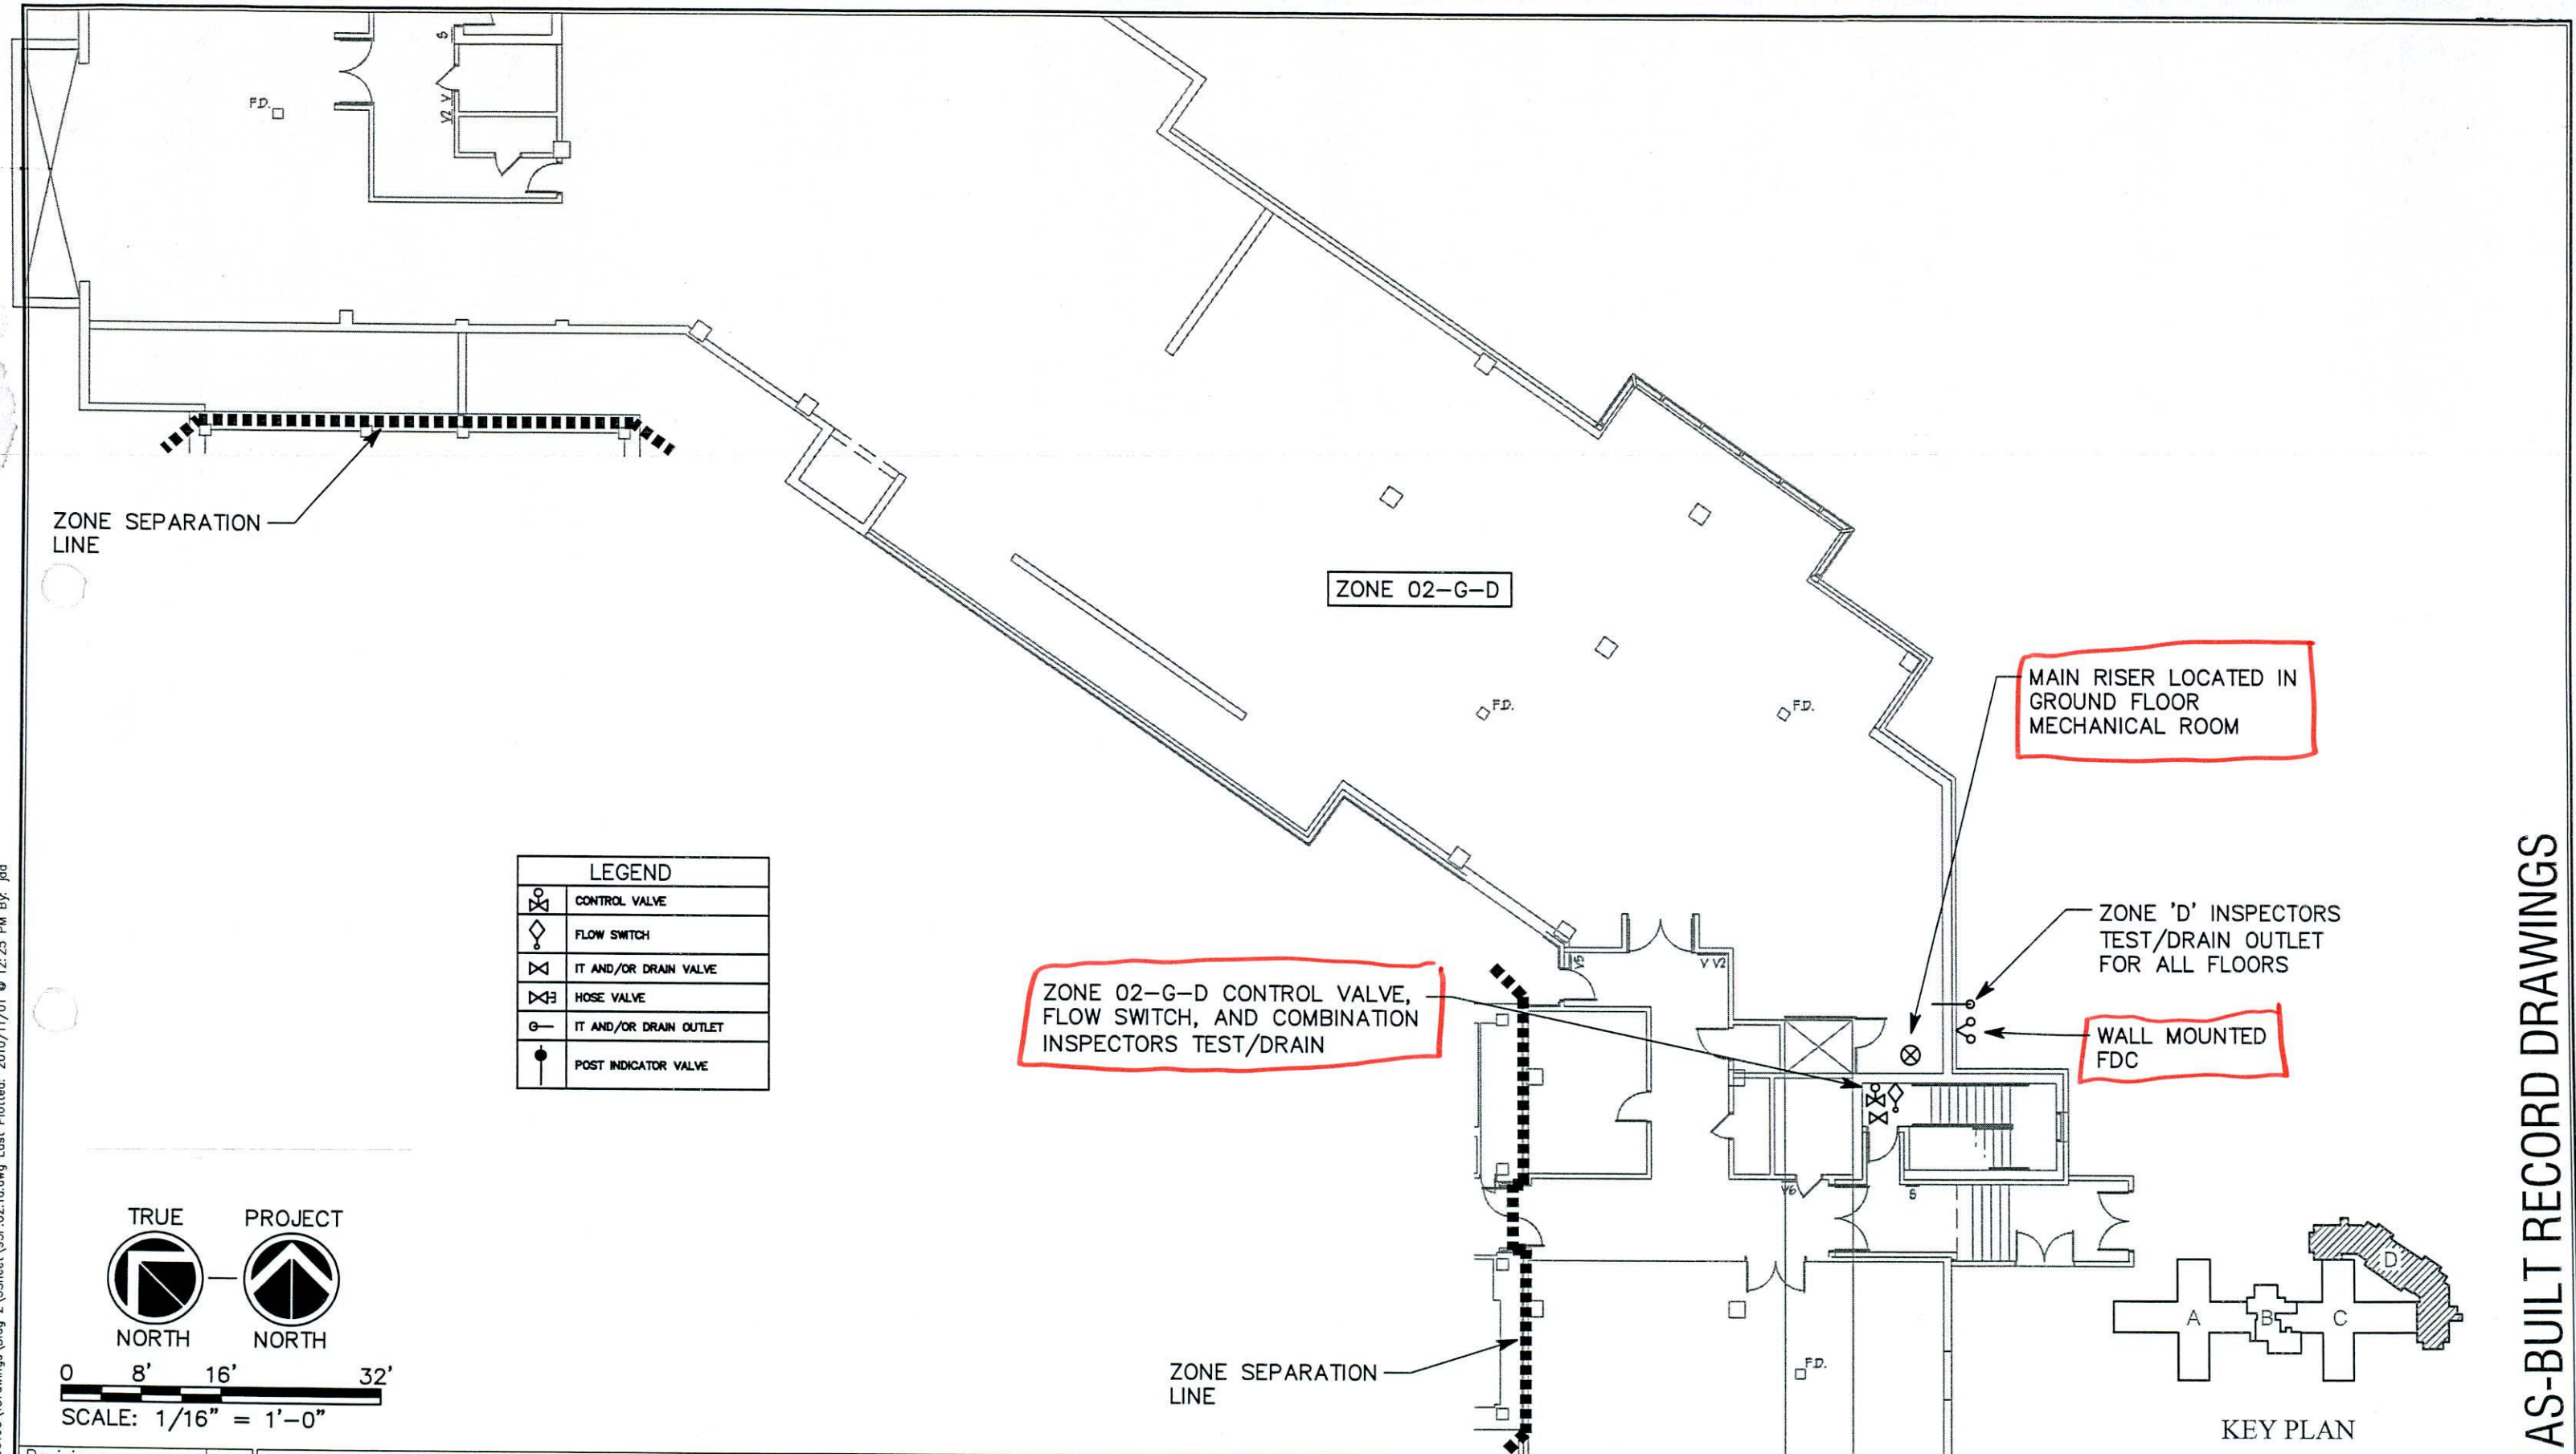

LEGEND	
	CONTROL VALVE
	FLOW SWITCH
	IT AND/OR DRAIN VALVE
	HOSE VALVE
	IT AND/OR DRAIN OUTLET
	POST INDICATOR VALVE

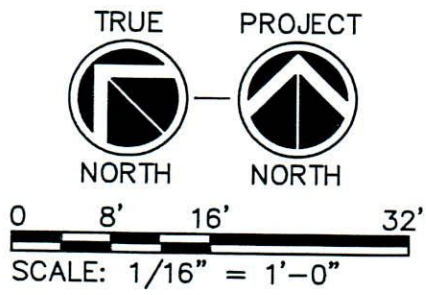

Revisions	Date

Consultant

324 South State Street, Suite 400
Salt Lake City, Utah 84111
801.328.5151
800.678.7077
FAX 801.328.5155
www.spectrum-engineers.com

Project Title CAMPUS WIDE FIRE SPRINKLING TEST STATION MODIFICATION AND DEFICIENCIES STUDY	
Consultant Project No. 20100195	
Drawn BXW	Checked JDD

Drawing Title BUILDING 2 GROUND LEVEL ZONE D	Date 08.03.2010	DRAWING No. F.02.1D Dep. of XX
	Project No. 660-10-110	
	Building No. 2	