

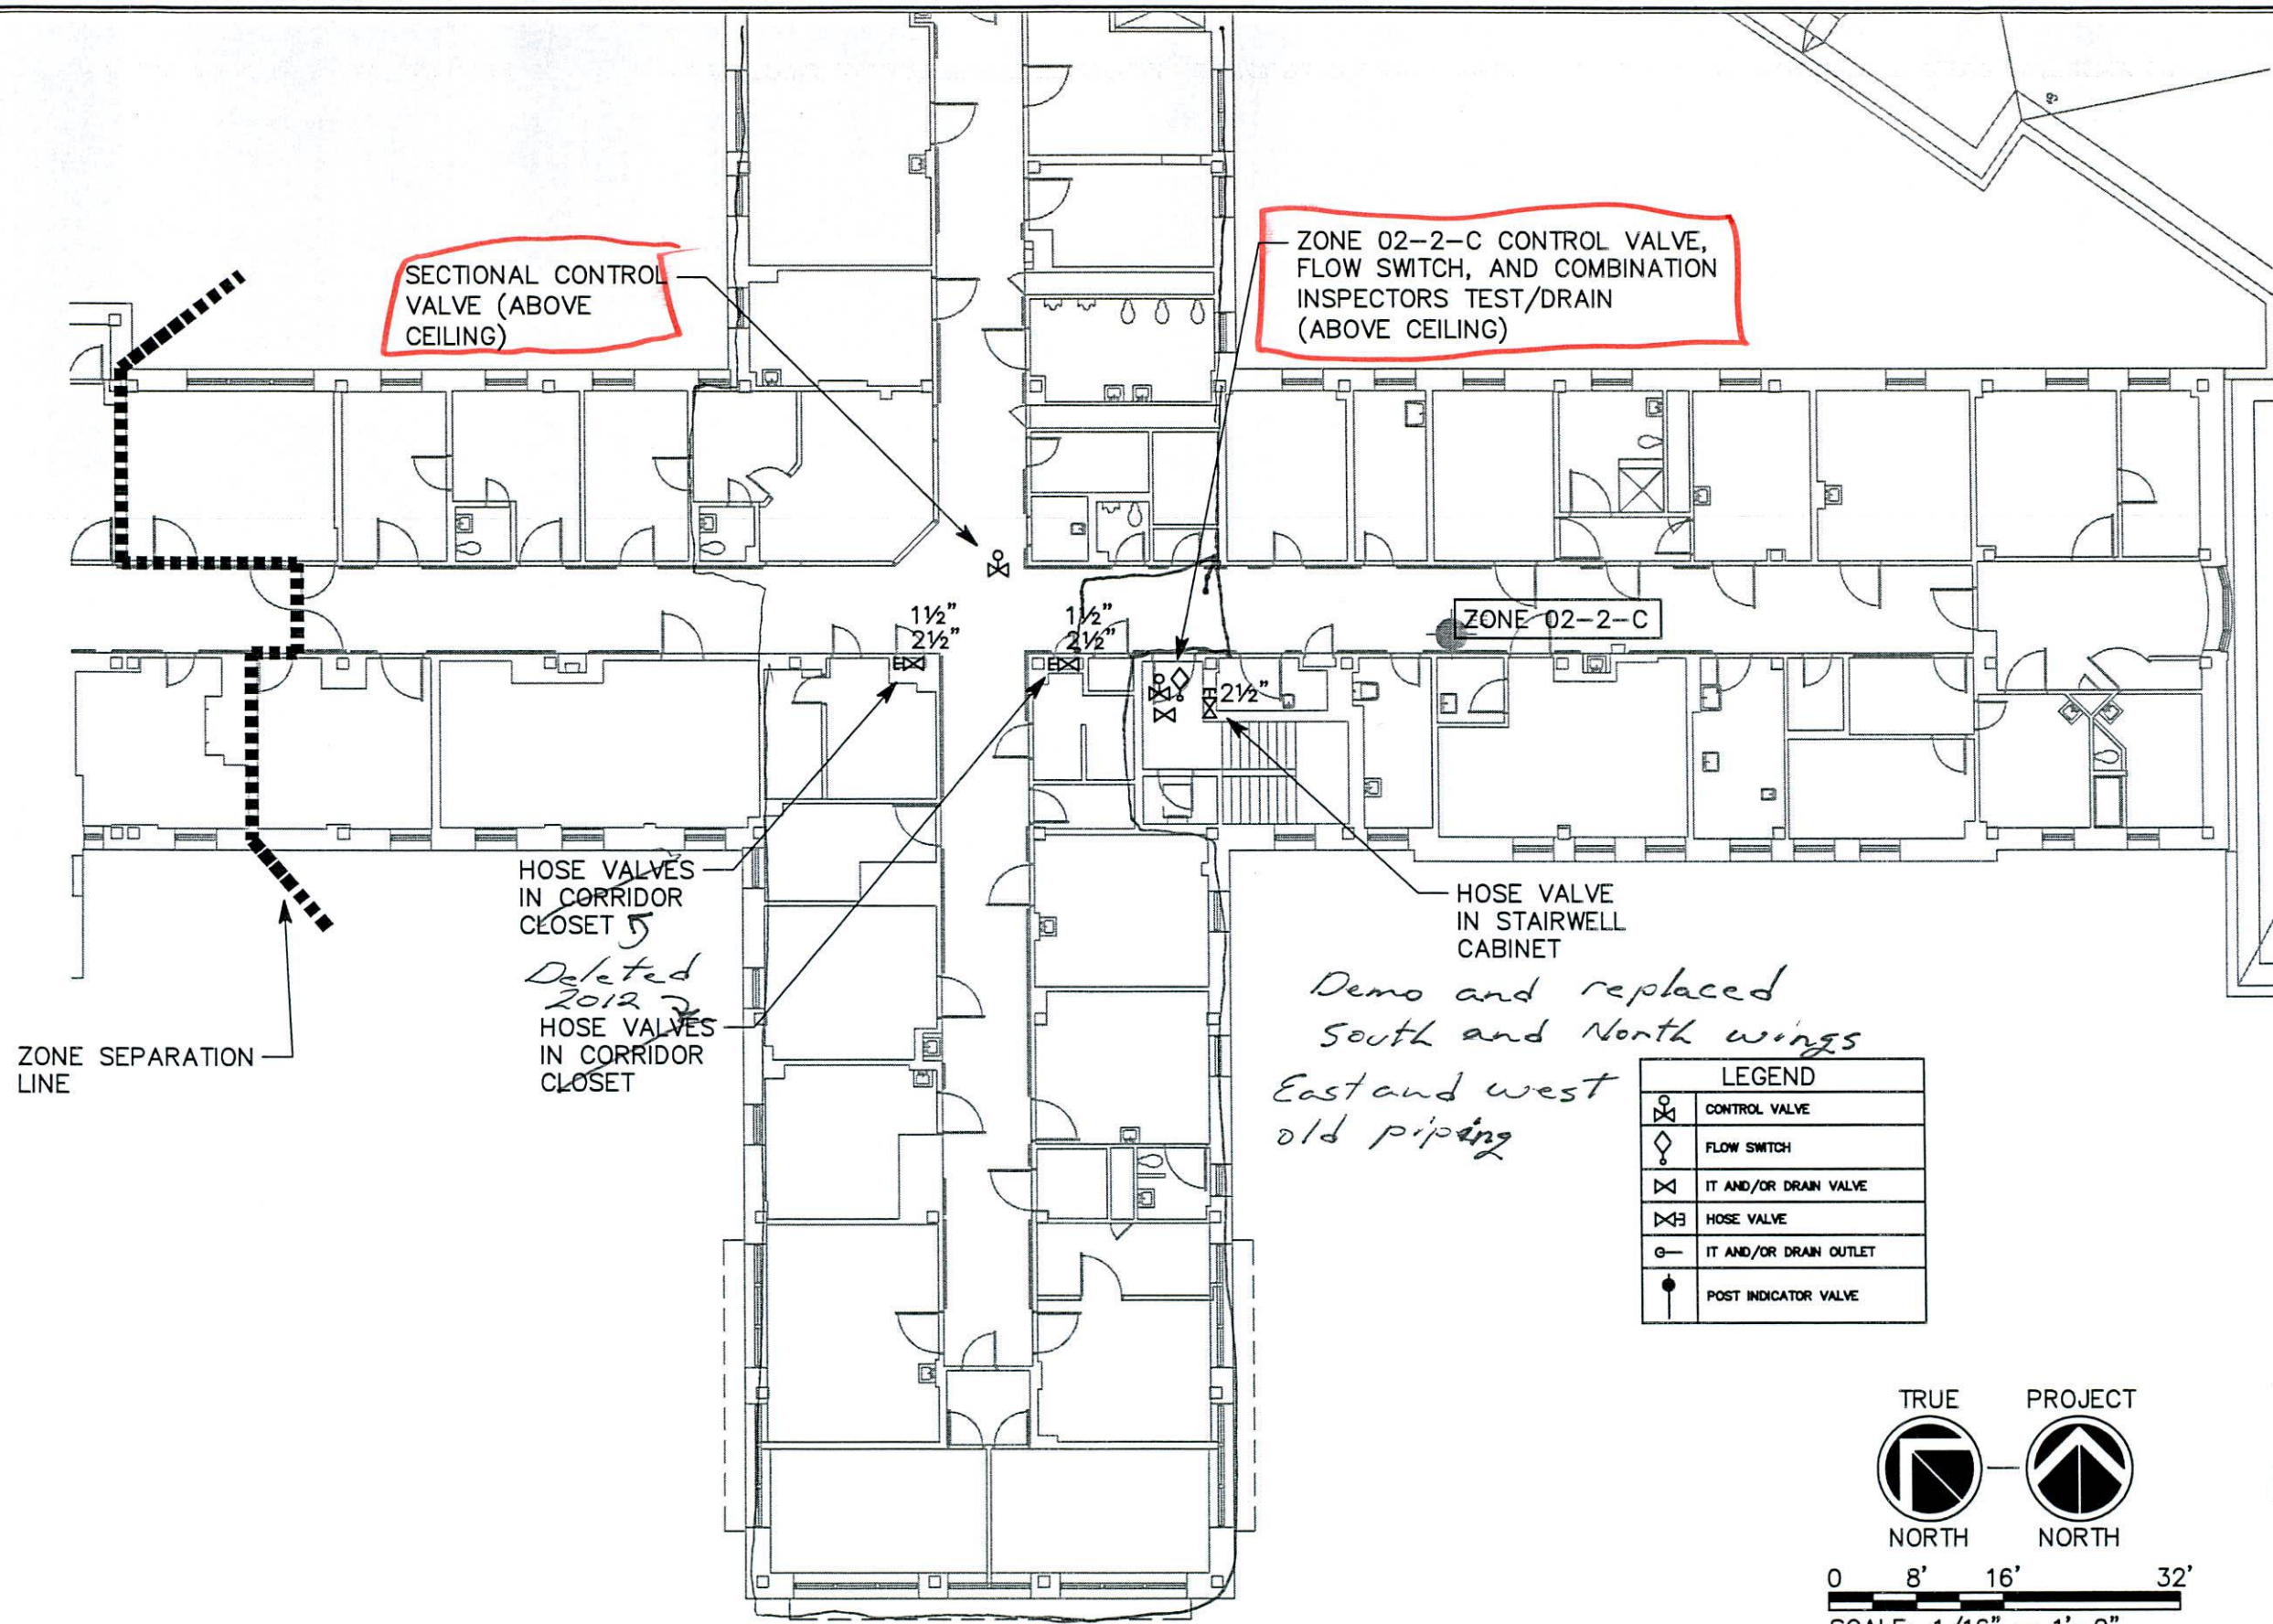


Bldg. 2
1

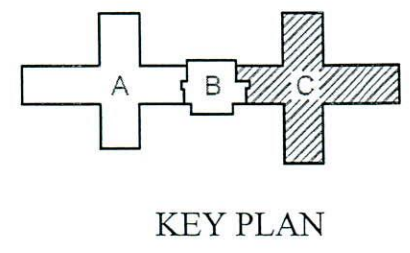

*Demo and replaced
South and North wings
East and west
old piping*

LEGEND	
	CONTROL VALVE
	FLOW SWITCH
	IT AND/OR DRAIN VALVE
	HOSE VALVE
	IT AND/OR DRAIN OUTLET
	POST INDICATOR VALVE

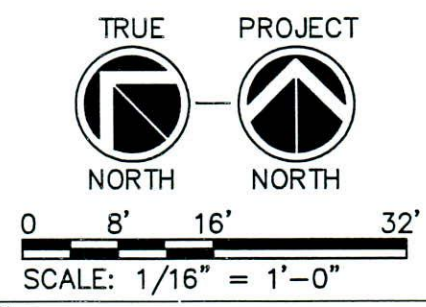

Revisions			Consultant 324 South State Street, Suite 400 Salt Lake City, Utah 84111 801.328.5151 800.678.7077 FAX 801.328.5155 www.spectrum-engineers.com	Project Title CAMPUS WIDE FIRE SPRINKLING TEST STATION MODIFICATION AND DEFICIENCIES STUDY		Drawing Title BUILDING 2 SECOND LEVEL ZONE C		Date 08.03.2010	DRAWING No. F.02.3C Dep. of XX	
Date	Date			Consultant Project No. 20100195	Drawn BXW	Checked JDD	Building No. 2	Project No. 660-10-110		