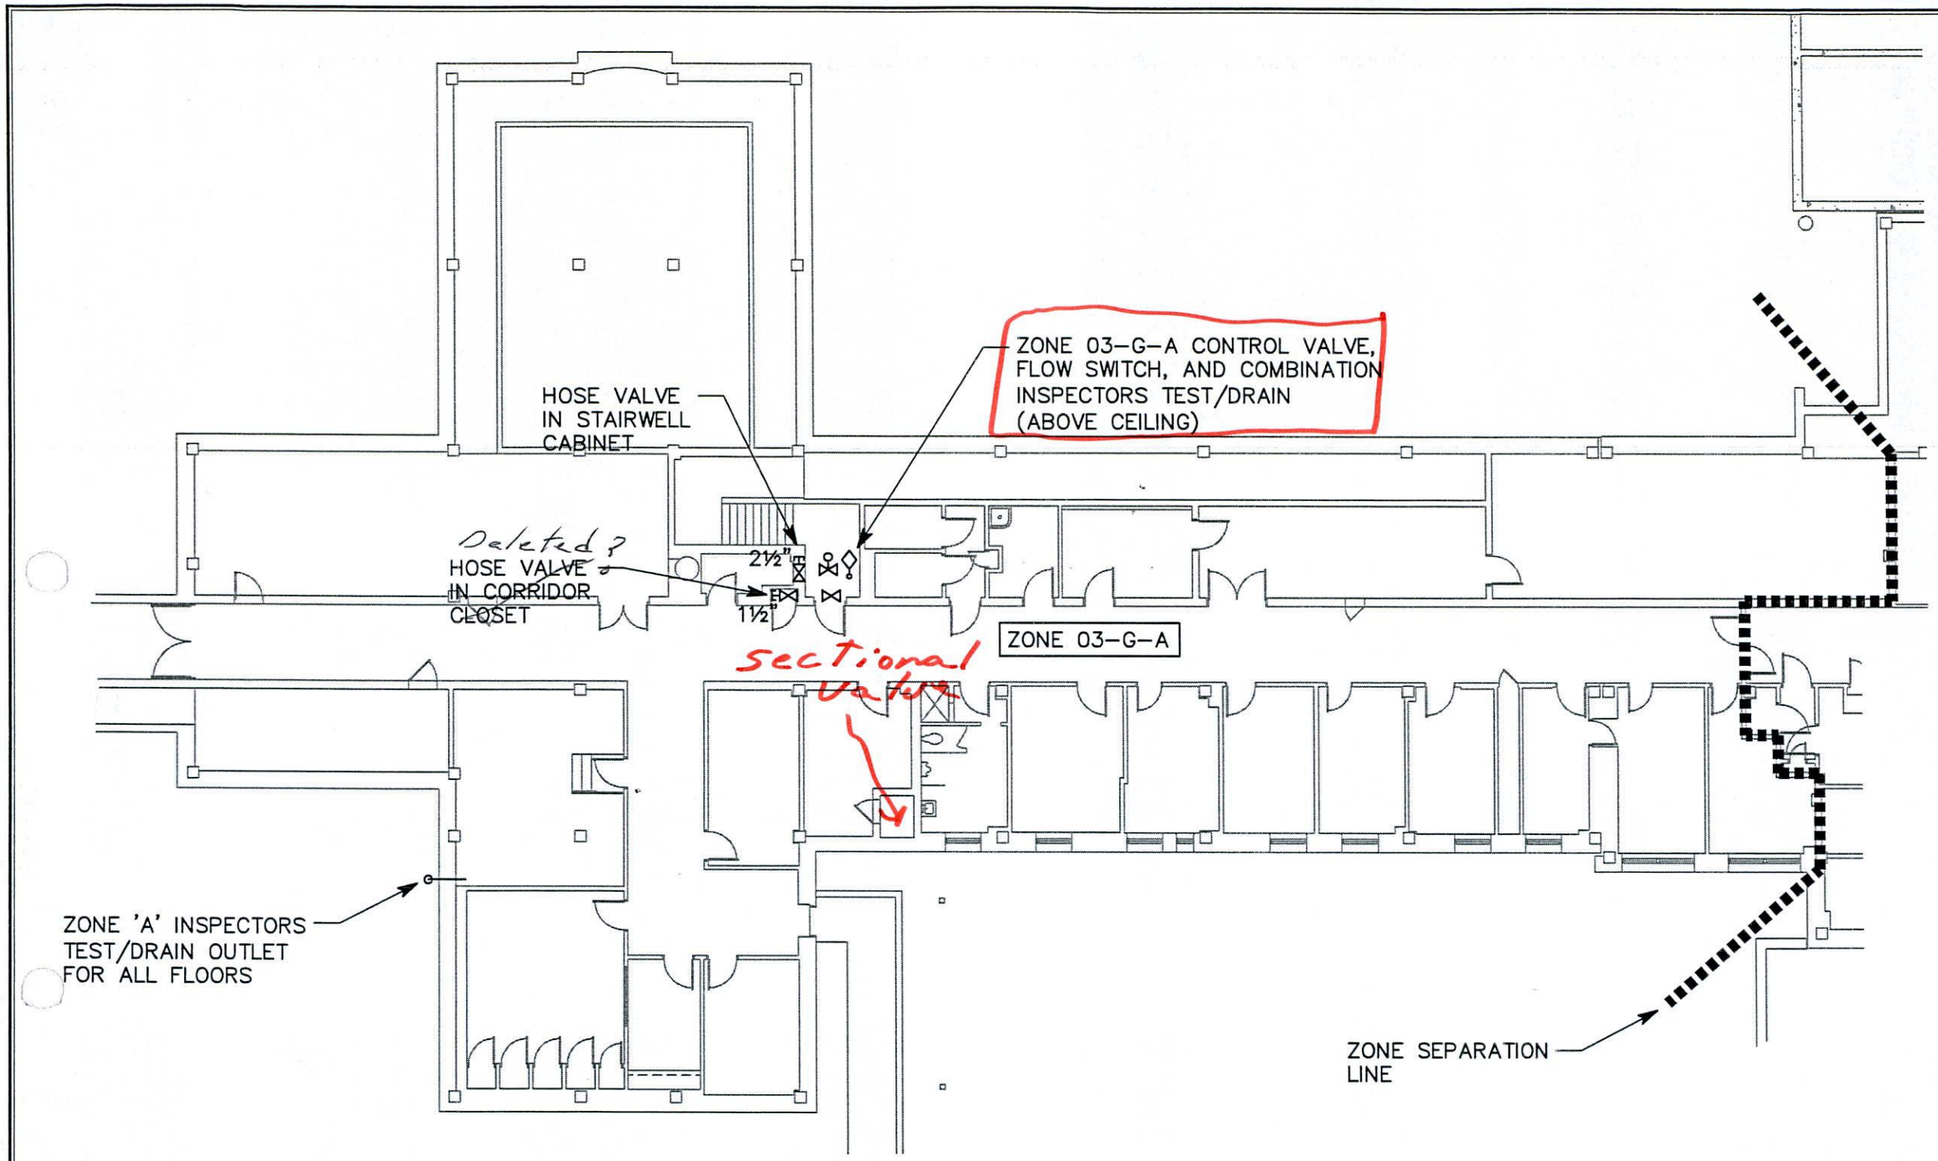

LEGEND	
	CONTROL VALVE
	FLOW SWITCH
	IT AND/OR DRAIN VALVE
	HOSE VALVE
	IT AND/OR DRAIN OUTLET
	POST INDICATOR VALVE

TRUE NORTH — PROJECT NORTH

0 8' 16' 32'

SCALE: 1/16" = 1'-0"

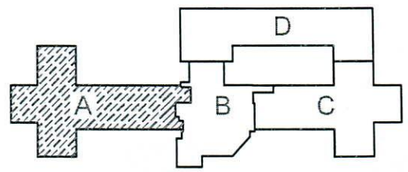

KEY PLAN

AS-BUILT RECORD DRAWINGS

Revisions	Date
	Date

Consultant
SPECTRUM ENGINEERS
324 South State Street, Suite 400
Salt Lake City, Utah 84111
801.328.5151
800.678.7077
FAX 801.328.5155
www.spectrum-engineers.com

Project Title
CAMPUS WIDE FIRE SPRINKLING TEST STATION MODIFICATION AND DEFICIENCIES STUDY

Consultant Project No. 20100195

Drawn BXW | Checked JDD

Drawing Title
BUILDING 3
GROUND LEVEL
ZONE A

Date 08.03.2010

Project No. 660-10-110

Building No. 3

DRAWING No. F.03.1A
Dwg. of XX

Department of Veterans Affairs

File Name: P:\2010\20100195\1Drawings\Bldg 3\3Sheet\95F.03.1a.dwg Last Plotted: 2010/11/01 @ 12:24 PM By: jdd